


GENERAL NOTES:

- ALL CONCRETE SLABS SHALL BE POURED MONOLITHIC WITH CONCRETE BEAMS & GIRDS, AND CONCRETE FIREPROOFING AROUND STEEL BEAM & GIRDS.
- NEW CONCRETE BEAMS ARE TO HAVE 6" BEARINGS ON EXISTING WALLS UNLESS OTHERWISE SHOWN OR NOTED. FIREPROOFING ON STEEL BEAM BEARING ON WALLS IS TO BE STOPPED AT FACE OF WALL.
- ALL STEEL WORK SHALL BE DONE IN ACCORDANCE WITH A.I.A.C. SPECIFICATION FOR DESIGN, FABRICATION, & ERECTION OF STRUCTURAL STEEL FOR BUILDING.
- ALL HOLES FOR CONNECTIONS OF NEW STEEL BEAMS TO PRESENT STEEL BEAMS & COLUMNS ARE TO BE DRILLED IN FIELD. BURNING OF HOLES WILL NOT BE PERMITTED. NEW STEEL BEAM CONNECTIONS TO PRESENT STEEL BEAMS & COLUMNS TO NEW STEEL BEAMS MAY BE FIELD BOLTED. THE SHAPE OF BOLT SHALL BE LONG ENOUGH TO PROVIDE FULL BEARING. WAINERS SHALL BE USED UNDER THE NUTS TO GIVE FULL GRIP WHEN THE NUTS ARE TIGHT.
- WHERE NEW STEEL BEAMS BEAR ON PRESENT MASONRY WALLS, CUT NEW POCKETS IN PRESENT WALLS FOR INSTALLATION OF NEW BEARING PLATE & BEAM.
- USE STANDARD BEARING PLATES FOR STEEL BEAM BEARING ON WALLS UNLESS OTHERWISE SHOWN OR NOTED.
- THE MECHANICAL & ELECTRICAL DRAWINGS FOR LOCATION OF RISERS, & WALLS & LINTELS ARE SHOWN FOR STORY BELOW PLAN UNLESS OTHERWISE SHOWN OR NOTED.
- FOR ALL REINFORCED CONCRETE SLABS & SIDEWALKS ON GROUND USE AT LEAST 4" THICK SLAB REINFORCED WITH 6" O.C. #4 WELDED WIRE MESH UNLESS OTHERWISE SHOWN OR NOTED.


NOTE: BOT. FEA LEVEL ELEV. OF FT&G INDICATED THUS: WALL FT&G. COL. FT&G.

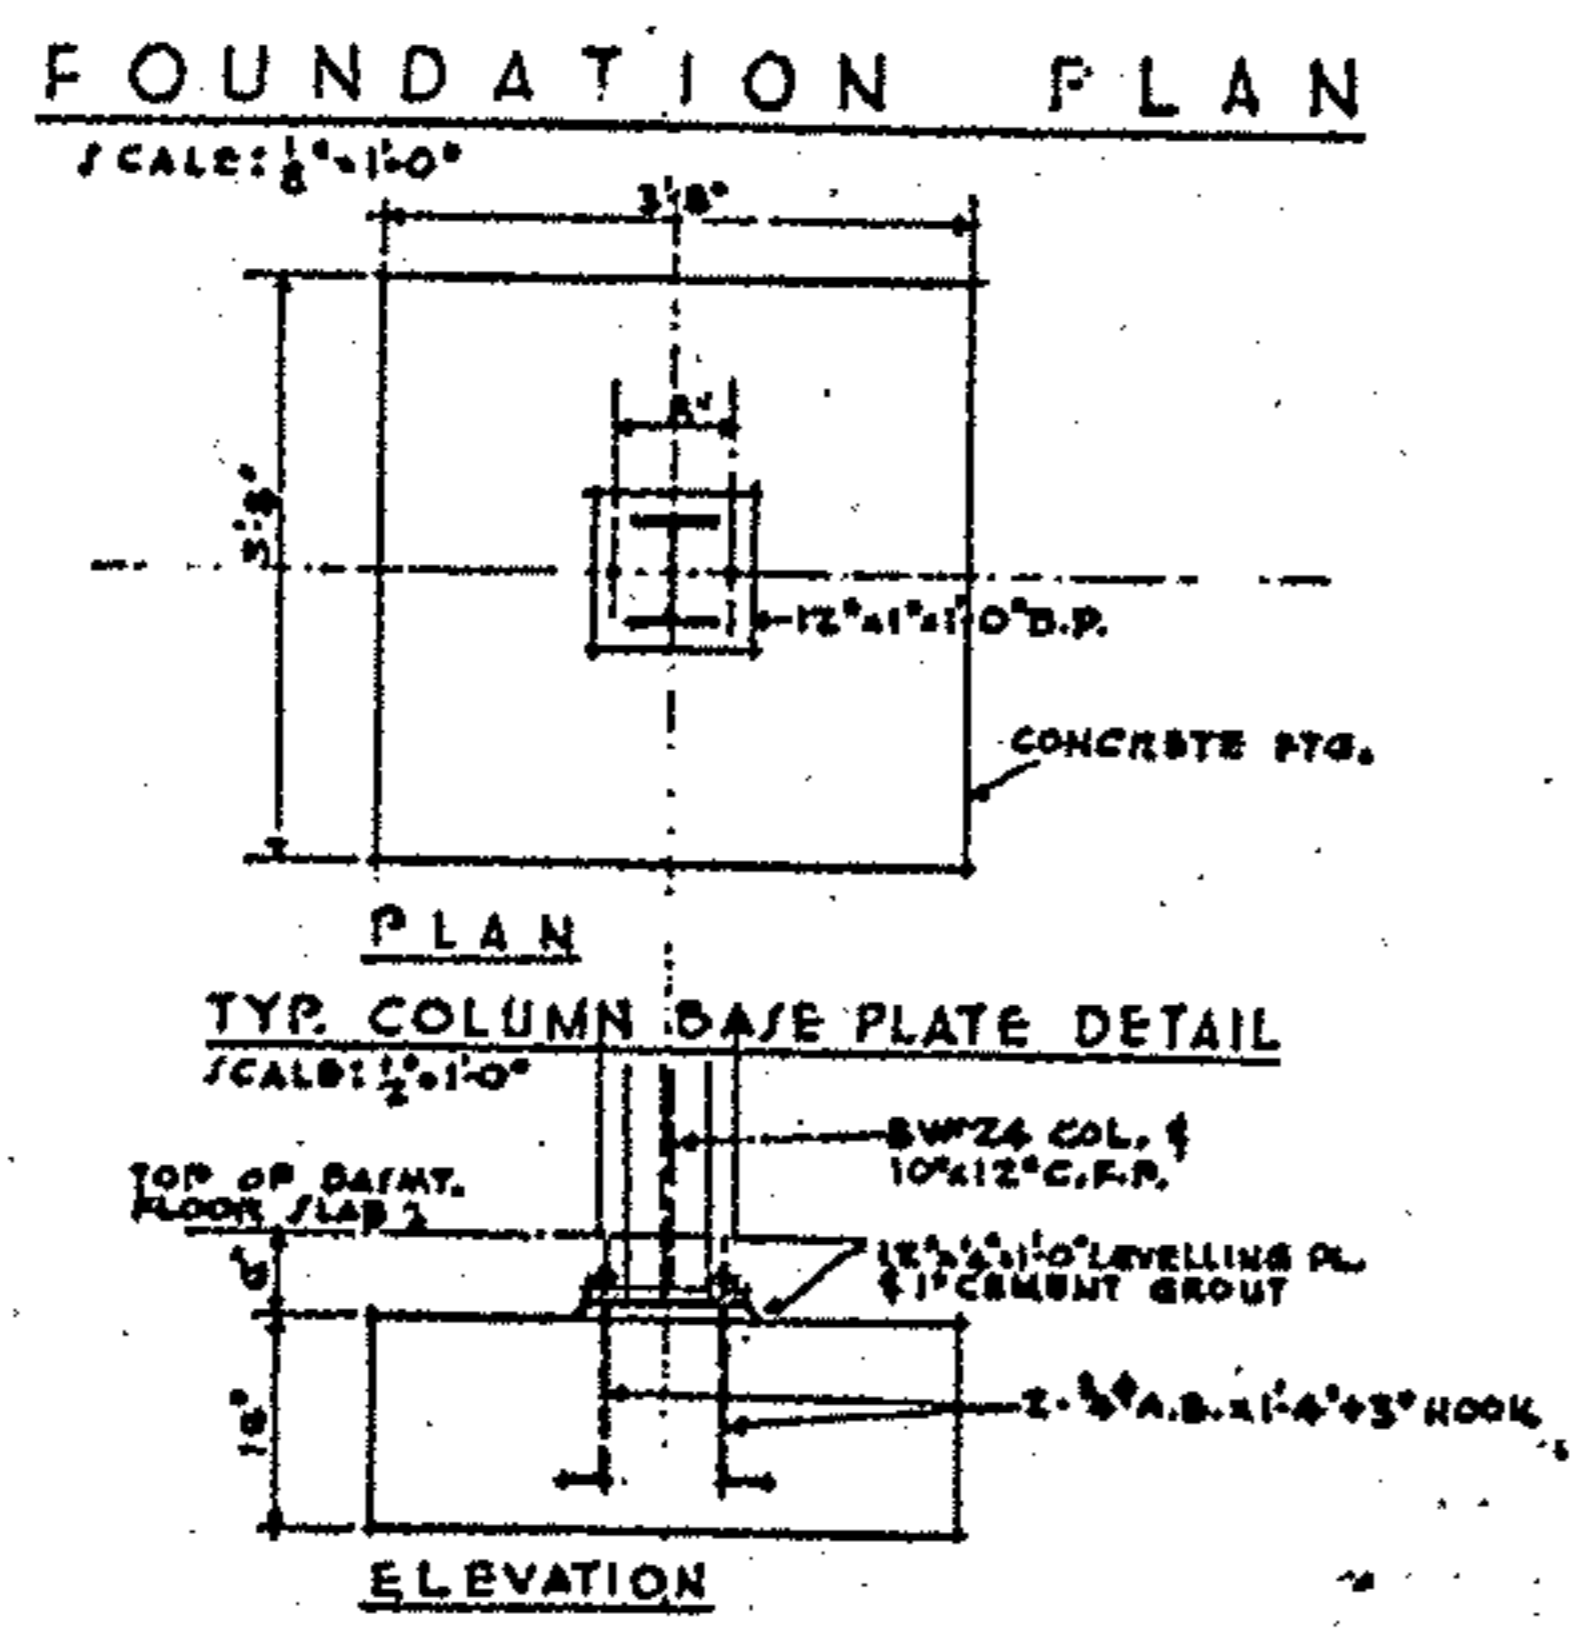

NOTE:
ALL AREAWAY BOTTOMS & RAMP FLOOR ARE 4" SLAB REINF. @ 6" x 6" MESH, EXCEPT WHERE NOTED.

APPROVED
Commonwealth of Pennsylvania
DEPARTMENT OF WELFARE

Architect: *John S. Fine* Date: 3-4-54
Secretary: _____ Date: _____

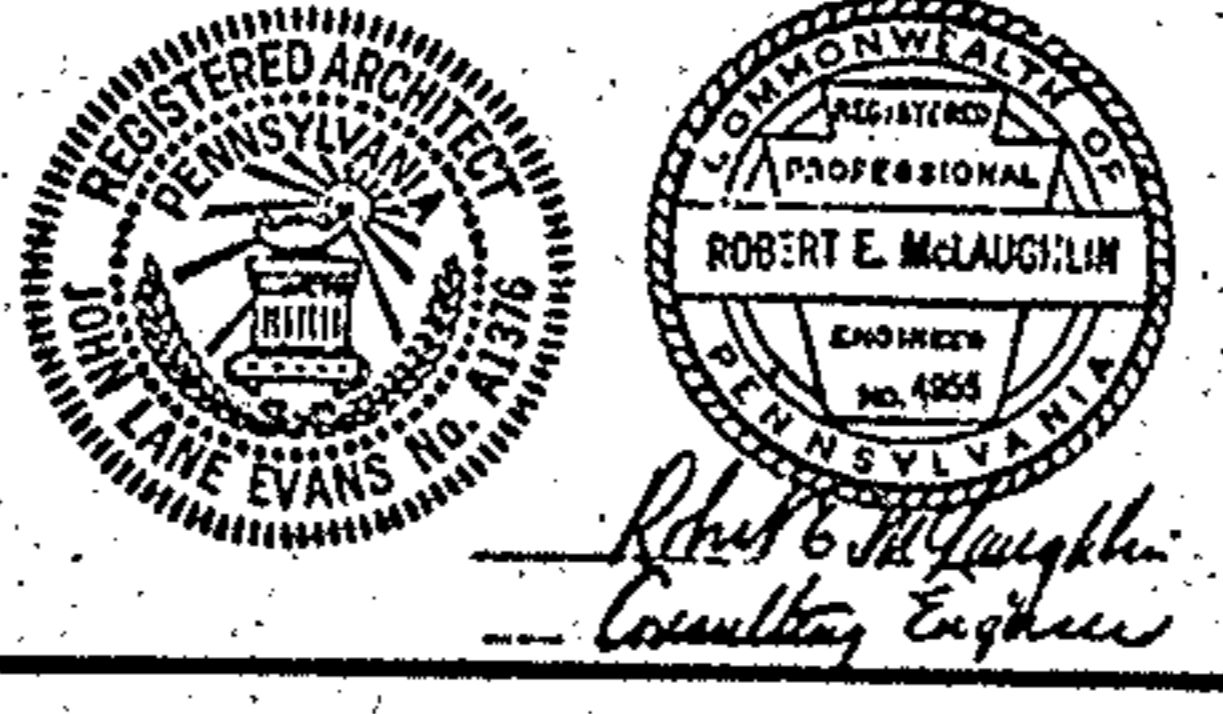

REVISED	THE GENERAL STATE AUTHORITY		PROJECT NO. G. S. A. 510-11	
AS BUILT - 8-1-56	APPROVED	EXECUTIVE DIRECTOR	PHILADELPHIA STATE HOSPITAL PHILADELPHIA, PHILADELPHIA COUNTY, PENNSYLVANIA	
	APPROVED	DIRECTING ENGINEER	REMODEL FEMALE BUILDINGS C1 AND C5	
	SUBMITTED	<i>John S. Fine</i>	FOUNDATION PLAN	
	APPROVED	DEPT. OF WELFARE	JOHN LANE EVANS 12 SOUTH 12TH STREET	REGISTERED ARCHITECT PHILADELPHIA 7, PENNA.
	APPROVED	DEPT. OF PROPERTY & SUPPLIES	DATE: MAR. 1, 1954	THE GENERAL STATE AUTHORITY JOHN S. FINE PRESIDENT
	APPROVED		SCALE: 1/8" = 1'-0"	SHEET NO. S-1
	ACCEPTED	CONTRACTOR	AS NOTED	JOHN N. FORKER - EXECUTIVE DIRECTOR HARRISBURG, PENNSYLVANIA
	ACCEPTED	CONTRACTOR	CHECKED FOR G. S. A.	
	ACCEPTED	CONTRACTOR	SUPV. ARCH. ARCH. STRUC. MECH. ELEC.	
			FUR 7/14	4/15/54