


NOTE:
FRAMING SIMILAR FOR C-1 & C-5,
EXCEPT WHERE NOTED.

STRUCTURAL NOTES FOR CHANGES UNDER CLOTHES ROOM A2-11.
 1. LENGTH OF REINFORCING STEEL SHALL BE DETERMINED AT SITE
 2. SLAB STEEL 3/4" CLEAR OF FORMS
 3. BEAM STEEL 2" CLEAR OF FORMS
 4. USE PROPER CHAIRS AND OTHER ACCESSORIES FOR REINFORCING STEEL IN ACCORDANCE WITH SPECIFICATIONS.

NOTE:
ALL DIMENSIONS AND EXISTING CONDITIONS
SHALL BE CHECKED AND VERIFIED BY THE
CONTRACTOR AT THE SITE.

APPROVED
Commonwealth of Pennsylvania
DEPARTMENT OF WELFARE
Architect: *John N. Forker* 3-4-54
Secretary: _____ Date: _____

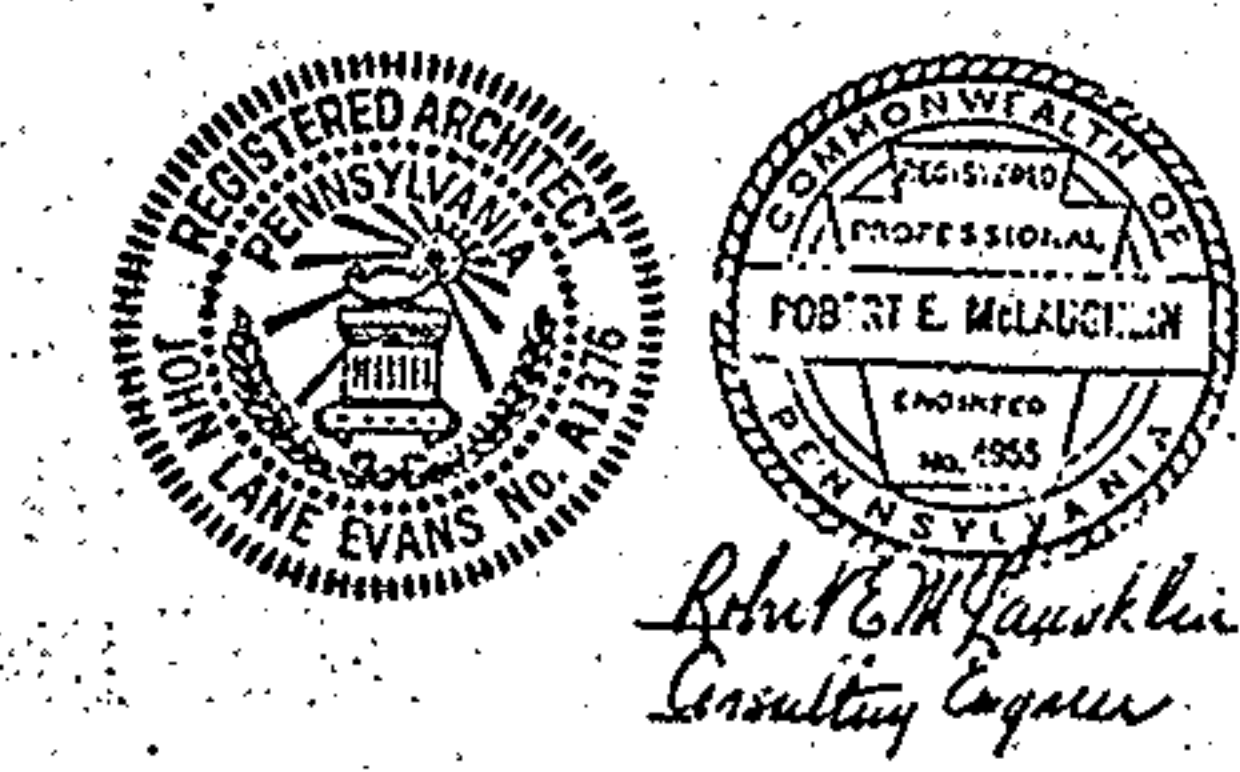

REVISED	THE GENERAL STATE AUTHORITY
1	AS BUILT - CORRECTED 3-1-56
2	AS BUILT - ADDENDUM 5-1-56
3	AS BUILT - EXTRA WORK 5-1-56
	APPROVED EXECUTIVE DIRECTOR
	APPROVED SUPERVISING ENGINEER
	APPROVED ARCHITECT
	APPROVED DEPT. OF WELFARE
	APPROVED DEPT. OF PROPERTY & SUPPLIES
	APPROVED CONTRACTOR
	ACCEPTED CONTRACTOR
	ACCEPTED CONTRACTOR

PROJECT No. G.S.A. 510-11		
PHILADELPHIA STATE HOSPITAL PHILADELPHIA, PHILADELPHIA COUNTY, PENNSYLVANIA		
REMODEL FEMALE BUILDINGS C1 AND C5 SECOND FLOOR & LOFT FRAMING PLAN		
JOHN LANE EVANS 12 SOUTH 18TH STREET	REGISTERED ARCHITECT PHILADELPHIA 7, PENNA.	
DATE MAR. 1, 1954	THE GENERAL STATE AUTHORITY	SHEET No.
SCALE 1/8" = 1'-0"	JOHN S. FINE PRESIDENT	S-3
AS NOTED	JOHN N. FORKER - EXECUTIVE DIRECTOR	
SUPV. ARCH. FOR 1/10	ARCH. STRU. CT. MECH. ELEC.	
	4/15/54	