

**MATERIALS**


	BRICK		CINDERS
	CONCRETE		
	CUT STONE		
	EXISTING WORK		
	GLAZED STRUCTURAL FACING TILE		
	LOCAL STONE		
	HOLLOW TILE		
	METAL IN ELEVATION		
	PLASTER		
	STEEL		
	WOOD		
	INSULATION		

**ABBREVIATIONS**


AM	METAL LATH ATTACHED TO WOOD JOISTS	E	EXISTING
AP	ACOUSTICAL PLASTER FINISH	EP	ENAMEL PAINT
BH	BOTTOM-HINGED SASH	EPU	ENAMEL UNDERCOATER
BK	BRICK	ES	EXISTING SASH
BO	BY OTHERS	FB	FACE BRICK
BR	BRACKET	FF	FACTORY FINISH
BZ	BRONZE	FG	WINDOW GUARD-FULL OPENING
CA	CASED OPENING	FL	FLUSH
CB	CABINET TYPE JAMB	FP	FLAT PAINT
CC	COLORED CEMENT	FT	GLAZED FACING TILE
CM	COMBINATION FRAME & TRIM	FX	FIXED
CN	CONSTRUCTION EXPOSED	GL	GLASS
CO	CONCRETE	GMP	GALVANIZED METAL PRIMER
CT	CERAMIC MOSAIC TILE	GN	GRANITE
CV	COVERED	GP	GLOSS PAINT
CW	CLEAR WIRE GLASS	GR	GRILLE
CI	CAST IRON	GST	GALVANIZED STEEL
CH	DOUBLE HUNG	HG	WINDOW GUARD-HALF OPENING
DS	DETENTION SCREEN	HM	HOLLOW METAL
		HT	HOLLOW TILE

**ABBREVIATIONS**

HU	HUNG METAL LATH	OPP	OUTSIDE PAINT PRIMER	SM	SCRIBE MOULDING
IL	INTERLOCKING	OP	OUTSIDE PAINT	SN	STAINLESS STEEL
IPP	INSIDE PAINT PRIMER	OT	OUTSIDE TRIM PAINT	SP	SPECIAL
IT	INTEGRAL	OW	OBSCURE WIRE GLASS	SS	STEEL SASH
				ST	STEEL
LM	METAL LATH	PC	CEMENT PLASTER	TZ	TERRAZZO
LO	LOCAL STONE	PG	PATTERNED GLASS	TY	TYPICAL
LS	LIMESTONE	PP	PERLITE GYPSUM PLASTER		
LV	LOUVER	PS	PROTECTION SCREEN		
		PT	PARTITION		
MA	MARBLE	QT	QUARRY TILE		
N	NEW	RA	RAISED	WD	WOOD
NIC	NOT IN CONTRACT	RE	REPAIRED	WG	WINDOW GLASS
NS	NEW SASH	RL	RELOCATED	WT	WHITE COAT PLASTER FINISH
		RP	RED LEAD PAINT		
		RWC	RAINWATER CONDUCTOR		
		SH	SHELVING		
		SL	STEEL LINTEL		

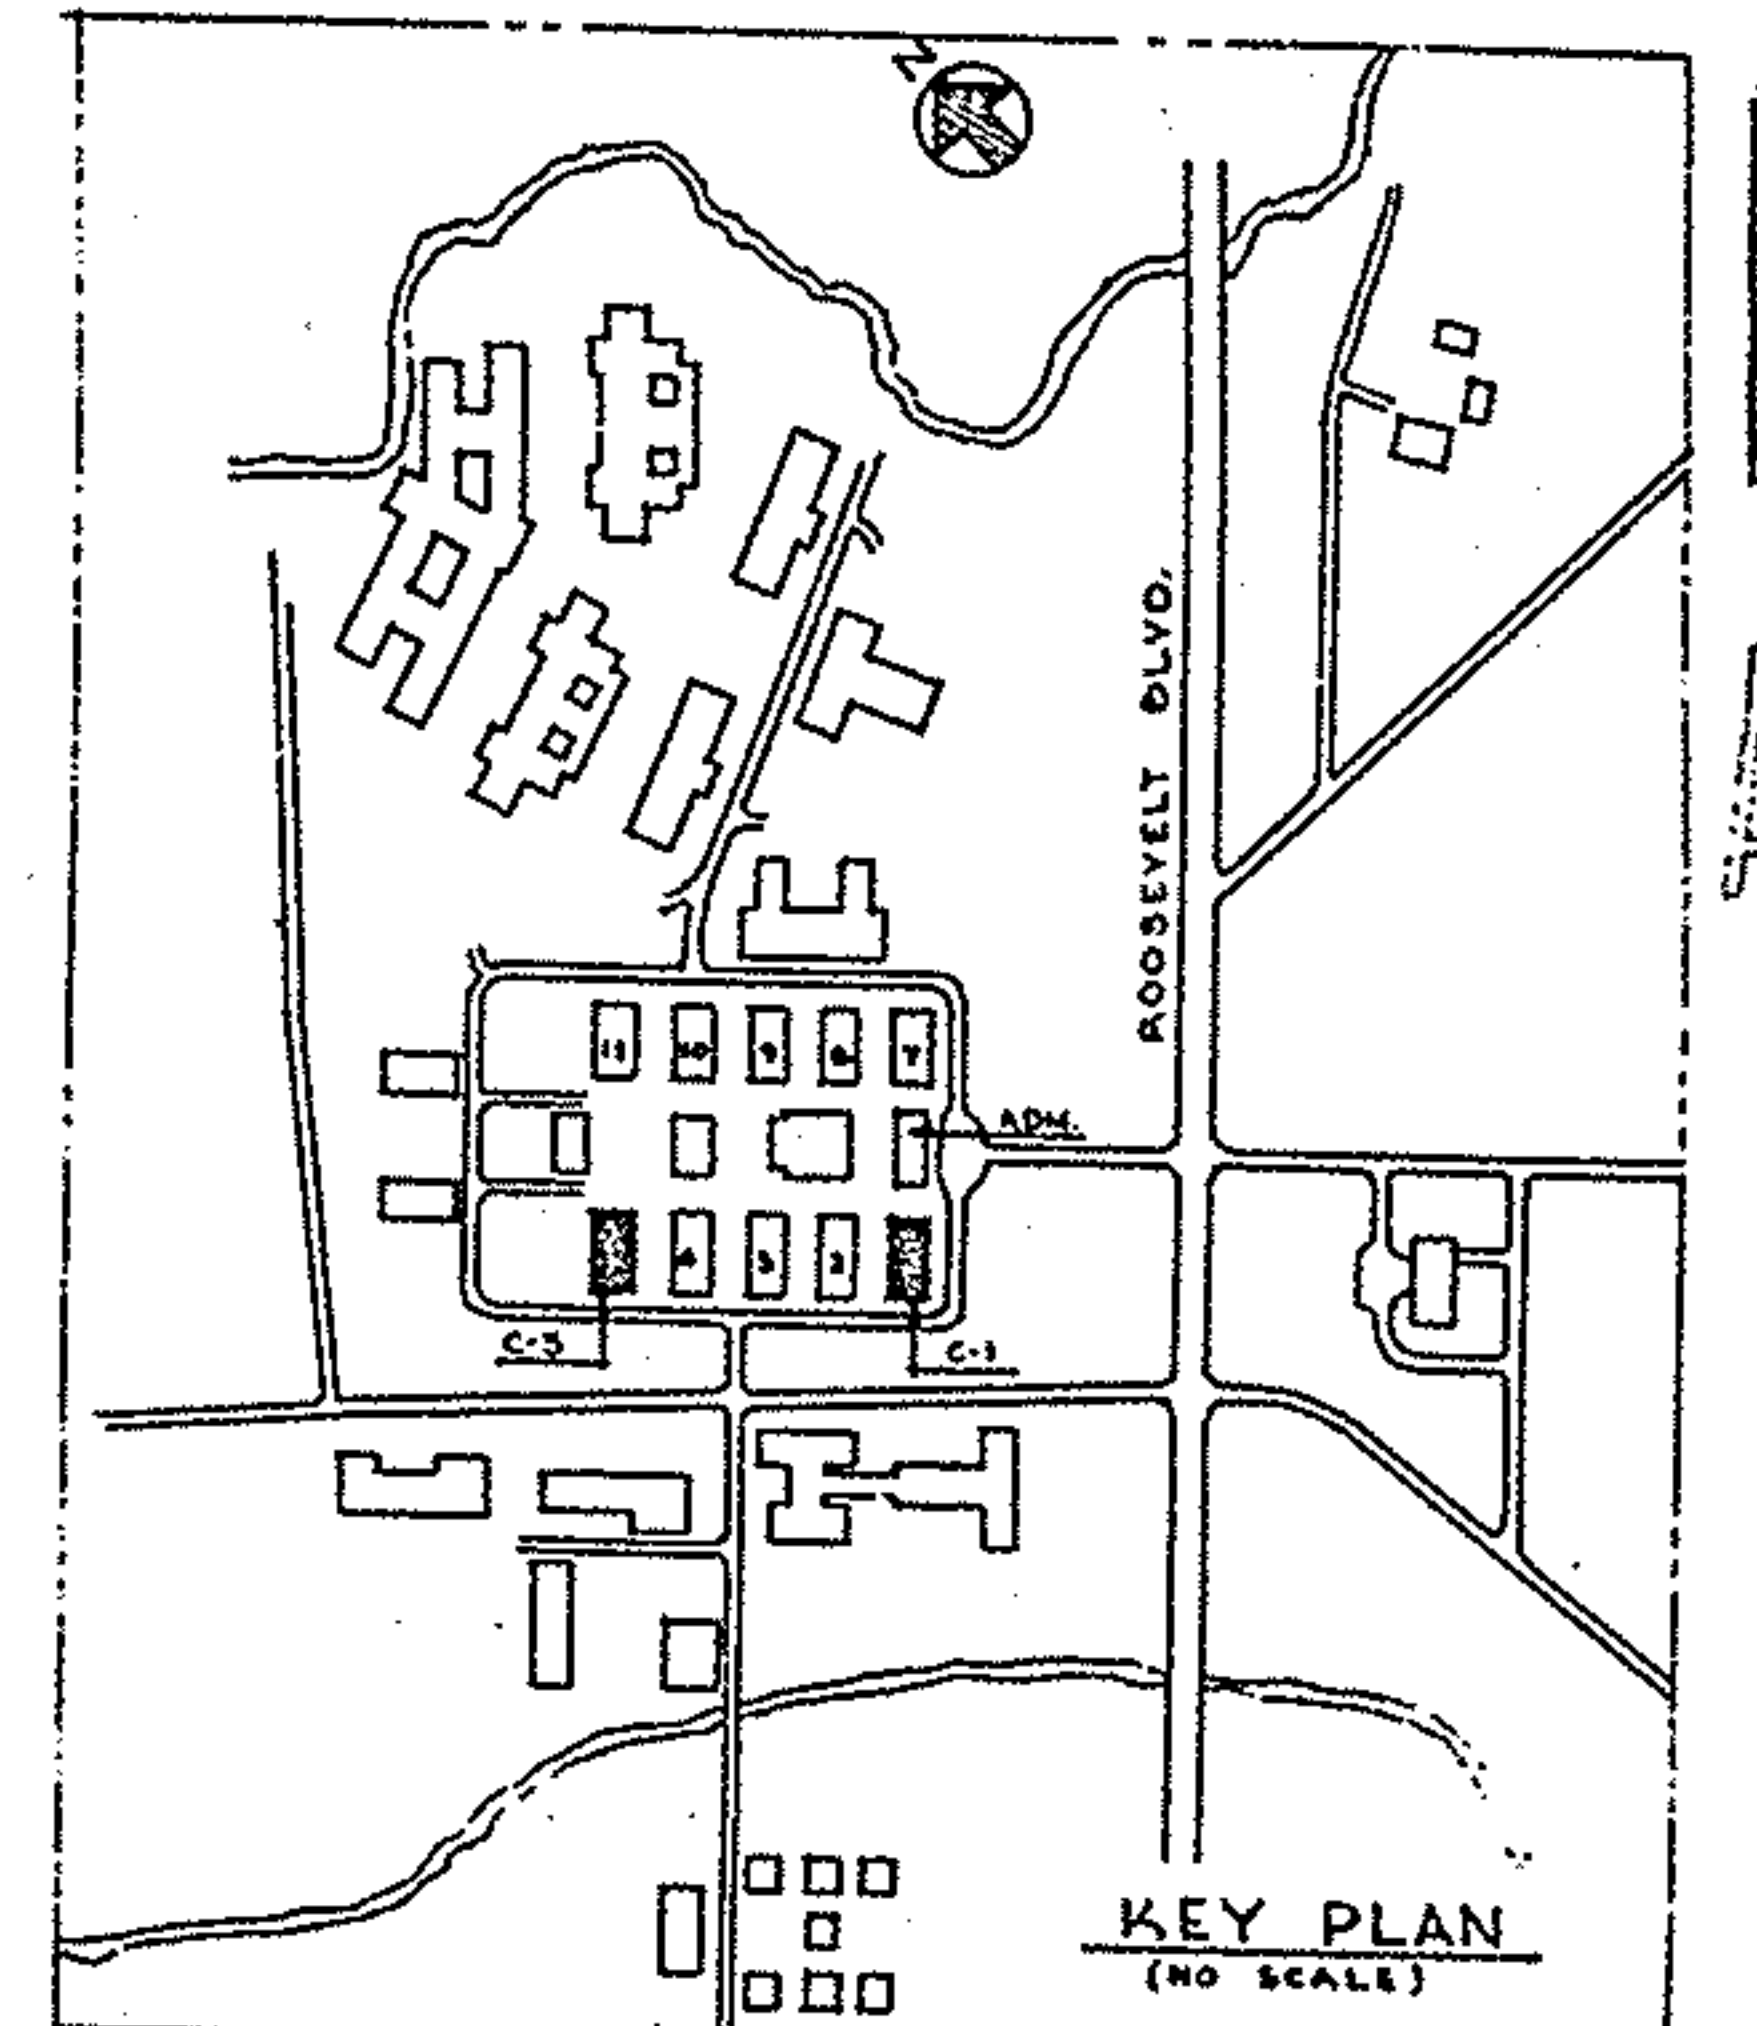

#10-53078  
STATE ART COMMISSION  
MAR - 4 1954  
RECEIVED  
STATE ART COMMISSION  
MAR - 4 1954  
COMM.

 

NOTE:  
ALL DIMENSIONS AND EXISTING CONDITIONS  
SHALL BE CHECKED AND VERIFIED BY THE  
CONTRACTOR AT THE SITE.



APPROVED  
Commonwealth of Pennsylvania  
DEPARTMENT OF WELFARE  
Architect: *John Lane Evans*  
Secretary: \_\_\_\_\_ Date: \_\_\_\_\_

APPROVED  
Comm. of Penna.  
Dept. of Labor and Industry  
Bureau of Inspection  
Pl. Insp. Division  
Date: *3-2-54*  
Approved by: *Robert W. Ross*  
Checked by: *AWB*



REVISED	
1	AS BUILT - CORRECTION 2-1-54
2	AS BUILT - ADD. INFORMATION 3-1-54

THE GENERAL STATE AUTHORITY	
APPROVED	EXECUTIVE DIRECTOR
APPROVED	DIRECTING ENGINEER
SUBMITTED	<i>John Lane Evans</i>
APPROVED	DEPT. OF WELFARE
APPROVED	DEPT. OF PROPERTY & SUPPLIES
APPROVED	
ACCEPTED	CONTRACTOR BY
ACCEPTED	CONTRACTOR BY
ACCEPTED	CONTRACTOR BY

PROJECT NO. G.S.A. 510-11  
**PHILADELPHIA STATE HOSPITAL**  
PHILADELPHIA, PHILADELPHIA COUNTY, PENNSYLVANIA  
**REMDEL FEMALE BUILDINGS C1 AND C5**  
PLOT PLAN

JOHN LANE EVANS REGISTERED ARCHITECT  
PHILADELPHIA 7, PENNA.

DATE: MAR. 1, 1954  
SCALE: 1" = 40'-0"

THE GENERAL STATE AUTHORITY SHEET NO. A-1

JOHN S. FINE PRESIDENT  
JOHN H. FORKER-EXECUTIVE DIRECTOR  
HARRISBURG, PENNSYLVANIA  
CHECKED FOR G.S.A.

BUY. ARCH. ARCH. STRUCT. MECH. ELEC.  
JWR 4/6 4-7-54