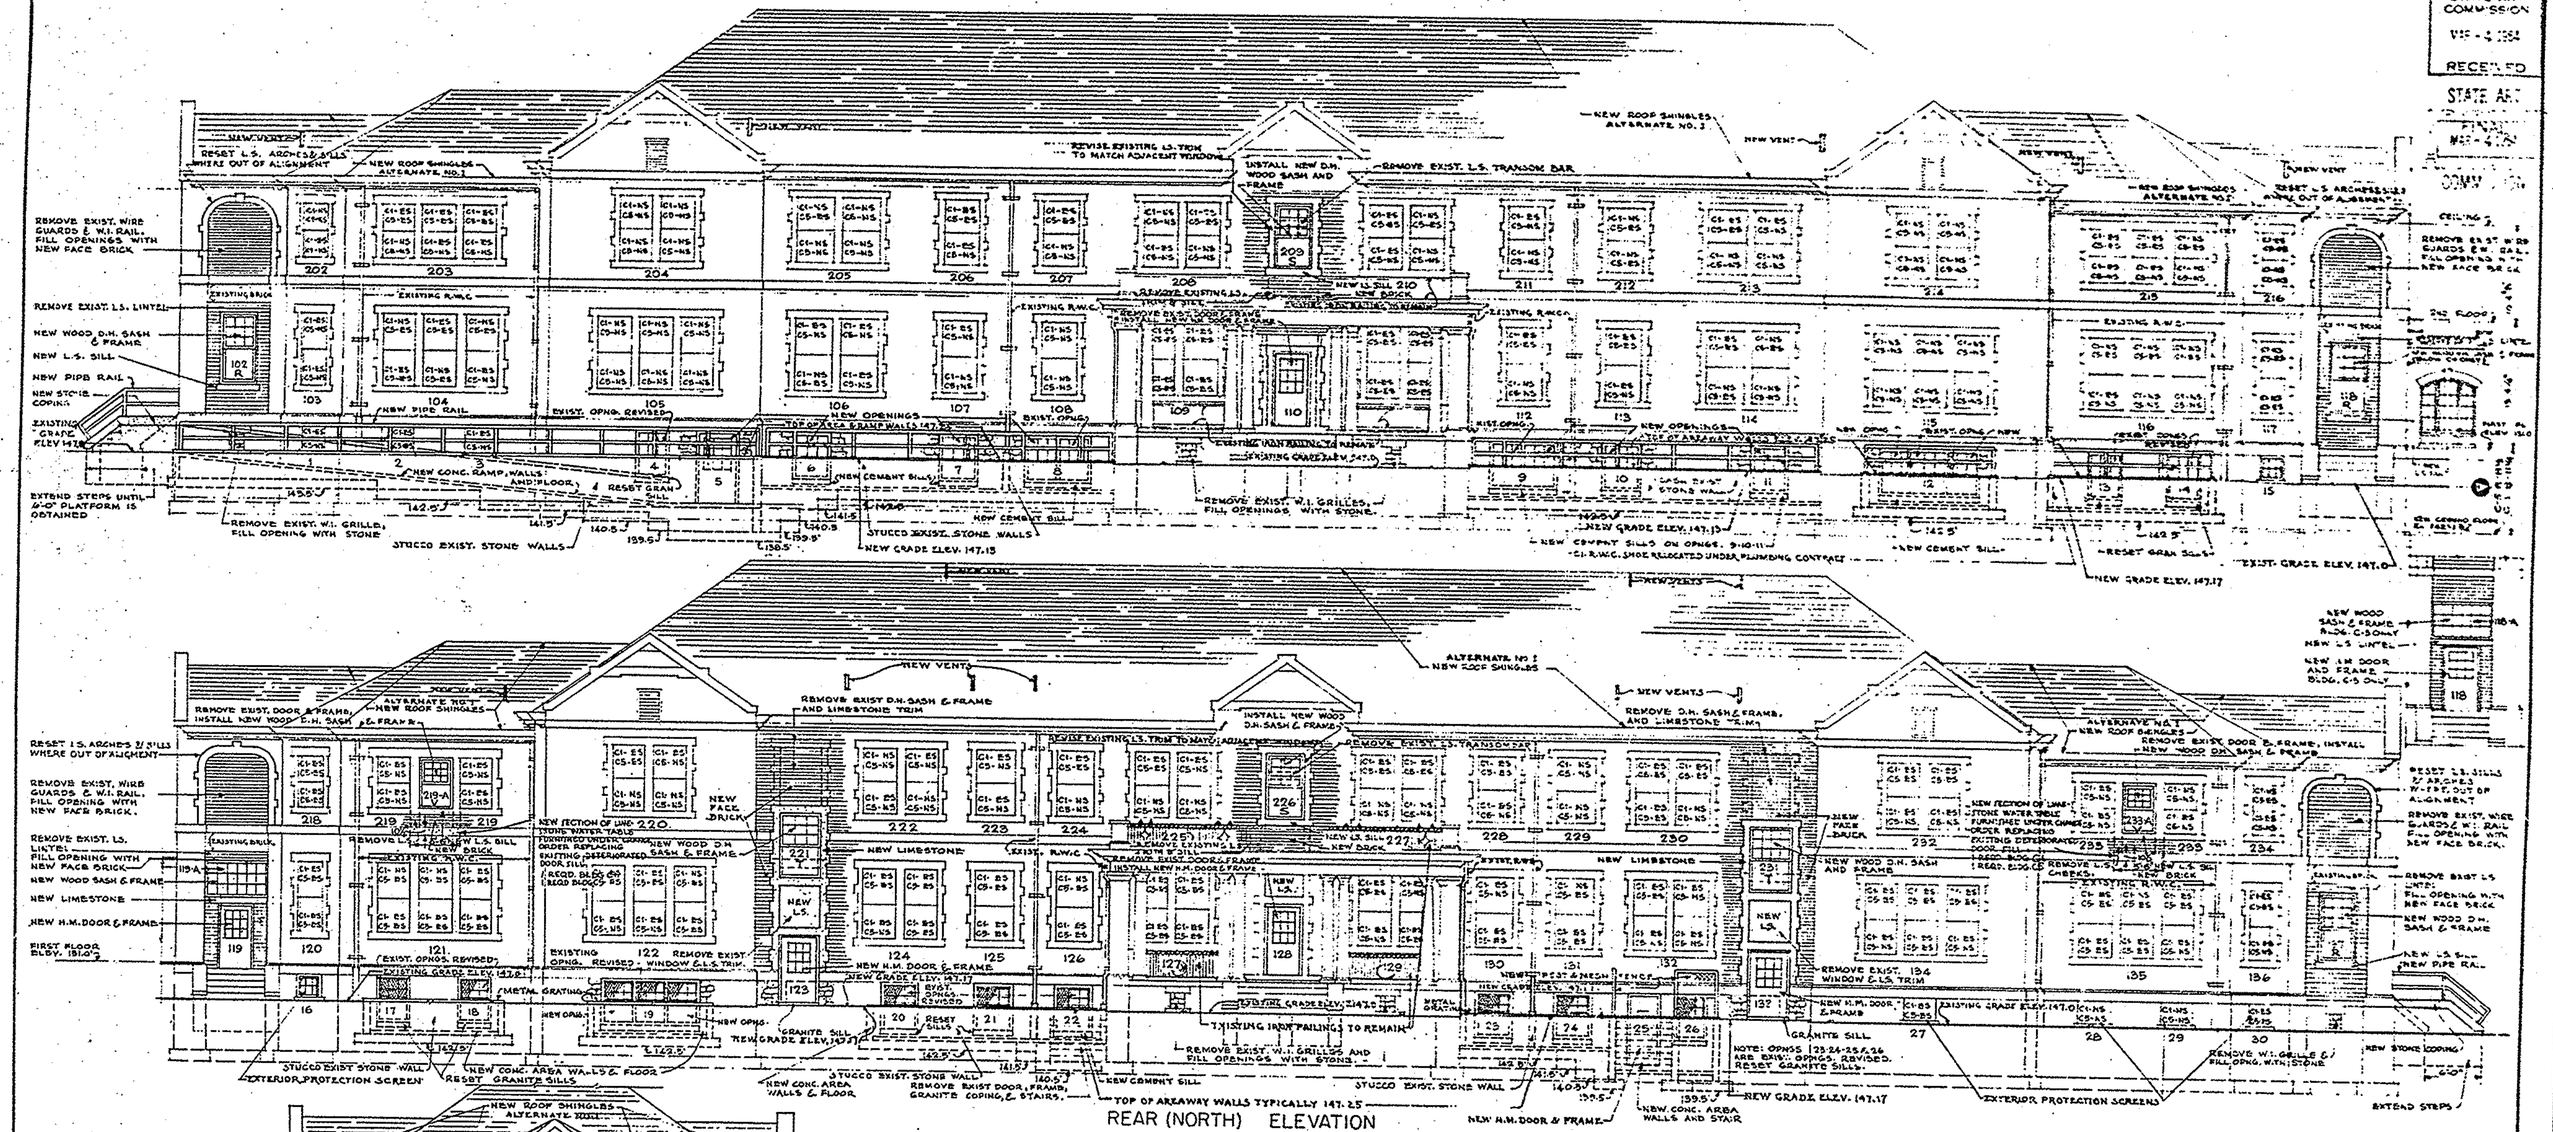

REAR (NORTH) ELEVATION

(ALL ELEVATIONS TYPICAL FOR BLDGS. C1 & C5 EXCEPT AS NOTED)

ABBREVIATIONS:

N.S. NEW SASH
E.S. EXISTING SASH
C1 BUILDING C1
C5 BUILDING C5

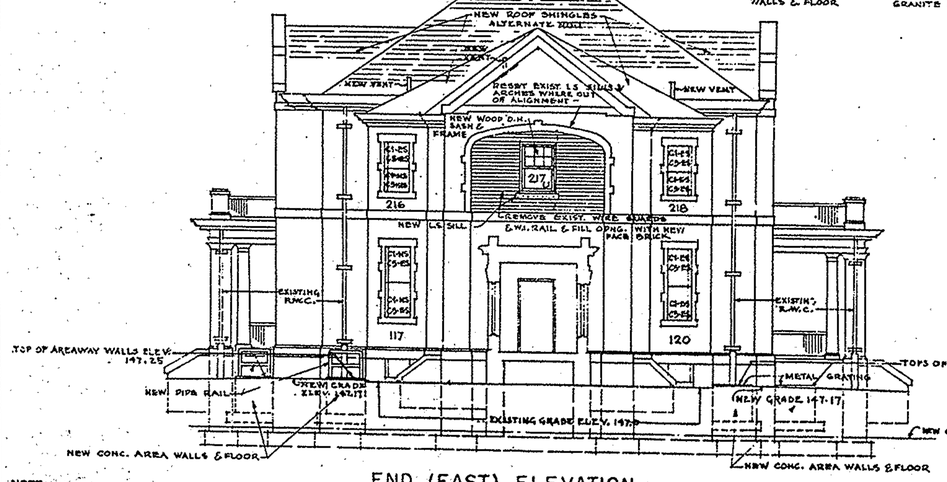

END (EAST) ELEVATION

NOTE:
ALL DIMENSIONS AND EXISTING CONDITIONS SHALL BE CHECKED AND VERIFIED BY THE CONTRACTOR AT THE SITE.

APPROVED
Commonwealth of Pennsylvania
DEPARTMENT OF WELFARE

Architect John Rittenhouse Date 3-4-54
Secretary _____ Date _____

STATE ART COMMISSION APPROVED 3-4-54 PENNSYLVANIA

REGISTERED ARCHITECT PENNSYLVANIA JOHN LANE EVANS No. 4176

STATE ART COMMISSION
MAR 4 1954
RECEIVED

APPROVED
Comm. of Penna.
Dept. of Welfare
Date 3-2-54 Rec. 66 5
Approved: Robert F. Pass
Checked by: H.M.S.

SUPERINTENDENT, PHILADELPHIA STATE HOSPITAL DATE

REVISED	
1	AS BUILT — CORRECTION 5-1-56

THE GENERAL STATE AUTHORITY

APPROVED _____ EXECUTIVE DIRECTOR
APPROVED _____ DIRECTING ENGINEER
SUBMITTED _____ ARCHITECT
APPROVED _____ DEPT. OF WELFARE
APPROVED _____ DEPT. OF PROPERTY & SUPPLIES
APPROVED _____
ACCEPTED _____ CONTRACTOR BY
ACCEPTED _____ CONTRACTOR BY
ACCEPTED _____ CONTRACTOR BY

PROJECT NO. G.S.A. 510-11

PHILADELPHIA STATE HOSPITAL
PHILADELPHIA, PHILADELPHIA COUNTY, PENNSYLVANIA

REMODEL FEMALE BUILDINGS C1 AND C5
ELEVATIONS

JOHN LANE EVANS
12 SOUTH 12TH STREET
REGISTERED ARCHITECT
PHILADELPHIA 7, PENNA.

DATE MAR. 1, 1954
SCALE 1/8" = 1'-0"

THE GENERAL STATE AUTHORITY
JOHN S. FINE PRESIDENT
JOHN N. FORKER-EXECUTIVE DIRECTOR
HARRISBURG, PENNSYLVANIA

SHEET NO. A5

CHECKED FOR G.S.A.

SUPV. ARCH.	ARCH.	STRUCT.	MECH.	ELEC.
JOR 4/1/54	R.H.B. 4-7-54			