



 


NOTE:
REFER TO SHEET NO. A-2 FOR
LOCATION OF SECTIONS.

NOTE:
ALL DIMENSIONS AND EXISTING CONDITIONS
SHALL BE CHECKED AND VERIFIED BY THE
CONTRACTOR AT THE SITE.

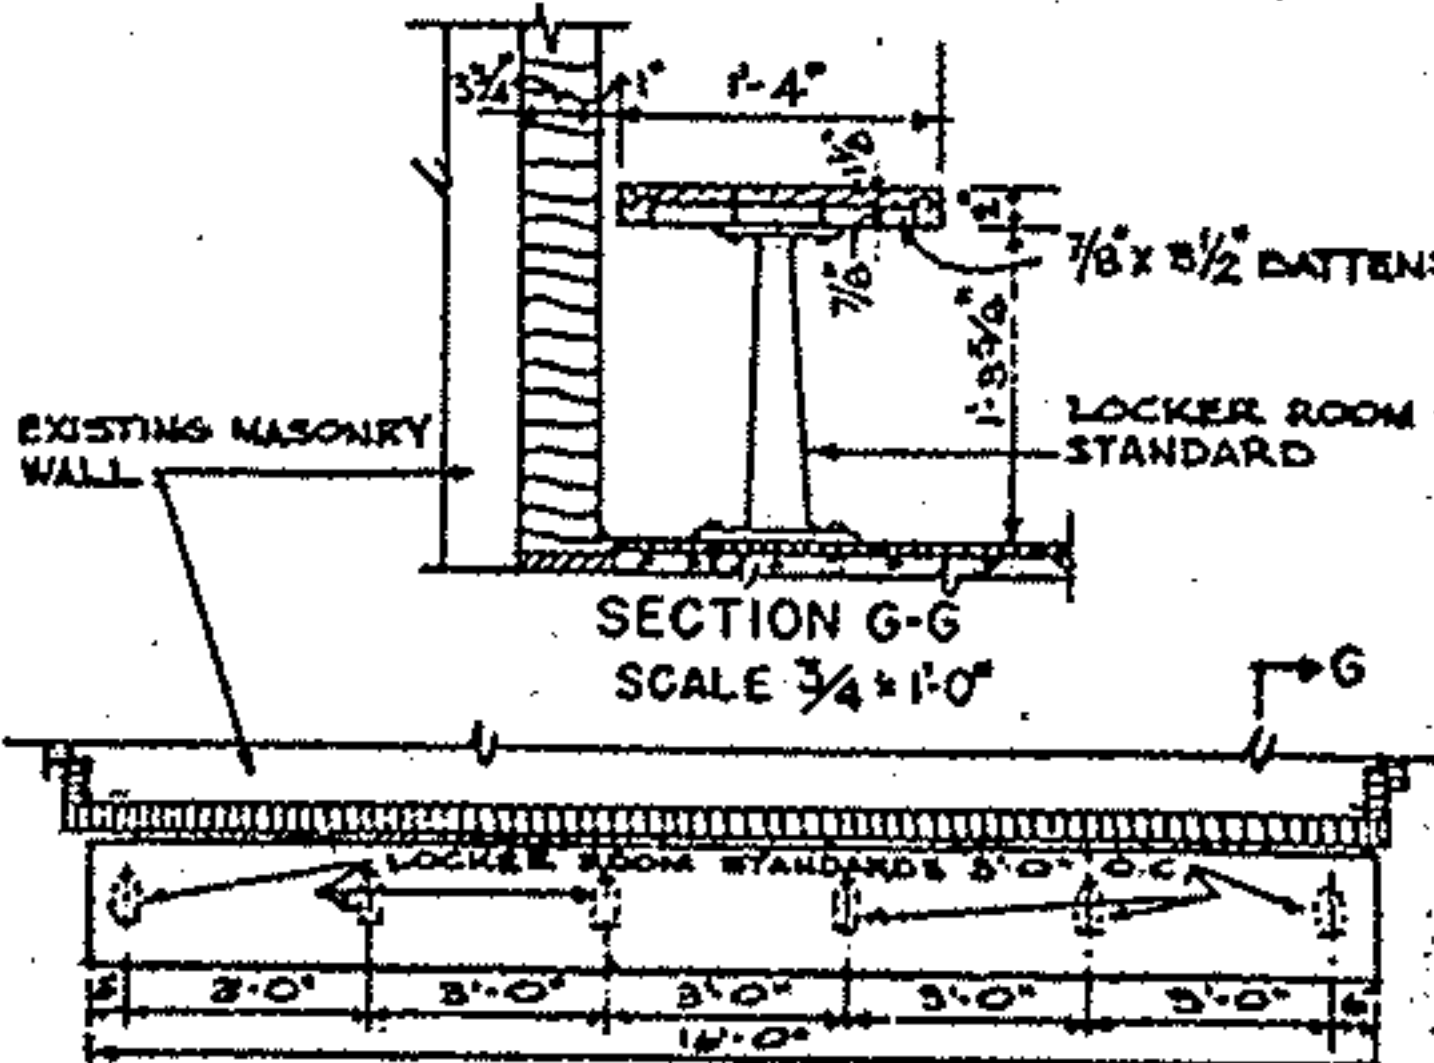


DETAILS—WOOD BENCH IN GROUND FLOOR
SHOWERS & DRYING ROOM

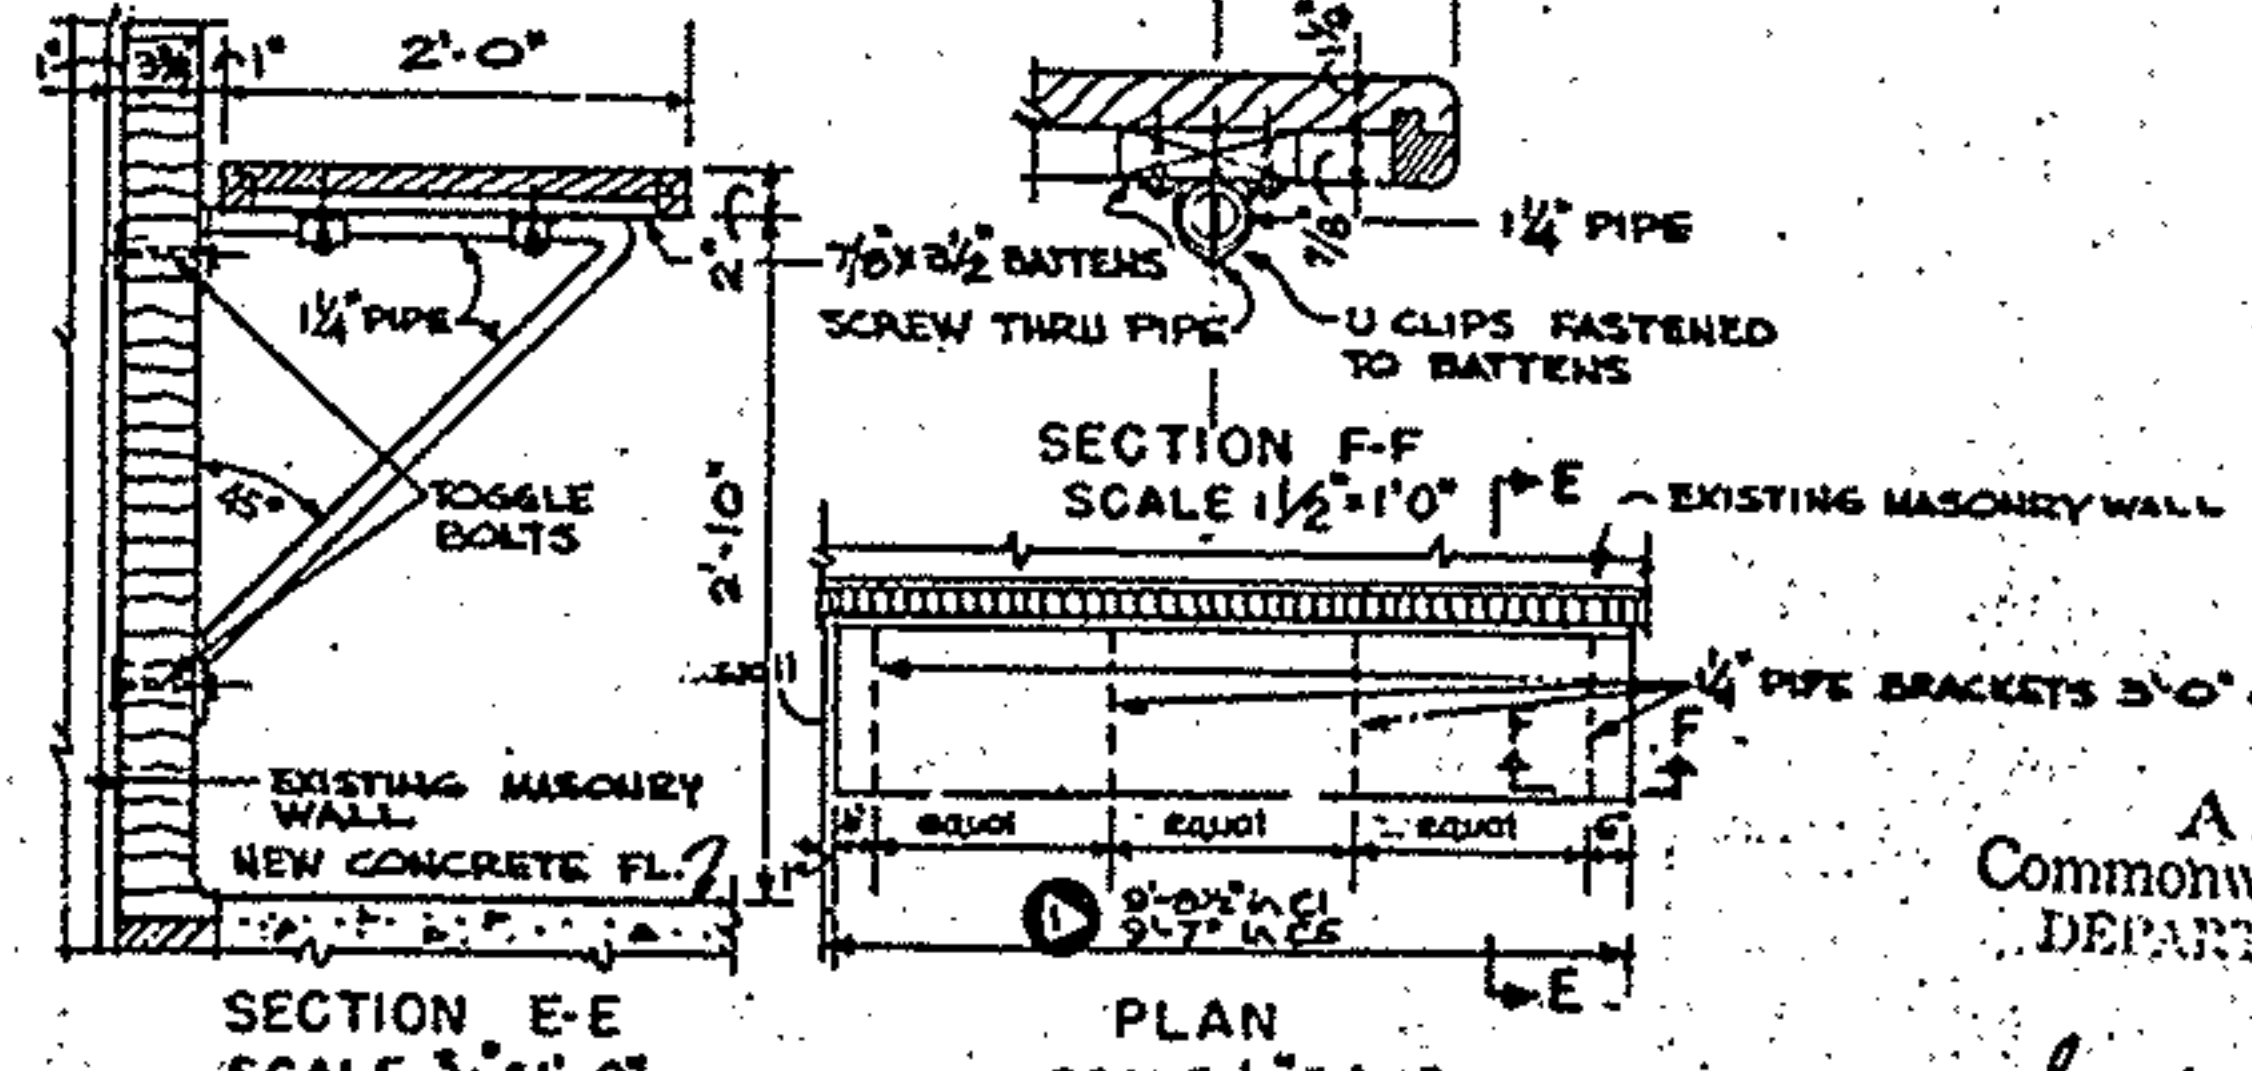

DETAILS—SORTING TABLE IN GROUND FLOOR
CLEAN LINEN STORAGE ROOM

APPROVED
Commonwealth of Pennsylvania
DEPARTMENT OF WELFARE

Architect: *John N. Foraker*
Secretary: *John N. Foraker*

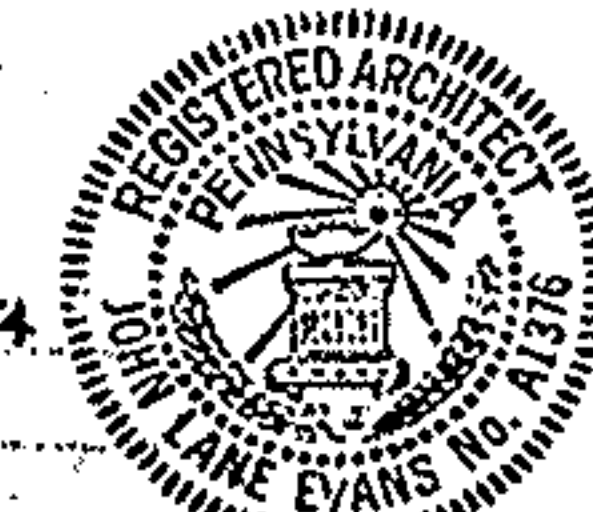

REVISED		THE GENERAL STATE AUTHORITY		PROJECT No. G.S.A. 510-11	
1	AS BUILT - 5-1-54	APPROVED	EXECUTIVE DIRECTOR	PHILADELPHIA STATE HOSPITAL PHILADELPHIA, PHILADELPHIA COUNTY, PENNSYLVANIA	
2	AS BUILT - 5-1-54	APPROVED	REGISTERED ARCHITECT	REMODEL FEMALE BUILDINGS C1 AND C5	
3	AS BUILT - 5-1-54	SUBMITTED	ARCHITECT	SECTIONS AND ELEVATION	
4	AS BUILT - 5-1-54	APPROVED	DEPT. OF WELFARE	JOHN LANE EVANS 12 SOUTH 12TH STREET PHILADELPHIA 7, PENNA.	REGISTERED ARCHITECT
5	AS BUILT - 5-1-54	APPROVED	DEPT. OF PROPERTY & SUPPLIES	DATE: MAR. 1, 1954	THE GENERAL STATE AUTHORITY
6	AS BUILT - 5-1-54	APPROVED	CONTRACTOR	JOHN S. FINE JOHN N. FORAKER-EXECUTIVE DIRECTOR	PRESIDENT
7	AS BUILT - 5-1-54	APPROVED	CONTRACTOR	HARRISBURG, PENNSYLVANIA	CHECKED FOR G.S.A.
8	AS BUILT - 5-1-54	APPROVED	CONTRACTOR	DATE: 4-7-54	STRUCT. MECH. ELEC.