LEGEND

BRICK
CONCRETE BLOCK
CONCRETE
STEEL - IRON
EARTH
ALUMINUM
INSULATION
WOOD
MARBLE
TERRAZZO
CRUSHED STONE
RUBBLE STONE

(3/1) DETAIL NUMBER / SHEET NUMBER ON WHICH DETAIL IS LOCATED
(C5) COLUMN NUMBER
130 DOOR NUMBER
C FRAME & WINDOW TYPE
FIN. GR. / EX. GR. FINISHED GRADE / EXISTING GRADE

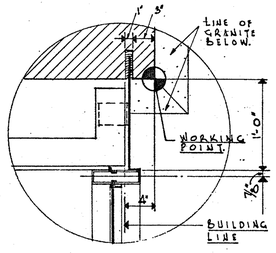

DETAIL (5/1) OF WORKING POINT.
SCALE 1½" = 1'-0"

KEY TO ABBREVIATIONS

AC. T. - ACOUSTIC TILE	EXIST. - EXISTING	MISC. - MISCELLANEOUS
A. D. - AREA DRAIN	EL. - ELEVATION	MFG. - MANUFACTURE
AL. - ALUMINUM	ELEC. - ELECTRIC (AL)	N.I.C. - NOT IN CONTRACT
L - ANGLE	ENCL. - ENCLOSURE	O. C. - ON CENTER
A.T. - ASPHALT TILE	EXT. - EXTERIOR	O. D. - OUTSIDE DIAMETER
BL. - BLOCK	EXPAN. - EXPANSION	OPG. - OPENING
BLDG. - BUILDING	F. D. - FLOOR DRAIN	PLATE
BR. CS. - BRICK COURSES	F. E. - FIRE EXTINGUISHER	PART. - PARTITION
BD. - BOARD	FIN. - FINISH (ED)	P. B. - PANEL BOARD
B.M. - BEAM	FL. - FLOOR	PL. - PLASTER
C - CHANNEL	F. P. - FIREPROOF	PLBG. - PLUMBING
CAB. - CABINET	F. S. - FULL SIZE	P. C. - PILE CAP
C. B. - CATCH BASIN	G. - GRILLE	PT. - POINT
CEM. - CEMENT	GA. - GAUGE	R. - RADIUS
CER. T. - CERAMIC TILE	GAL. - GALVANIZED IRON	R. C. - REMOTE CONTROL
C. I. - CAST IRON	GL. - GLASS	RD. - ROUND
CLG. - CEILING	GR. - GRADE	RWC. - RAIN WATER CONDUCTOR
C.O. - CLEAN OUT	HGT. - HEIGHT	REINF. - REINFORCED
COL. - COLUMN	H. B. - HOSE BIBB	REQ'D - REQUIRED
CONC. - CONCRETE	H. M. - HOLLOW METAL	S. - SWITCH
CONST. - CONSTRUCTION	HTG. - HEATING	S.S. - STAINLESS STEEL
C.F.M. - CUBIC FEET PER MINUTE	I. - IRON	ST. - STONE
CSK. - COUNTERSUNK	I. D. - INSIDE DIAMETER	STL. - STEEL
CONTR. - CONTRACTOR	INSUL. - INSULATION	SUSP. - SUSPENDED
CONT. - CONTINUOUS	INT. - INTERIOR	STOR. - STORAGE
CONC. BL. - CONCRETE BLOCK	LAV. - LAVATORY	TER. - TERRAZZO
DET. - DETAIL	MAR. - MARBLE	V. - VENT OR VENTILATOR
DF. - DRINKING FOUNTAIN	MAT. - MATERIAL	VERT. - VERTICAL
DIA. OR ϕ - DIAMETER	MECH. - MECHANICAL	W.C. - WATER CLOSET
DIM. - DIMENSION	MET. - METAL	W. GL. - WIRE GLASS
DN. - DOWN	M. H. - MAN HOLE	W. I. - WROUGHT IRON
DR. - DRAIN	MLDG. - MOULDING	W. P. - WATERPROOF
DWG. - DRAWING	M. OPG. - MASONRY OPENING	WD. - WOOD

#10,894
STATE ART COMMISSION
JAN 12 1955
RECEIVED

STATE ART APPROVED FINAL JAN 12 1955 COMMISSION

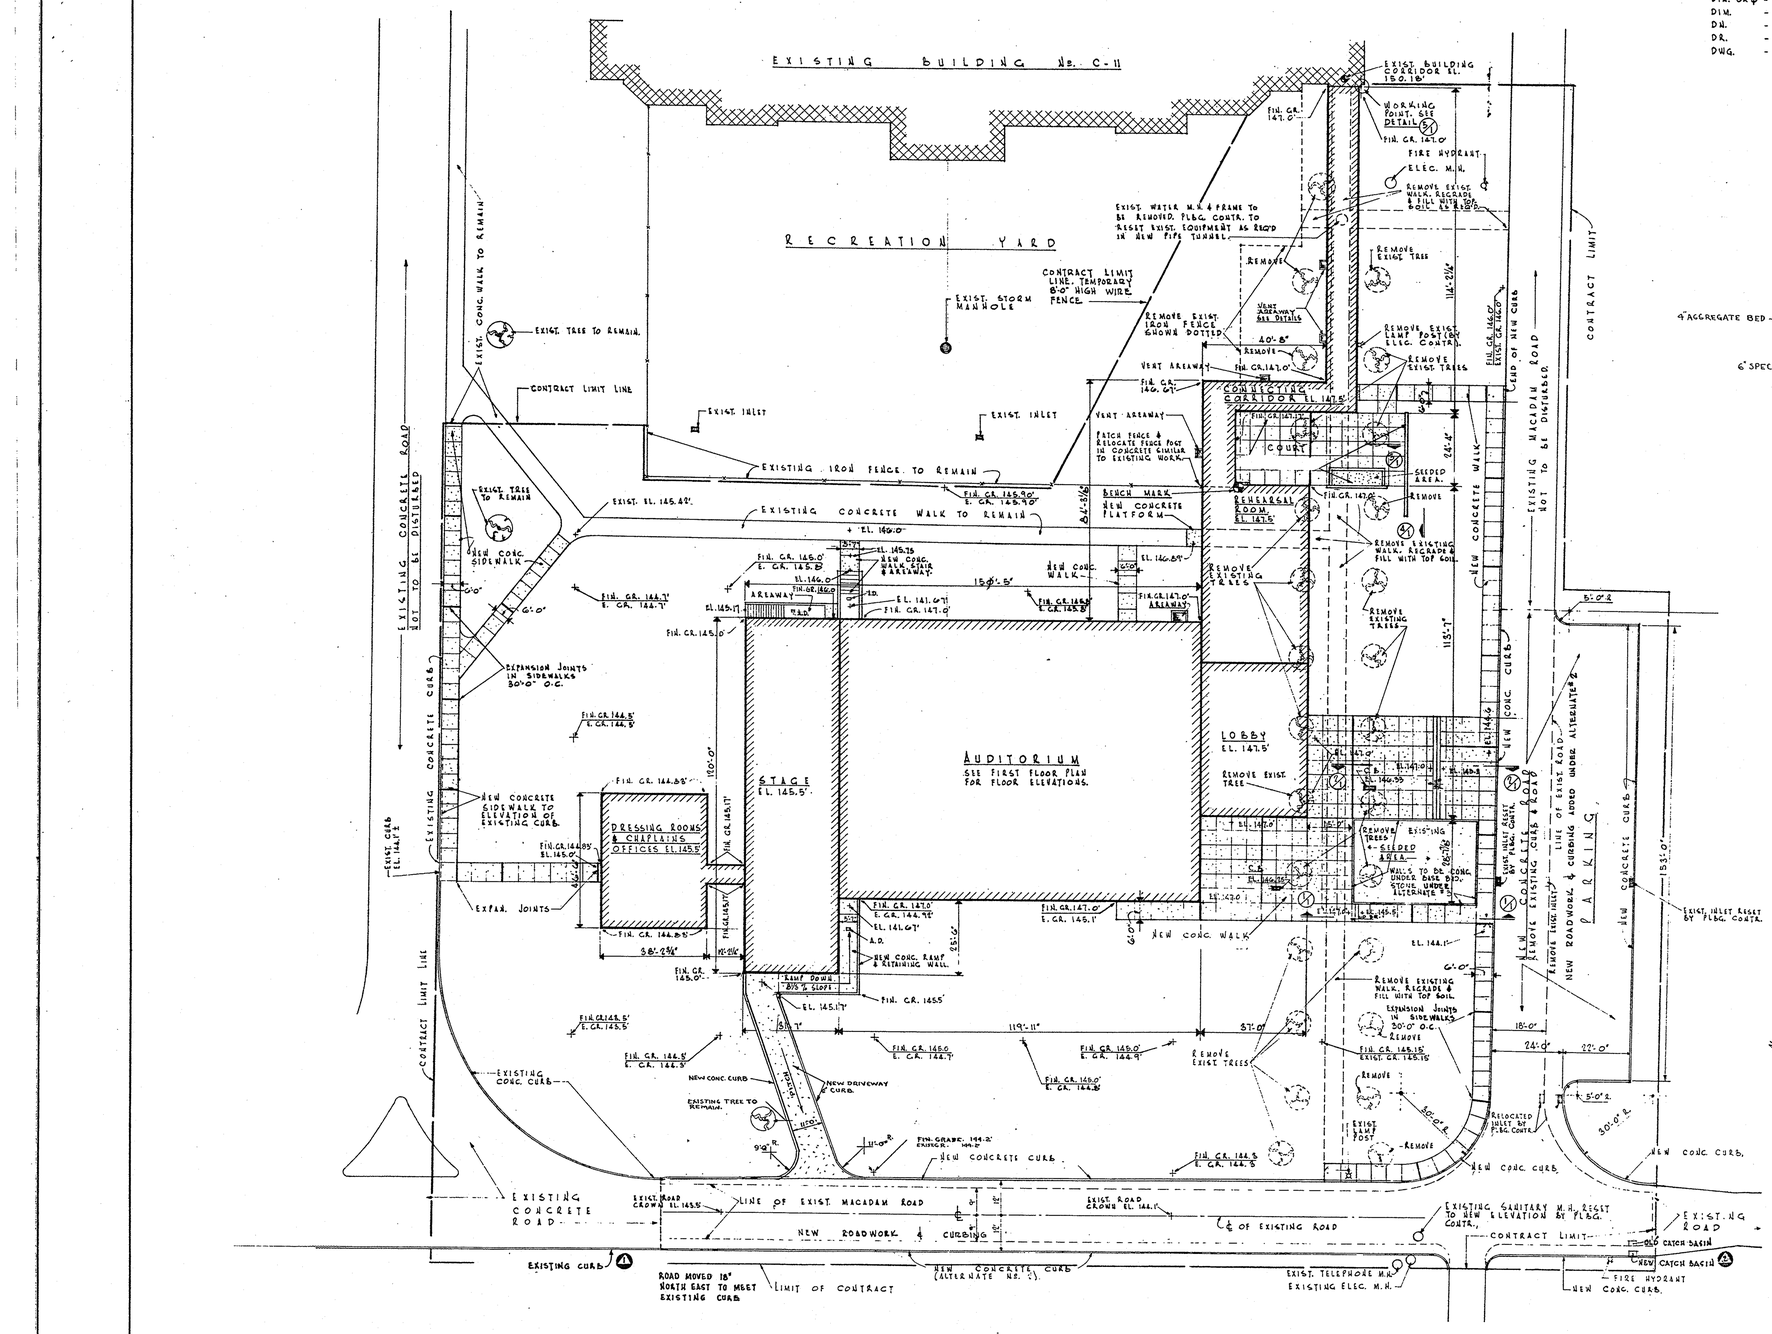

PLOT PLAN.
SCALE 1" = 20'-0"

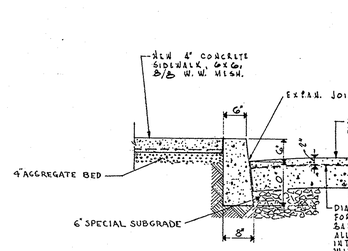

TYPICAL CURB DETAIL
SCALE 3/4" = 1'-0"

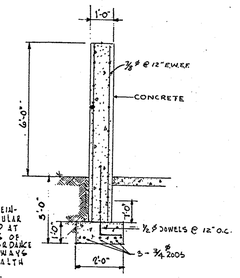

SECTION (5/1)
SCALE ⅜" = 1'-0"

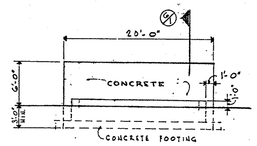

ELEVATION (5/1)
SCALE ⅜" = 1'-0"

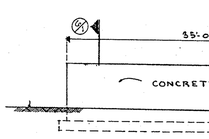

ELEVATION (5/1)

STONE WALLS

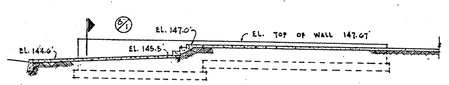

ELEVATION (5/1)

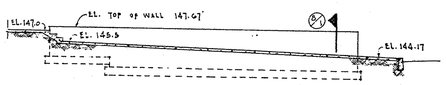

ELEVATION (5/1)
SCALE ⅛" = 1'-0"

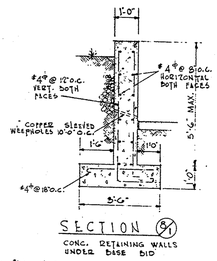

SECTION (5/1)
CONC. RETAINING WALLS UNDER BASE BID
SCALE ⅜" = 1'-0"

NOTE!
ALL DIMENSIONS & EXISTING CONDITIONS SHALL BE CHECKED & VERIFIED BY THE CONTRACTOR AT THE SITE.

APPROVED
Commonwealth of Pennsylvania
Department of Welfare
Robert R. Shuster Date 1-12-55
Registered Architect
Date
Secretary

STATE ART COMMISSION APPROVED 1-12-55 PENNSYLVANIA

REGISTERED ARCHITECT PENNSYLVANIA JAMES A. NOLEN & SWINBURNE

REVISED
(1) AS BUILT JAN. 29, 1957
(2) AS BUILT JAN. 29, 1957

James A. Nolen Jr. ARCHITECT
ENGINEER
INSTITUTION
Whitney Ransom 2/27/57 SUPERVISING ARCHITECT GSA

CHECKED BY THE GENERAL STATE AUTHORITY

ARCH. R.N.D. 2-14-55	STRUCT.	HEAT.	PLUMB.	ELECT.
ELEVATORS	KITCH. EQ.	L'DRY. EQ.	HOSP. EQ.	MISC.

PROJECT No GSA—510-12
PHILA. STATE HOSPITAL
PHILADELPHIA PENNSYLVANIA
CHAPEL & AUDITORIUM BUILDING
PLOT PLAN
NOLEN & SWINBURNE — REGISTERED ARCHITECTS
1649 NO. BROAD STREET PHILADELPHIA, PA.

DATE: 7 JAN. 1957
SCALE: AS NOTED
THE GENERAL STATE AUTHORITY
JOHN N. FORKER - EXECUTIVE DIRECTOR
HARRISBURG, PENNSYLVANIA
DWG. No A-1