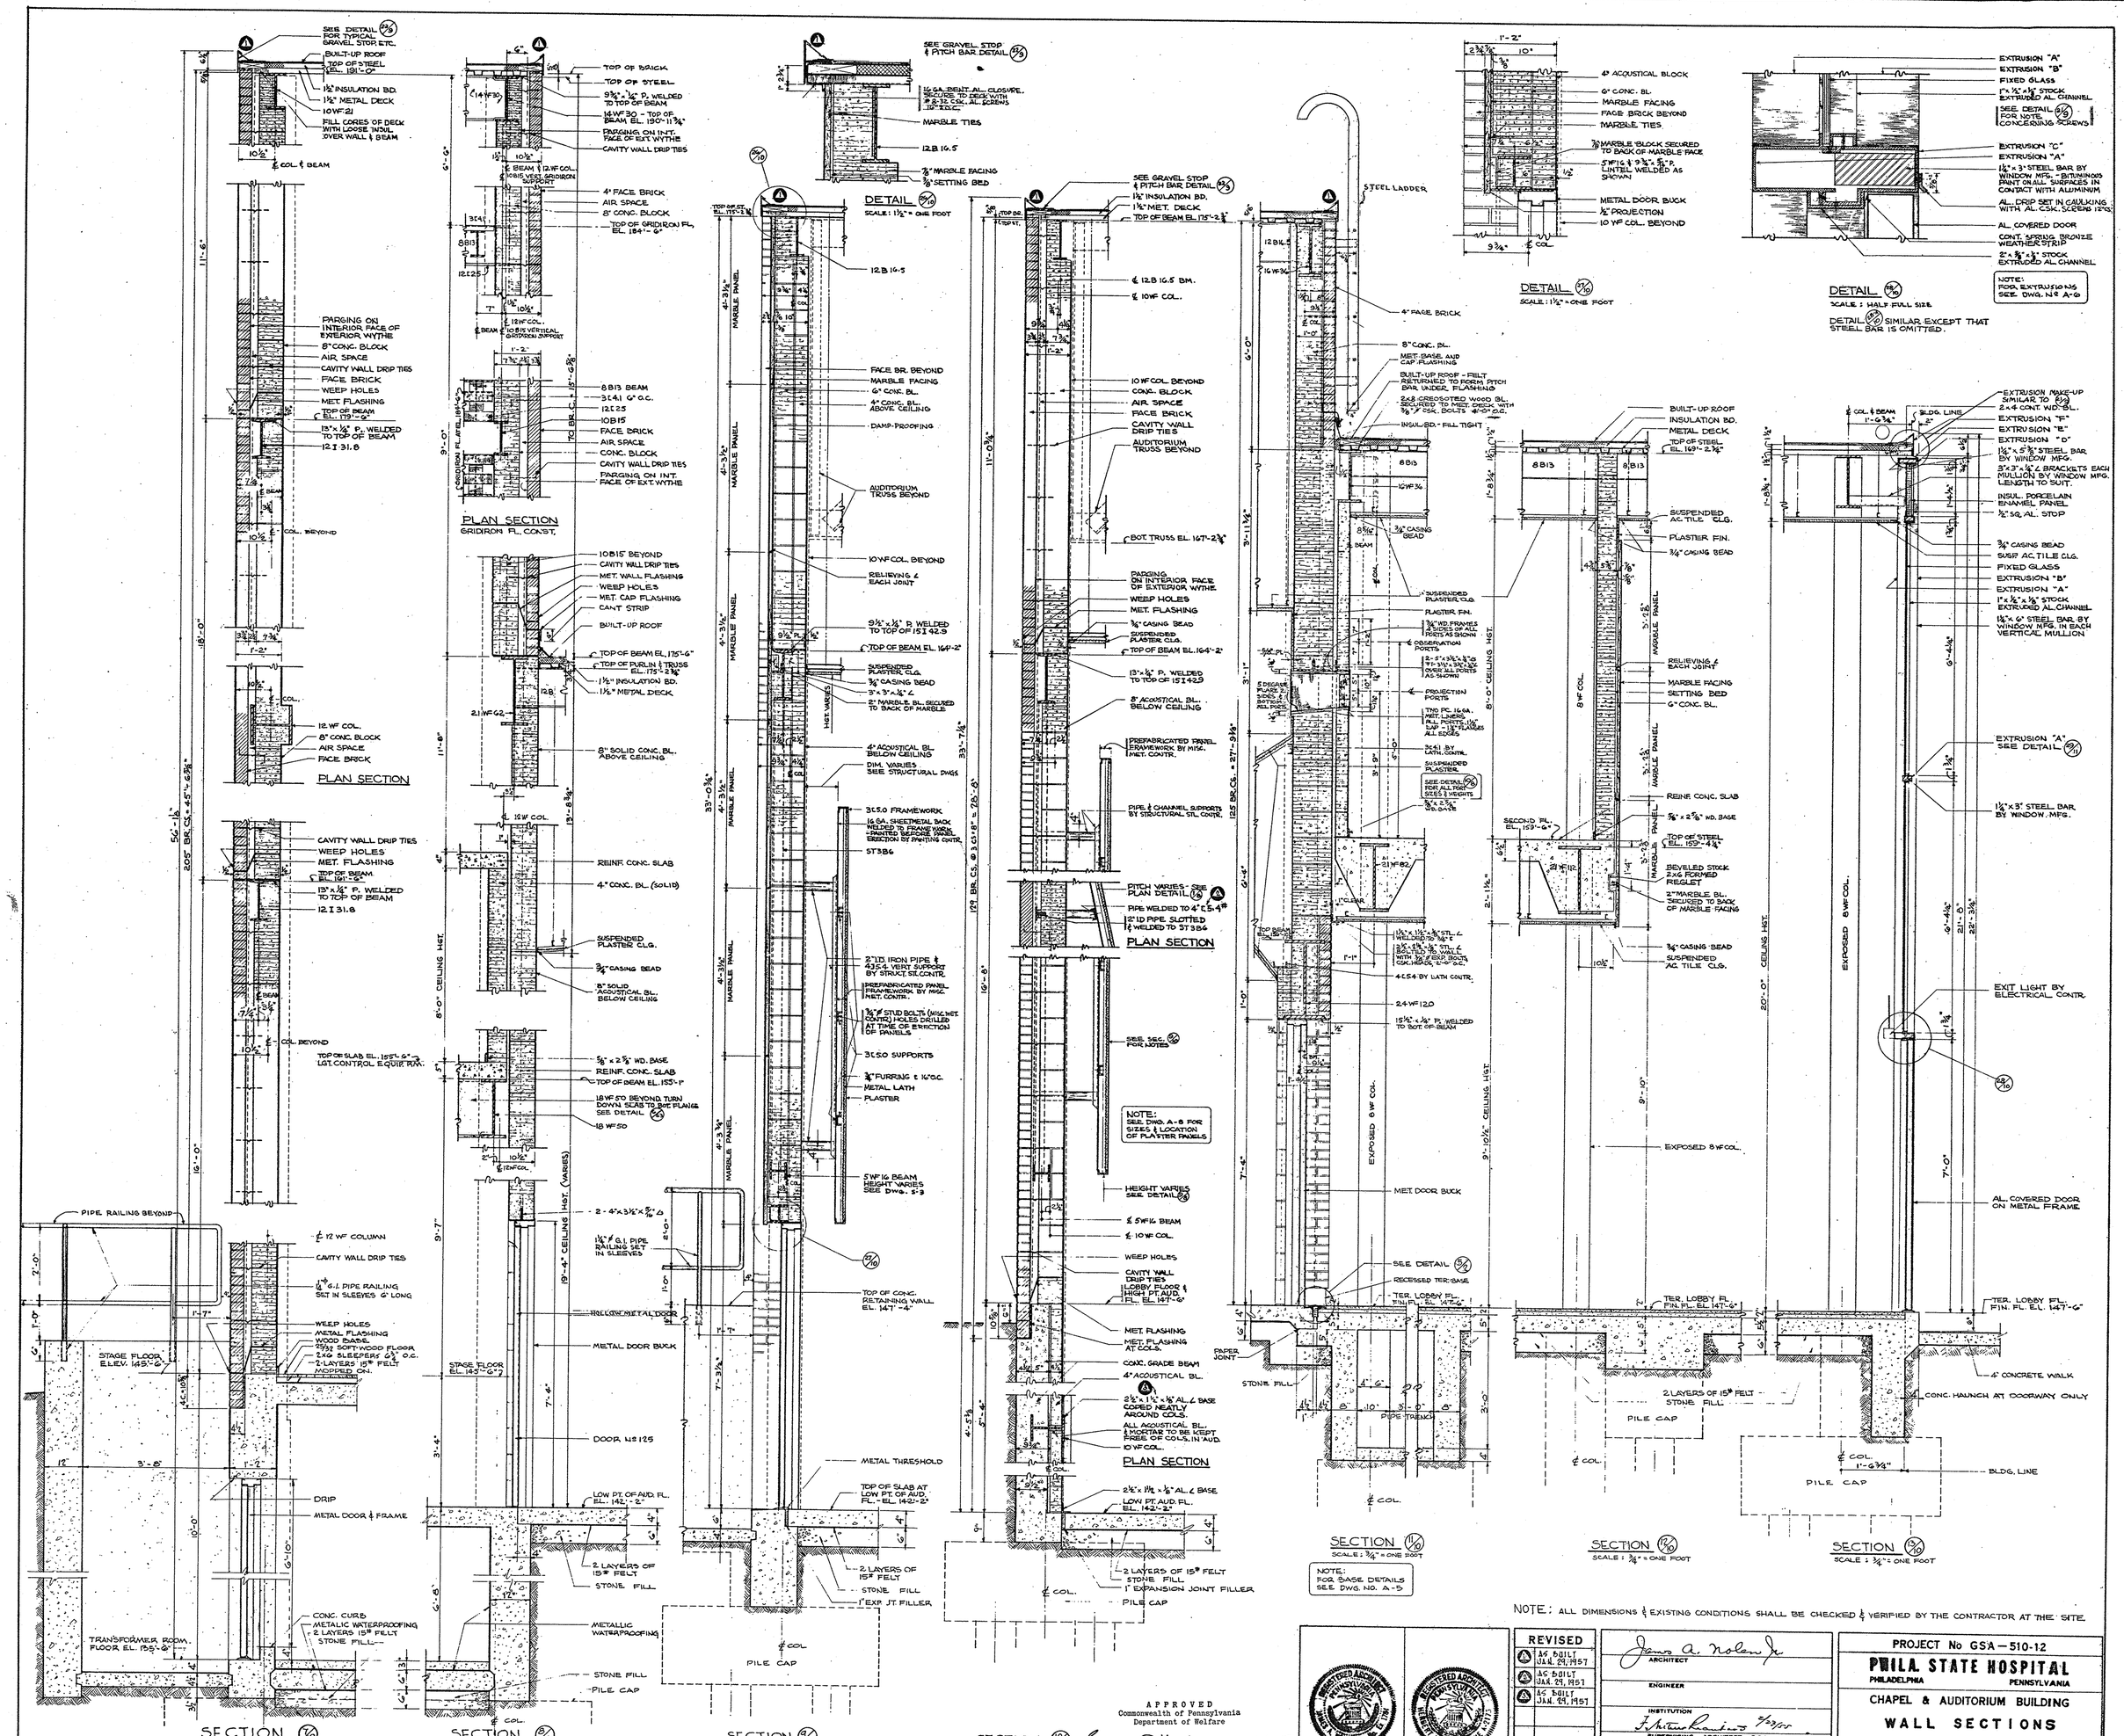
SECTION 8/10
SECTION 9/10
SECTION 10/10
SECTION 11/10
SECTION 12/10
SECTION 13/10
PLAN SECTION
DETAIL 5/10
DETAIL 6/10
DETAIL 7/10
DETAIL 8/10
DETAIL 9/10
DETAIL 10/10
DETAIL 11/10
DETAIL 12/10
DETAIL 13/10
NOTE: SEE DWG. A-8 FOR SIZES & LOCATION OF PLASTER PANELS
NOTE: FOR BASE DETAILS SEE DWG. NO. A-5
NOTE: FOR EXTRUSIONS SEE DWG. Nº A-6
NOTE: ALL DIMENSIONS & EXISTING CONDITIONS SHALL BE CHECKED & VERIFIED BY THE CONTRACTOR AT THE SITE.
APPROVED
Commonwealth of Pennsylvania
Department of Welfare
Registered Architect
Secretary
REVISED
AS BUILT JAN. 29, 1957
AS BUILT JAN. 29, 1957
AS BUILT JAN. 29, 1957
ARCHITECT
ENGINEER
INSTITUTION
SUPERVISING ARCHITECT GSA
CHECKED BY THE GENERAL STATE AUTHORITY
ARCH. R.H.S. 2-14-55
STRUCT.
HEAT.
PLUMB.
ELECT.
ELEVATORS
KITCH. EQ.
L'DRY. EQ.
HOSP. EQ.
MISC.
PROJECT No GSA-510-12
PHILA. STATE HOSPITAL
PHILADELPHIA PENNSYLVANIA
CHAPEL & AUDITORIUM BUILDING
WALL SECTIONS
NOLEN & SWINBURNE — REGISTERED ARCHITECTS
1649 NO. BROAD STREET PHILADELPHIA, PA.
DATE: 7-JAN.1955
THE GENERAL STATE AUTHORITY
JOHN N. FORKER - EXECUTIVE DIRECTOR
HARRISBURG, PENNSYLVANIA
SCALE: AS NOTED
DWG. No A 10