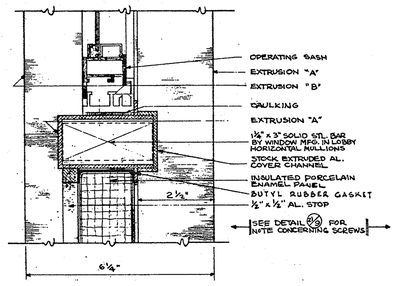

DETAIL 8/11
SCALE: HALF FULL SIZE

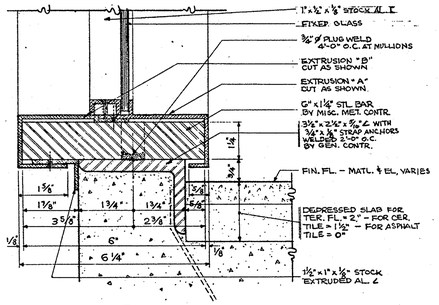

DETAIL 9/11
SCALE: HALF FULL SIZE

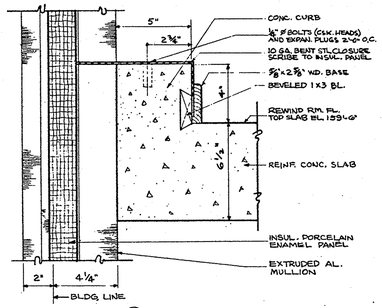

DETAIL 9/11
SCALE: 3" = ONE FOOT

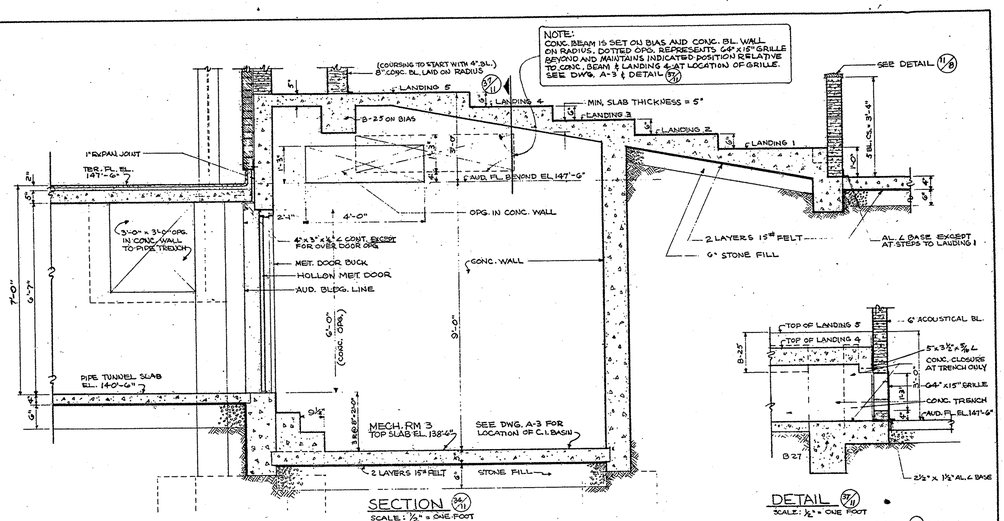



(GRILLE DETAIL AT COL. (65) SIMILAR EXCEPT AT OPPOSITE HAND)

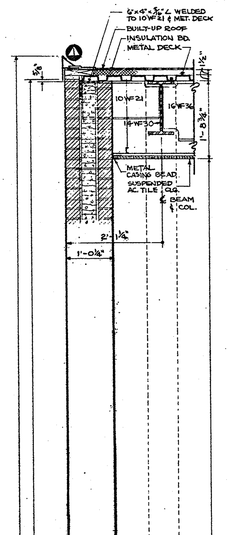

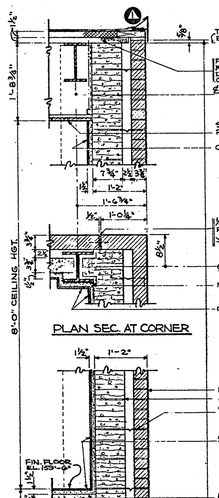

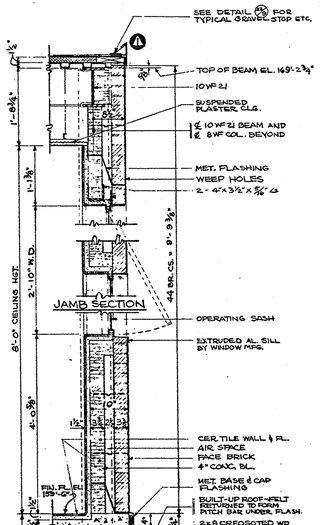

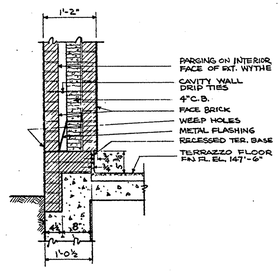

DETAIL 8/11
SCALE: 3/4" = ONE FOOT

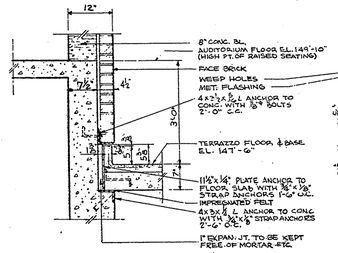

DETAIL 8/11
SCALE: 3/4" = ONE FOOT

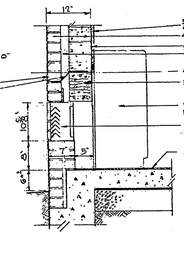

DETAIL 8/11
SCALE: 3/4" = ONE FOOT

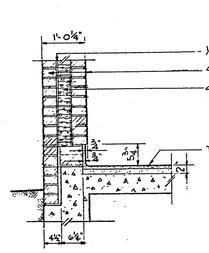

DETAIL 8/11
SCALE: 3/4" = ONE FOOT

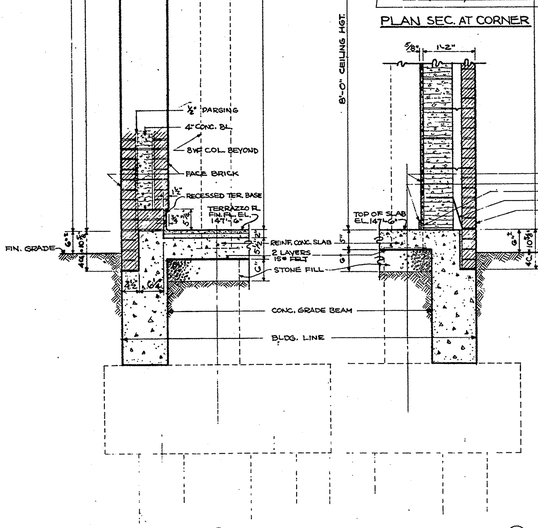

SECTION 9/11
SCALE: 3/4" = ONE FOOT

SECTION 9/11
SCALE: 3/4" = ONE FOOT

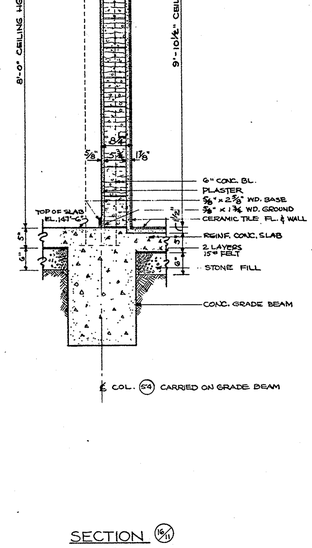

SCALE: 3/4" = ONE FOOT

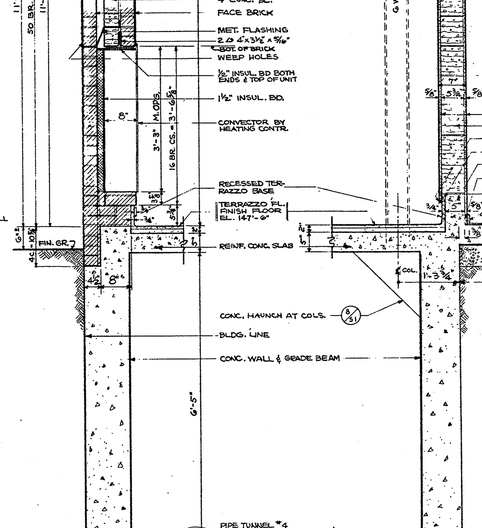

SECTION 12/11
SCALE: 3/4" = ONE FOOT

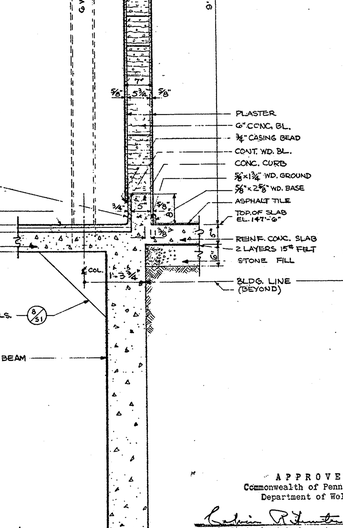

SECTION 9/11
SCALE: 3/4" = ONE FOOT

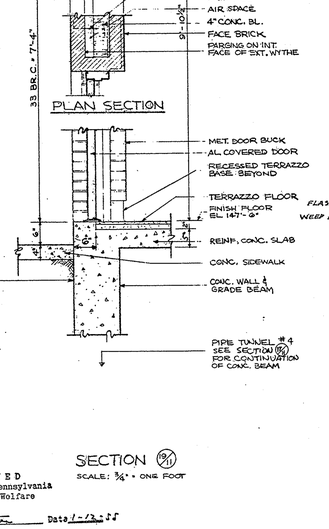

SCALE: 3/4" = ONE FOOT

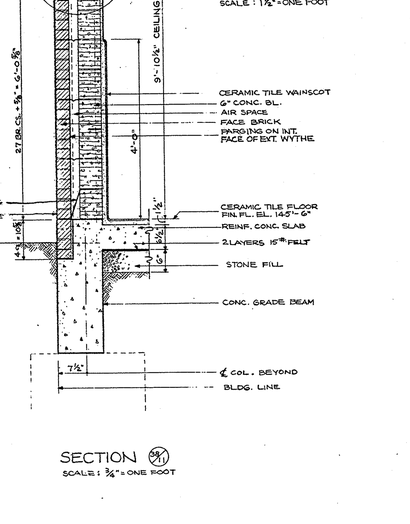

DETAIL 9/11
SCALE: 1 1/2" = ONE FOOT

SECTION 9/11
SCALE: 3/4" = ONE FOOT

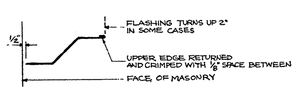

MET. WALL FLASHING DETAIL
DIAGRAMATIC SECTION

APPROVED
Commonwealth of Pennsylvania
Department of Welfare
Registered Architect — Date 1-13-55
Secretary — Date

NOTE: ALL DIMENSIONS & EXISTING CONDITIONS SHALL BE CHECKED & VERIFIED BY THE CONTRACTOR AT THE SITE.

REVISED
AS BUILT JAN. 29, 1957

John A. Nolen Jr. — ARCHITECT
ENGINEER
INSTITUTION
SUPERVISING ARCHITECT G.S.A.

CHECKED BY THE GENERAL STATE AUTHORITY

ARCH.	STRUCT.	HEAT.	PLUMB.	ELECT.
R.H.S. 2-14-55				
ELEVATORS	KITCH. EQ.	L'DRY. EQ.	HOSP. EQ.	MISC.

PROJECT No GSA—510-12
PHILA. STATE HOSPITAL
PHILADELPHIA PENNSYLVANIA
CHAPEL & AUDITORIUM BUILDING
WALL SECTIONS
NOLEN & SWINBURNE — REGISTERED ARCHITECTS
1649 NO. BROAD STREET PHILADELPHIA, PA.

DATE: 7 JAN. 1955
THE GENERAL STATE AUTHORITY
JOHN N. FORKER - EXECUTIVE DIRECTOR
SCALE: AS NOTED
HARRISBURG, PENNSYLVANIA
DWG. No A 11