APPROVED
Commonwealth of Pennsylvania
Department of Welfare
Date 1-12-55
Registered Architect
Date
Secretary

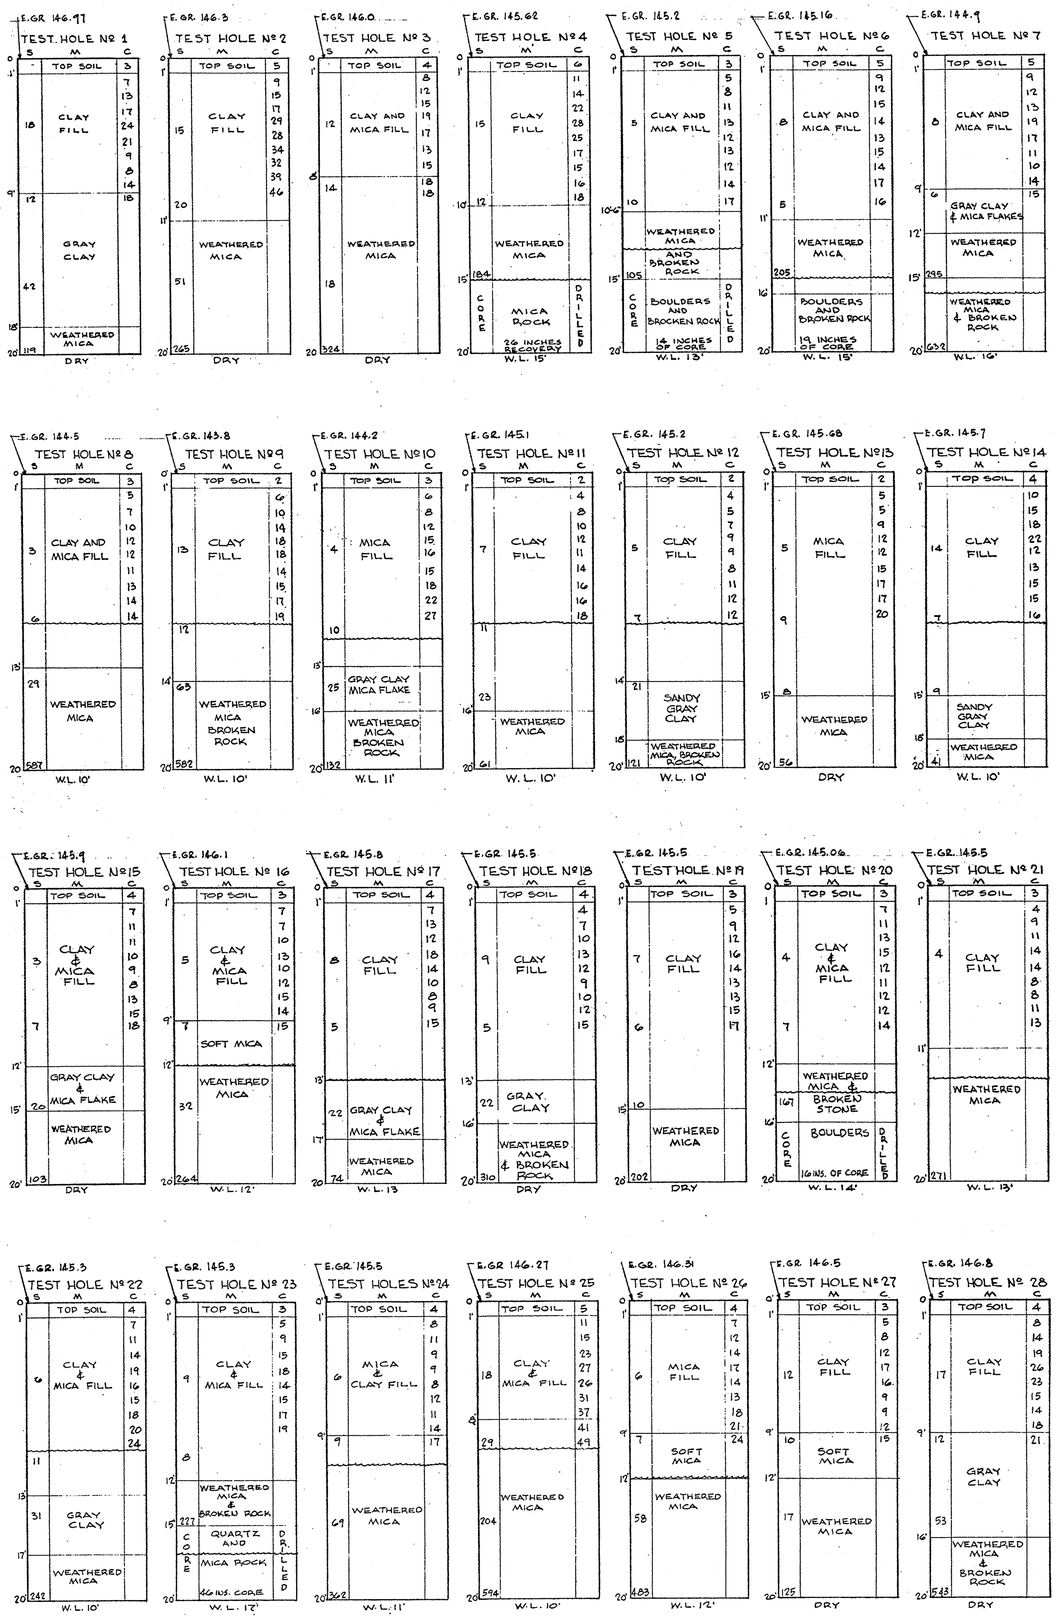

CORE BORING DATA

SCALE 1/4" = 1'-0"

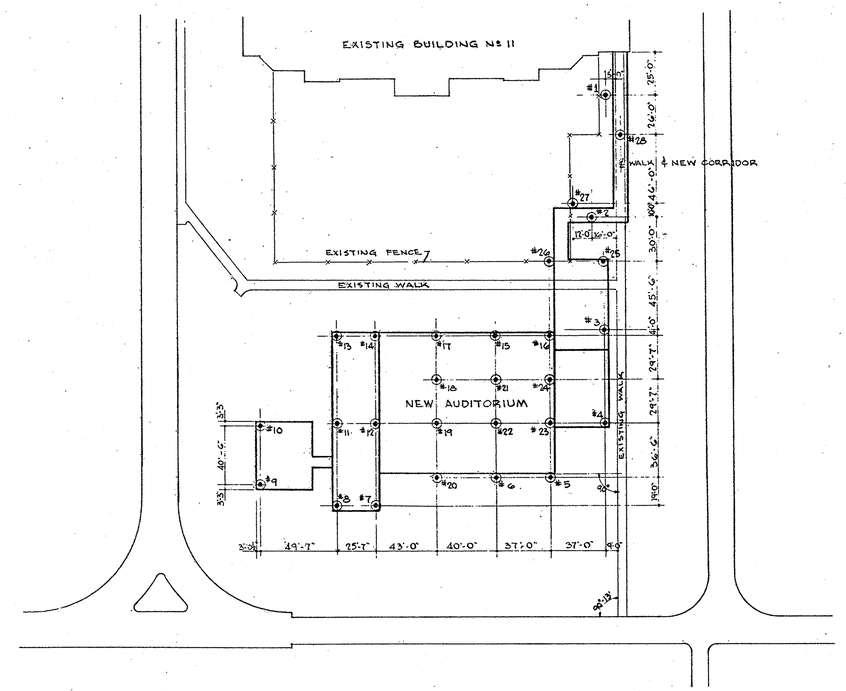

TEST BORING PLAN

SCALE 1" = 40'-0"

LEGEND

250 POUND DROP HAMMER
18 INCH DROP
3 INCH CASING
2 1/2 INCH SAMPLE TUBE
B.X. DIAMOND BIT
S---- SAMPLE BLOWS & CORE RECOVERY
M--- MATERIAL
C---- CASING BLOWS
W.L.-- WATER LINE
⊙ TEST HOLE

NOTE

TEST BORINGS HERE INDICATED WERE TAKEN BETWEEN THE DATES OF 9-24-54 TO 10-4-54 BY RIDPATH & POTTER CO., PHILA., PENNA. THE WATER LEVELS INDICATED ARE FOR THESE DATES ONLY AND NO RESPONSIBILITY IS ASSUMED FOR THE ACCURACY OF THE INFORMATION AT ANY TIME OTHER THAN THE DATES OF ACTUAL BORINGS.

ALL DIMENSIONS & EXISTING CONDITIONS SHALL BE CHECKED & VERIFIED BY THE CONTRACTOR AT THE SITE

APPROVED
Commonwealth of Pennsylvania
Department of Welfare
Date 1-12-55
Registered Architect
Date
Secretary

REGISTERED ARCHITECT JOHN A. NOLEN, JR. No. 3-1791
REGISTERED ARCHITECT JOHN N. SWINBURNE No. 3-1777

REVISED
AS BUILT 1-29-57

ARCHITECT
ENGINEER
INSTITUTION
SUPERVISING ARCHITECT GSA

CHECKED BY THE GENERAL STATE AUTHORITY

ARCH. R.H.D. 2-14-55	STRUCT. J.P.R. 2-14-55	HEAT.	PLUMB.	ELECT.
ELEVATORS	KITCH. EQ.	L'DRY. EQ.	HOSP. EQ.	MISC.

PROJECT No GSA — 510-12

PHILA. STATE HOSPITAL

PHILADELPHIA PENNSYLVANIA

CHAPEL & AUDITORIUM BUILDING

CORE BORING PLAN & DATA

NOLEN & SWINBURNE — REGISTERED ARCHITECTS
1649 NO. BROAD STREET PHILADELPHIA, PA.

DATE: 7 JAN. 1955
SCALE: AS NOTED
THE GENERAL STATE AUTHORITY
JOHN N. FORKER - EXECUTIVE DIRECTOR
HARRISBURG, PENNSYLVANIA
DWG. No TB 1