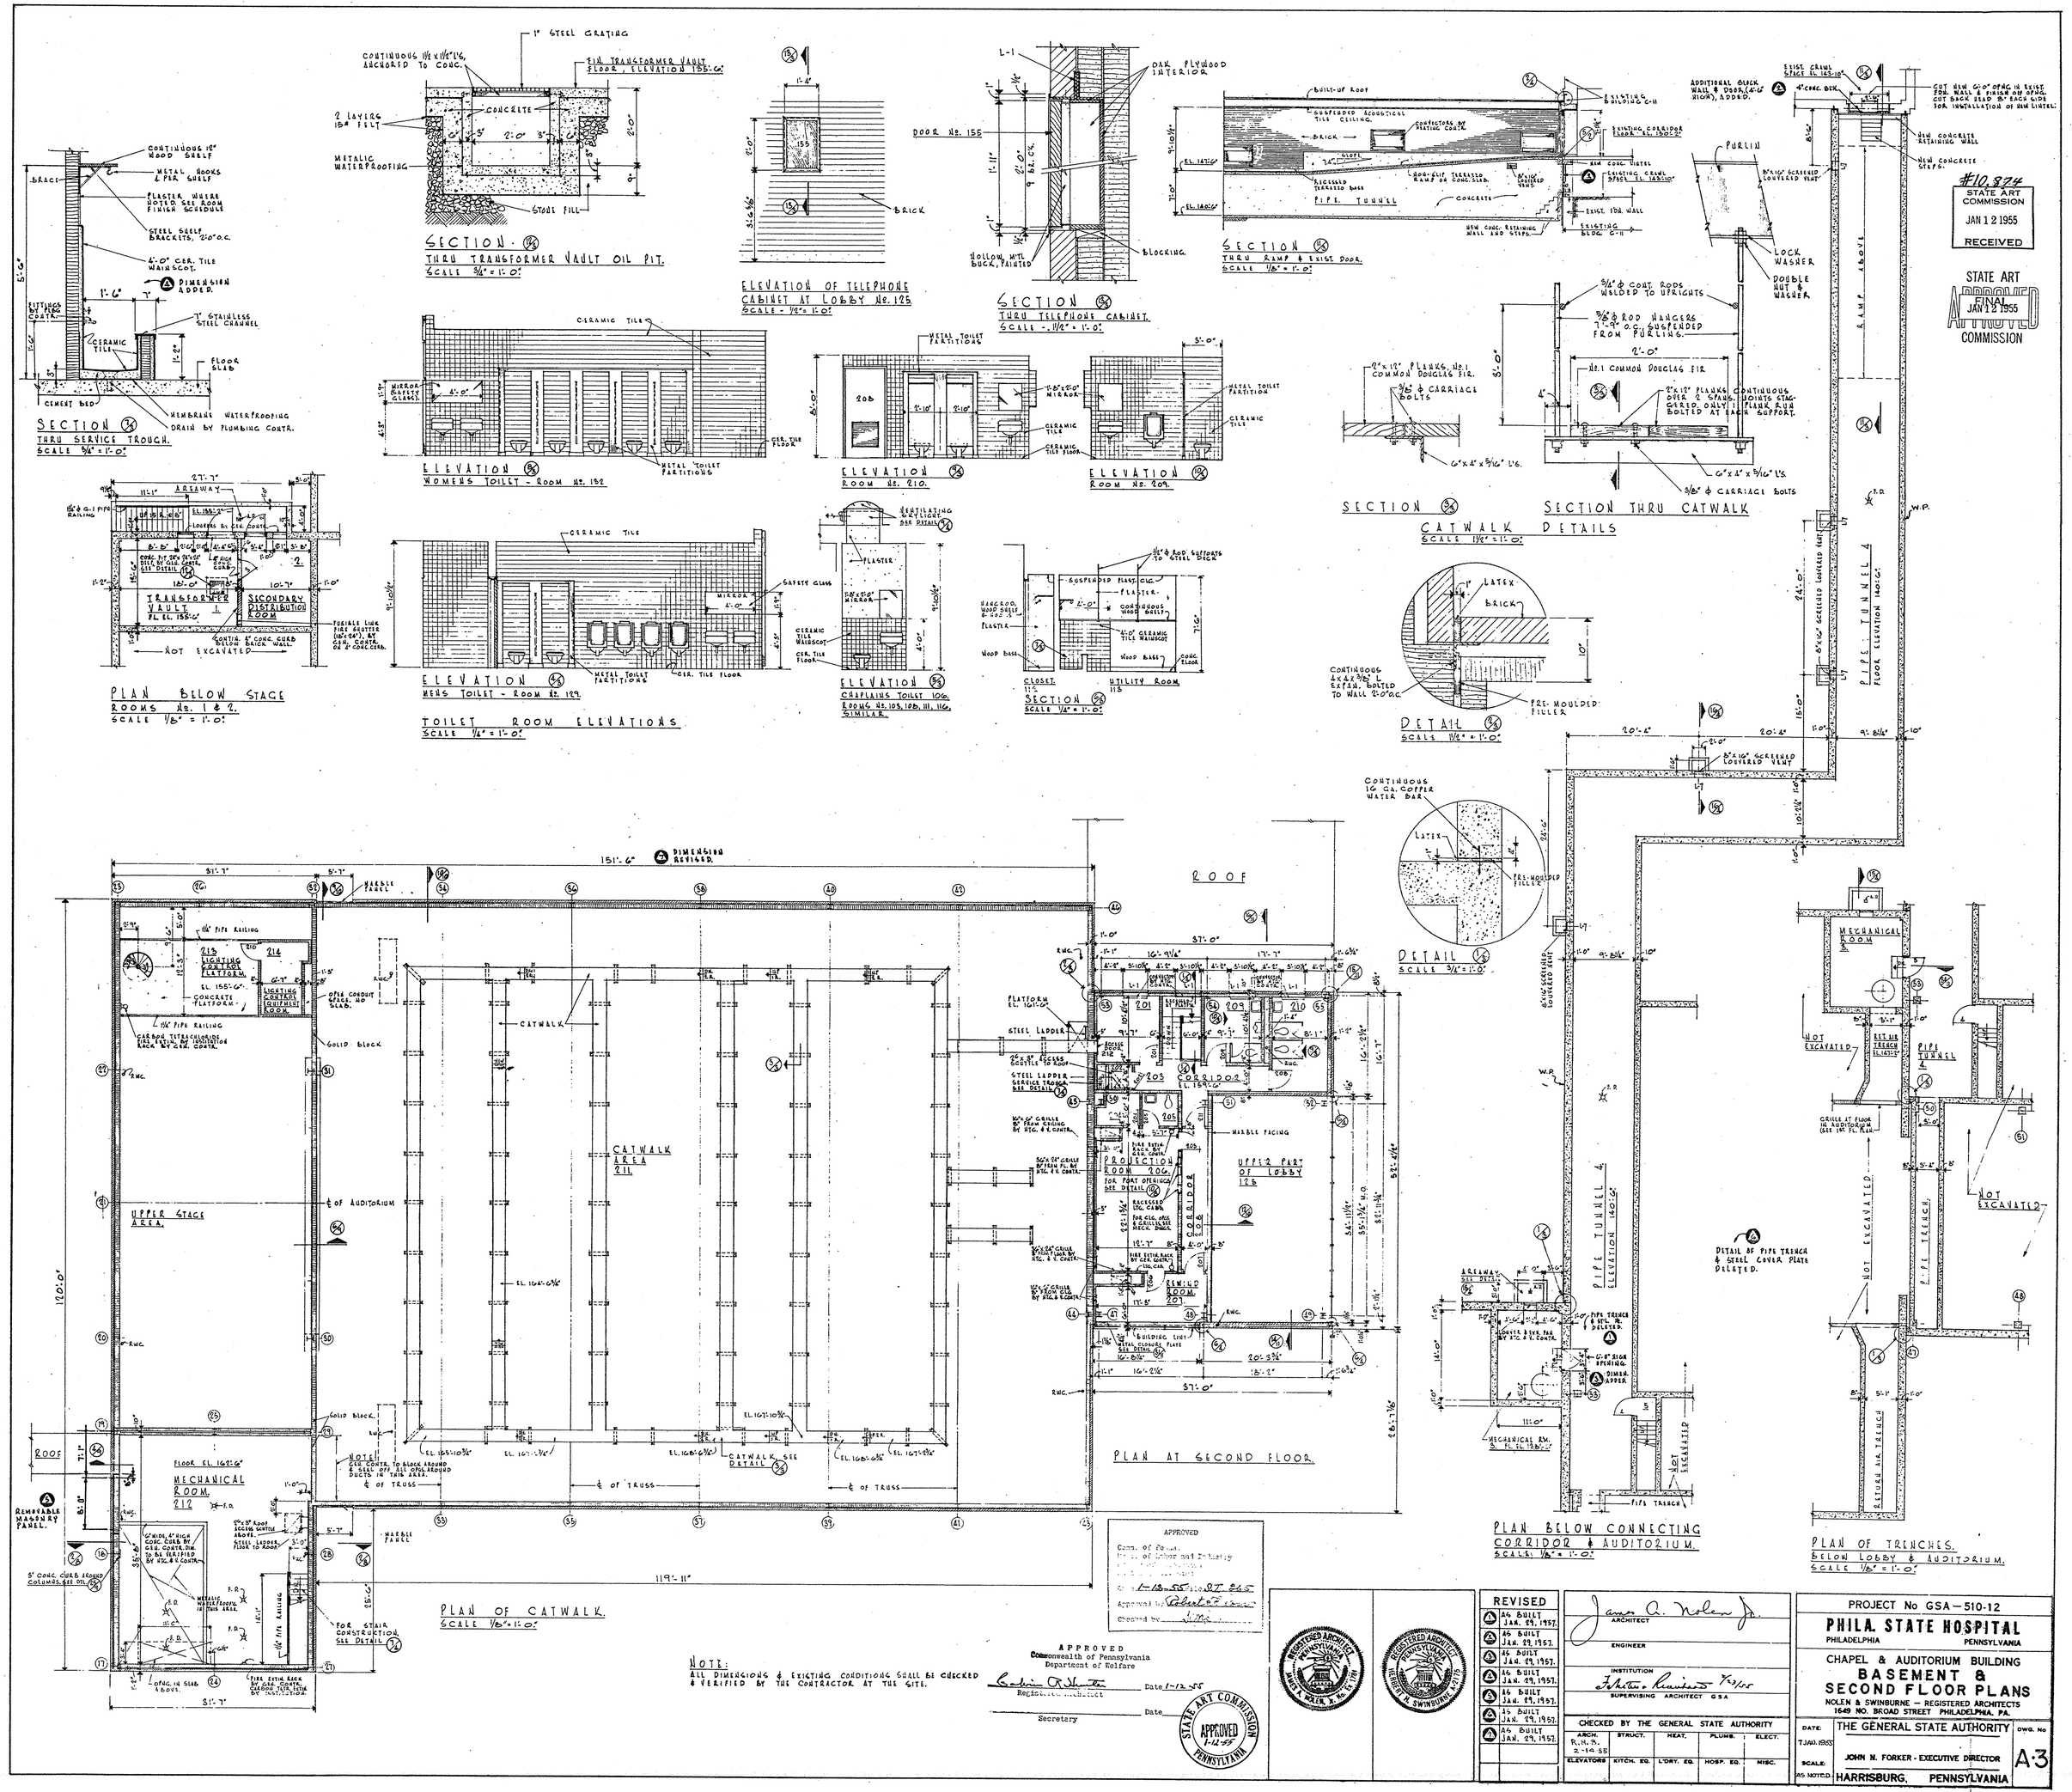
SECTION
THRU SERVICE TROUGH.
SCALE 3/4" = 1'-0"
SECTION
THRU TRANSFORMER VAULT OIL PIT.
SCALE 3/4" = 1'-0"
ELEVATION OF TELEPHONE CABINET AT LOBBY No. 125
SCALE - 1/2" = 1'-0"
SECTION
THRU TELEPHONE CABINET.
SCALE - 1 1/2" = 1'-0"
SECTION
THRU RAMP & EXIST. DOOR.
SCALE 1/8" = 1'-0"
SECTION
CATWALK DETAILS
SCALE 1 1/2" = 1'-0"
SECTION THRU CATWALK
DETAIL
SCALE 1 1/2" = 1'-0"
DETAIL
SCALE 3/4" = 1'-0"
ELEVATION
WOMENS TOILET - ROOM No. 132
ELEVATION
ROOM No. 210.
ELEVATION
ROOM No. 209.
ELEVATION
MENS TOILET - ROOM No. 129.
ELEVATION
CHAPLAINS TOILET 106.
ROOMS No. 105, 108, 111, 116, SIMILAR.
SECTION
CLOSET 112 — UTILITY ROOM 113
SCALE 1/4" = 1'-0"
TOILET ROOM ELEVATIONS
SCALE 1/4" = 1'-0"
PLAN BELOW STAGE
ROOMS No. 1 & 2.
SCALE 1/8" = 1'-0"
PLAN OF CATWALK.
SCALE 1/8" = 1'-0"
PLAN AT SECOND FLOOR
PLAN BELOW CONNECTING CORRIDOR & AUDITORIUM.
SCALE: 1/8" = 1'-0"
PLAN OF TRENCHES.
BELOW LOBBY & AUDITORIUM.
SCALE 1/8" = 1'-0"
#10,374
STATE ART COMMISSION
JAN 12 1955
RECEIVED
STATE ART
APPROVED
FINAL
JAN 12 1955
COMMISSION
APPROVED
Comm. of Penna.
Dept. of Labor and Industry
Approval by
Checked by
APPROVED
Commonwealth of Pennsylvania
Department of Welfare
Registered Architect
Secretary
Date 1-12-55
STATE ART COMMISSION
APPROVED
1-12-55
PENNSYLVANIA
NOTE:
ALL DIMENSIONS & EXISTING CONDITIONS SHALL BE CHECKED & VERIFIED BY THE CONTRACTOR AT THE SITE.
REGISTERED ARCHITECT PENNSYLVANIA
REVISED
4 AS BUILT JAN. 29, 1957.
ARCHITECT
ENGINEER
INSTITUTION
SUPERVISING ARCHITECT GSA
CHECKED BY THE GENERAL STATE AUTHORITY
ARCH. R.H.S. 2-14-55
STRUCT.
HEAT.
PLUMB.
ELECT.
ELEVATORS
KITCH. EQ.
L'DRY. EQ.
HOSP. EQ.
MISC.
PROJECT No GSA—510-12
PHILA. STATE HOSPITAL
PHILADELPHIA PENNSYLVANIA
CHAPEL & AUDITORIUM BUILDING
BASEMENT & SECOND FLOOR PLANS
NOLEN & SWINBURNE — REGISTERED ARCHITECTS
1649 NO. BROAD STREET PHILADELPHIA, PA.
DATE: JAN. 1955
SCALE: AS NOTED
THE GENERAL STATE AUTHORITY
JOHN N. FORKER - EXECUTIVE DIRECTOR
HARRISBURG, PENNSYLVANIA
DWG. No A-3