#10,874
STATE ART COMMISSION
JAN 12 1955
RECEIVED

STATE ART
APPROVED
FINAL
JAN 12 1955
COMMISSION

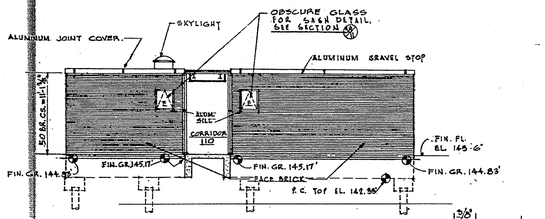

ELEVATION 5.
SCALE 1/8" = 1'-0"

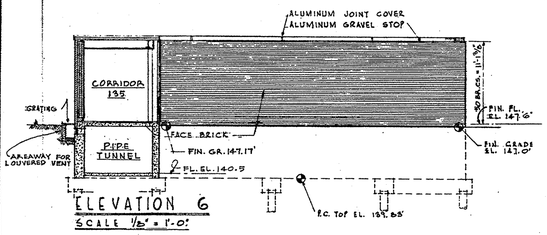

ELEVATION 6
SCALE 1/8" = 1'-0"

ELEVATION OF DATE STONE
SCALE 3" = 1'-0"

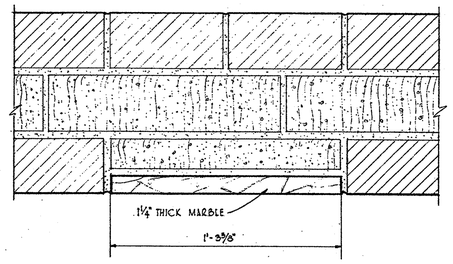

PLAN.

DETAIL OF DATE STONE (1/6)

ACTUAL YEAR TO BE VERIFIED

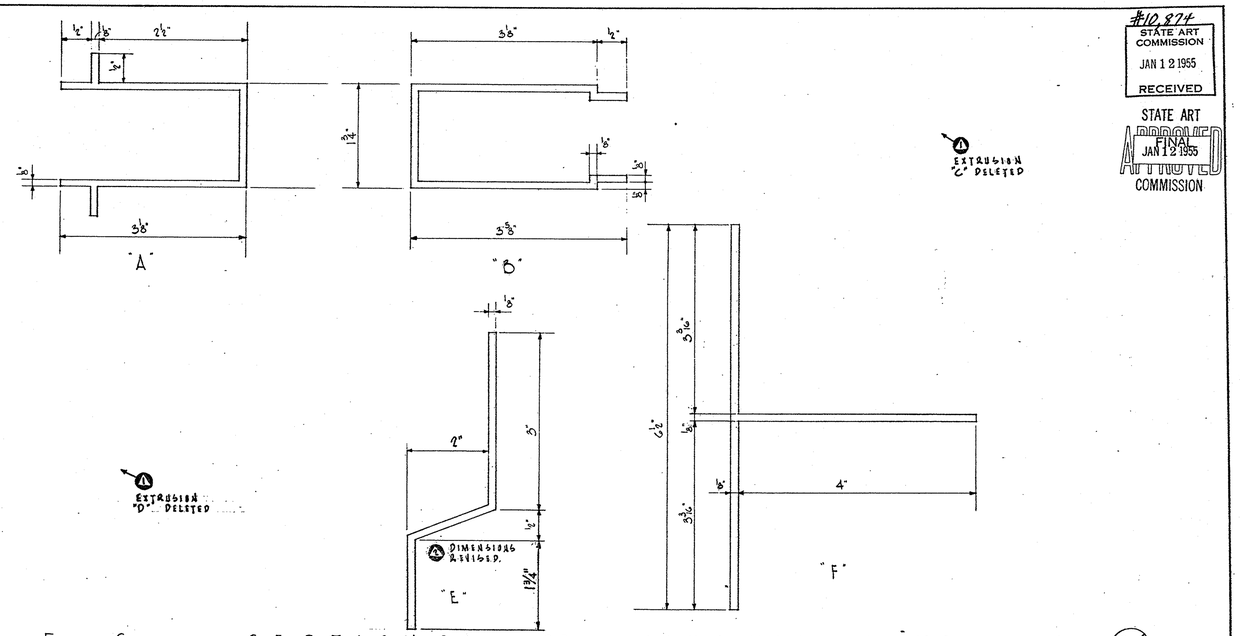

F. S. SECTIONS OF ALUMINUM EXTRUSIONS (2/6)

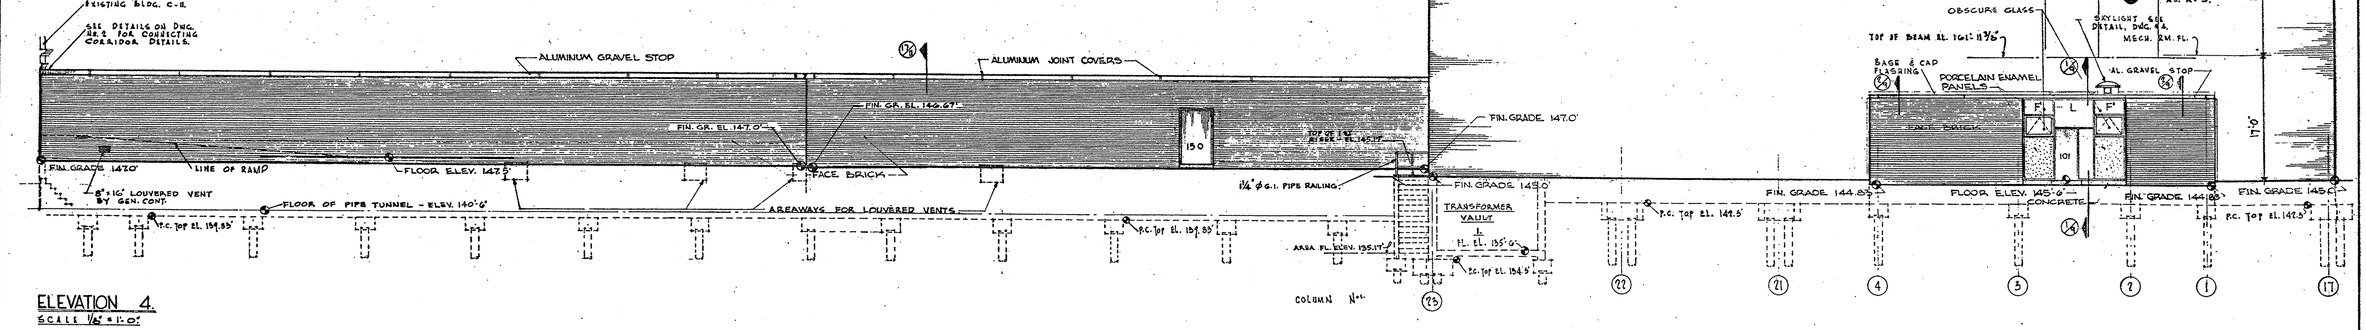

ELEVATION 4.
SCALE 1/8" = 1'-0"

ELEVATION 1.
SCALE 1/8" = 1'-0"

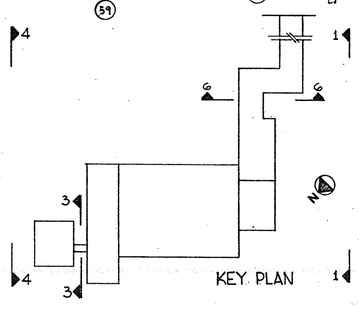

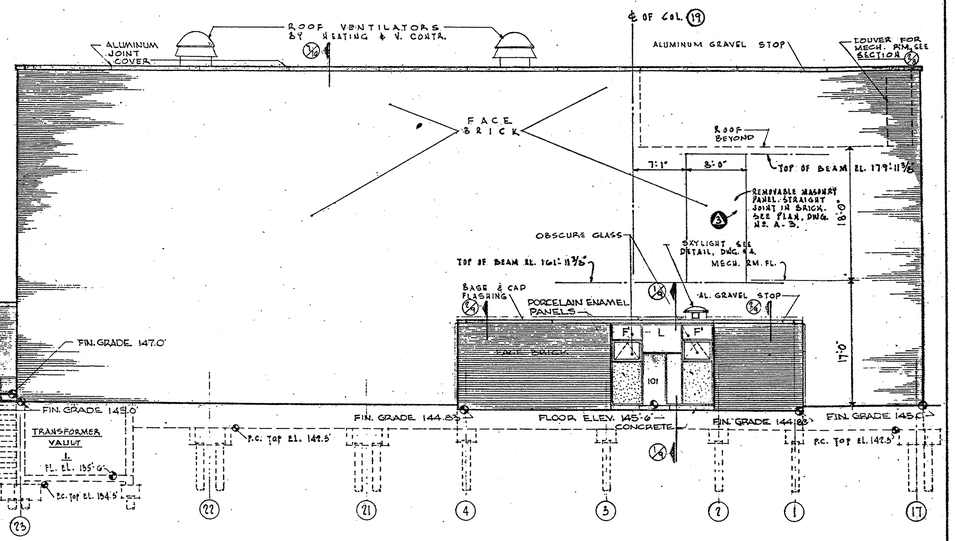

APPROVED
Comm. of Penna.
Dept. of Labor and Industry
Bureau of Inspection
Buildings Division
Date 1-12-55 File S.T. 245
Approved by Robert F. Poor
Checked by MMS

EXISTING C-II BLDG.
SEE DETAILS ON SHEET-2 FOR CONNECTING CORRIDOR DETAILS

STATE ART COMMISSION APPROVED 1-12-55 PENNSYLVANIA

APPROVED
Commonwealth of Pennsylvania
Department of Welfare
Date 1-12-55
Registered Architect

NOTE / ALL DIMENSIONS AND EXISTING CONDITIONS SHALL BE CHECKED AND VERIFIED BY THE CONTRACTOR AT THE SITE.

REVISED
(1) As Built Jan. 29, 1957
(2) As Built Jan. 29, 1957
(3) As Built Jan. 29, 1957

Date
ARCHITECT
ENGINEER
INSTITUTION
SUPERVISING ARCHITECT GSA

CHECKED BY THE GENERAL STATE AUTHORITY

ARCH. R.M.S. 2-14-55	STRUCT.	HEAT.	PLUMB.	ELECT.
ELEVATORS	KITCH. EQ.	L'DRY. EQ.	HOSP. EQ.	MISC.

PROJECT No GSA — 510-12
PHILA. STATE HOSPITAL
PHILADELPHIA PENNSYLVANIA
CHAPEL & AUDITORIUM BUILDING
ELEVATIONS & DETAILS
NOLEN & SWINBURNE — REGISTERED ARCHITECTS
1649 NO. BROAD STREET PHILADELPHIA, PA.

DATE: 7 JAN 1955
SCALE: AS NOTED
THE GENERAL STATE AUTHORITY
JOHN N. FORKER - EXECUTIVE DIRECTOR
HARRISBURG, PENNSYLVANIA
DWG. No. A-6