#10,874
STATE ART COMMISSION
JAN 12 1955
RECEIVED
STATE ART
FINAL
JAN 12 1955
APPROVED
COMMISSION

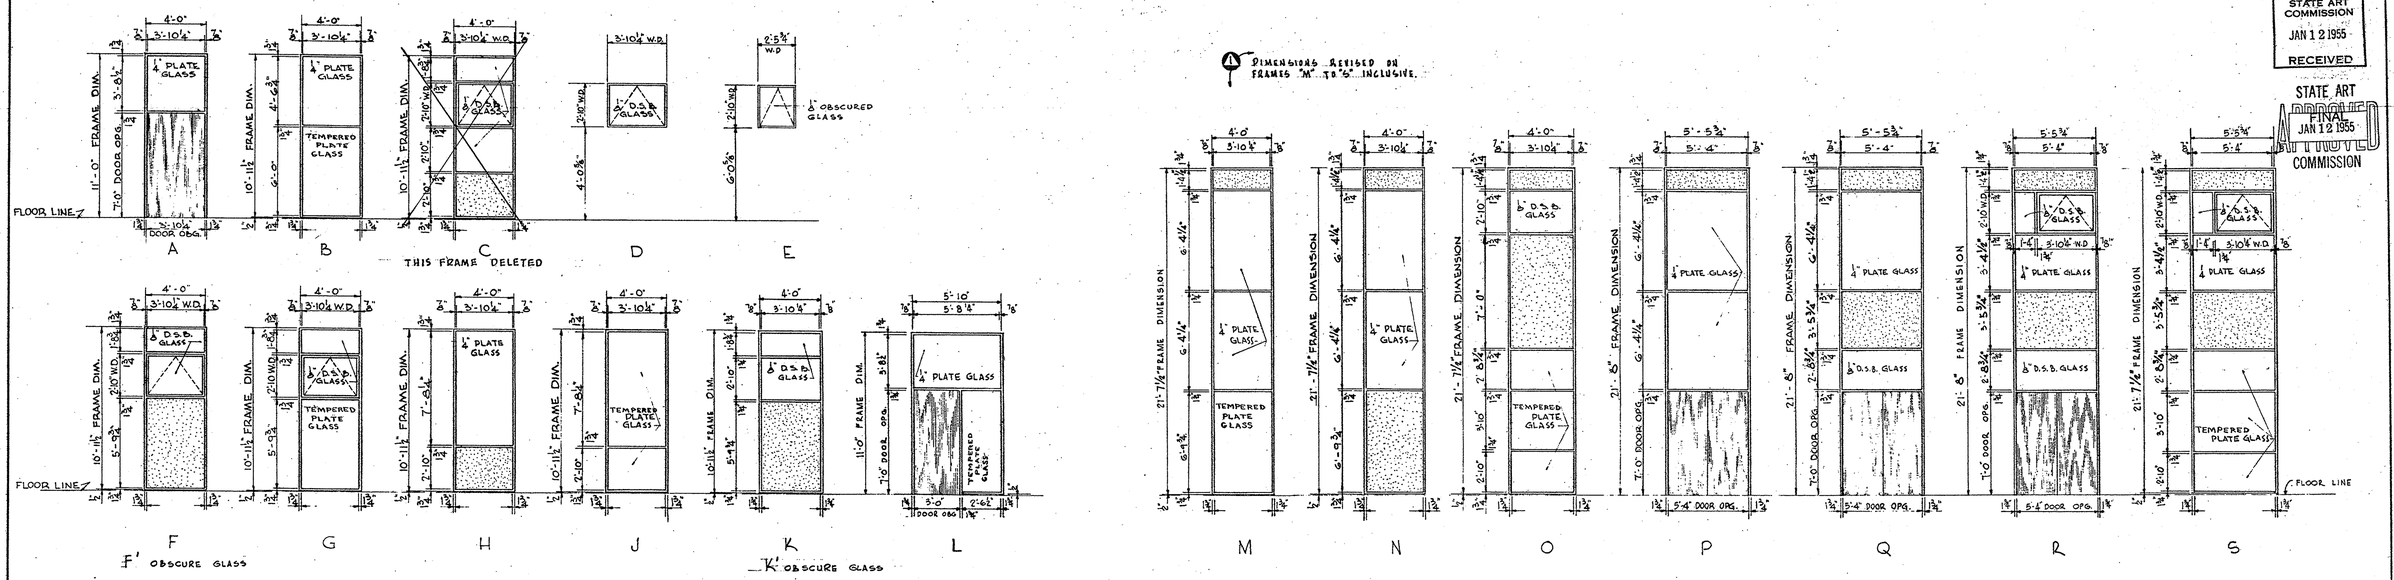

EXTRUDED ALUMINUM FRAMES & WINDOW SCHEDULE

SCALE 1/4" = 1'-0"

NOTES:

SEE ELEVATIONS FOR OBSCURE GLASS LOCATIONS

= PORCELAIN ENAMEL PANEL

FRAMES SHOWN ON THIS SCHEDULE HAVE THEIR JAMB MEMBERS IN COMMON WITH THE ADJOINING FRAMES AS SHOWN IN THE ELEVATIONS.

ALL VERTICAL EXTRUDED MEMBERS ARE TO BE CONT. WITHOUT JOINTS FOR THE FULL HEIGHT OF THE FRAMES

THESE FRAMES ARE CONSTRUCTED OF THE EXTRUDED ALUMINUM SHAPES SHOWN ON SHEET NO. A-6

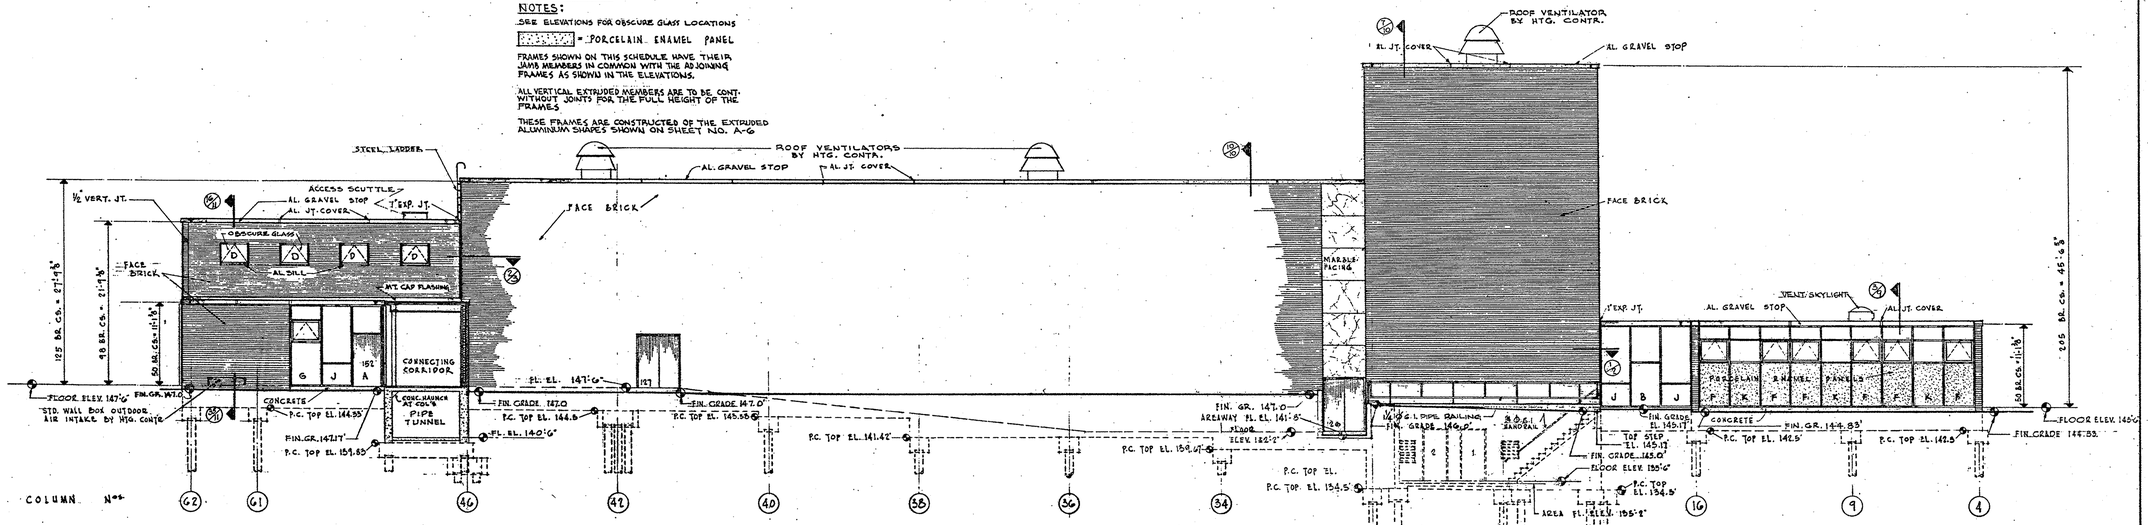

ELEVATION 5

SCALE 1/8" = 1'-0"

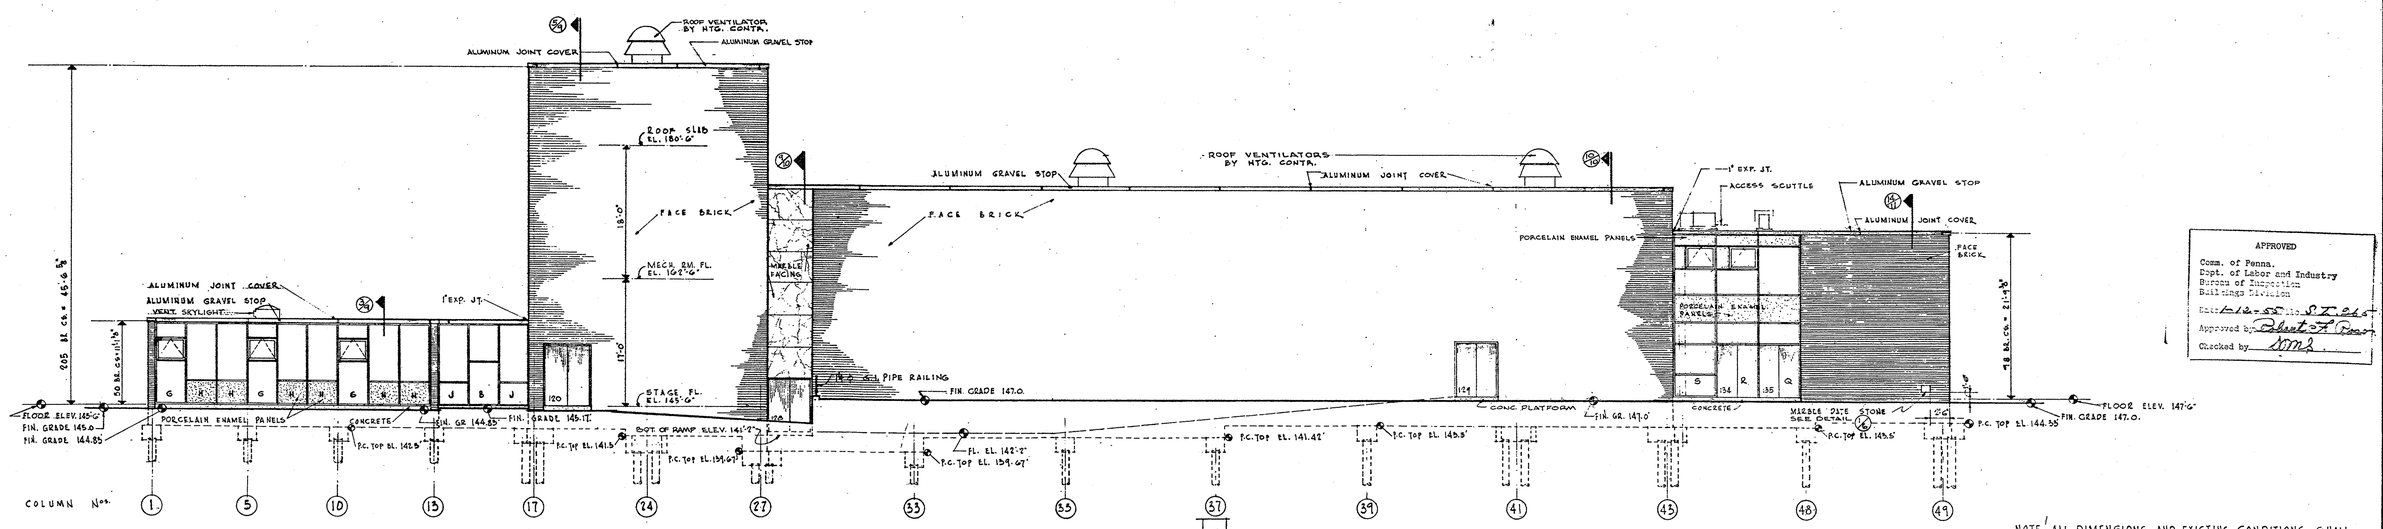

ELEVATION 2

SCALE 1/8" = 1'-0"

NOTE! ALL DIMENSIONS AND EXISTING CONDITIONS SHALL BE CHECKED AND VERIFIED BY THE CONTRACTOR AT THE SITE

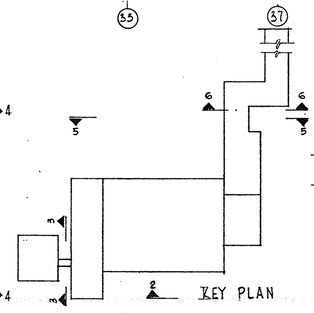

KEY PLAN

APPROVED
Commonwealth of Pennsylvania
Department of Welfare

Robin R. Shuster 1-12-55
Registered Architect Date

Secretary Date

STATE ART COMMISSION APPROVED 1-12-55 PENNSYLVANIA

REGISTERED ARCHITECT PENNSYLVANIA JAMES A. NOLEN & SON No. 5411

REGISTERED ARCHITECT PENNSYLVANIA NORMAN M. SWINBURNE, JR. No. 5412

REVISED	
1	AS BUILT JAN. 29, 1957.

James A. Nolen Jr.
ARCHITECT

ENGINEER

INSTITUTION
J. Stitt Rainey 7/2/55
SUPERVISING ARCHITECT GSA

CHECKED BY THE GENERAL STATE AUTHORITY

ARCH. R.H.B. 2-14-55	STRUCT.	HEAT.	PLUMB.	ELECT.
ELEVATORS	KITCH. EQ.	L'DRY. EQ.	HOSP. EQ.	MISC.

PROJECT No GSA—510-12

PHILA. STATE HOSPITAL
PHILADELPHIA PENNSYLVANIA

CHAPEL & AUDITORIUM BUILDING

ELEVATIONS & DETAILS

NOLEN & SWINBURNE — REGISTERED ARCHITECTS
1649 NO. BROAD STREET PHILADELPHIA, PA.

DATE: 7 JAN. 1955
SCALE: AS NOTED

THE GENERAL STATE AUTHORITY
JOHN N. FORKER - EXECUTIVE DIRECTOR
HARRISBURG, PENNSYLVANIA

DWG. No A-7

APPROVED
Comm. of Penna.
Dept. of Labor and Industry
Bureau of Inspection
Buildings Division
Date 1-12-55 No. S-7-264
Approved by Robert H. Rees
Checked by NMS