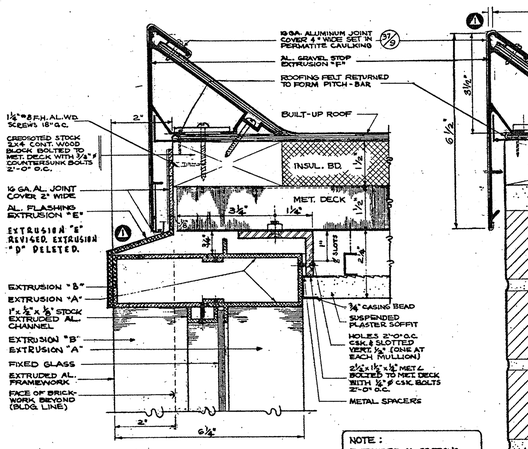

DETAIL 2/9

SCALE: HALF FULL SIZE

NOTE: EXTRUDED AL. SECTIONS ARE FASTENED TOGETHER WITH # 8-32 CSK. AL. MACH. SCREWS 12" O.C. — ALL APPLIED STOPS # 6-32 JACKSON HEAD MACH SCREWS 12" O.C.

NOTE: SEE DETAIL 2/9 FOR ALL EXTRUDED ALUMINUM SHAPES AND DIMENSIONS.

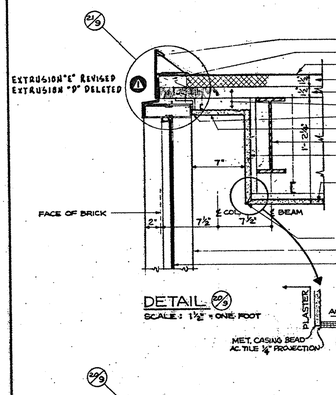

DETAIL 2/9

SCALE: 1 1/2" = ONE FOOT

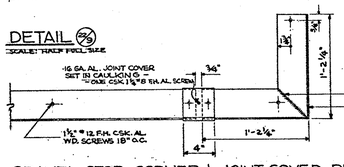

DETAIL 2/9

SCALE: HALF FULL SIZE

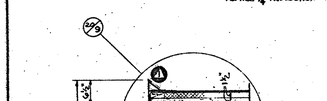

NOTE: AREAS HAVING AC. TILE CLG. USE DET. 2/9 WITH THIS EXCEPTION

GRAVEL STOP CORNER & JOINT COVER DETAIL 3/9

SCALE: 1 1/2" = ONE FOOT

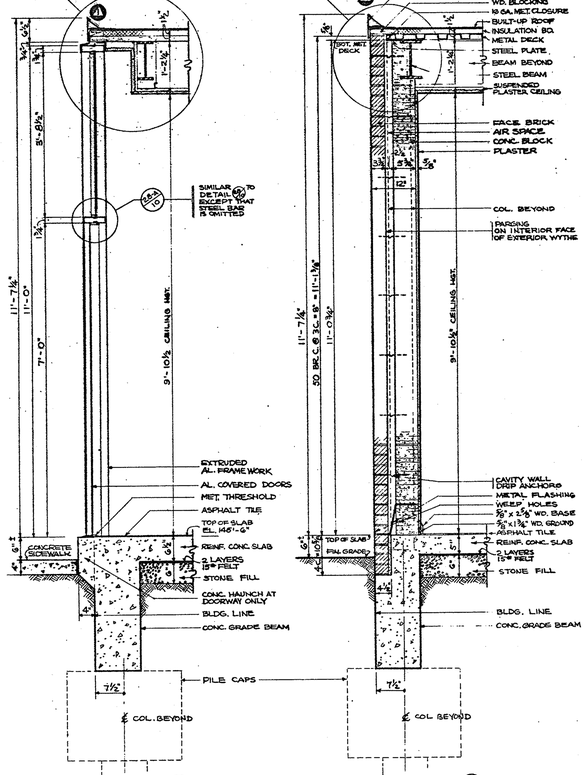

SECTION 1/9

SCALE: 3/4" = ONE FOOT

SECTION 2/9

SCALE: 3/4" = ONE FOOT

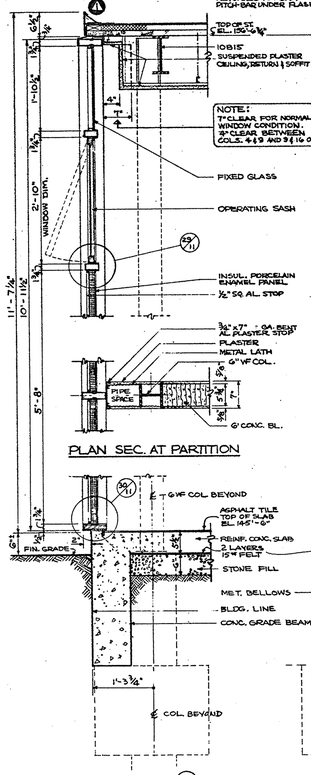

SECTION 3/9

SCALE: 3/4" = ONE FOOT

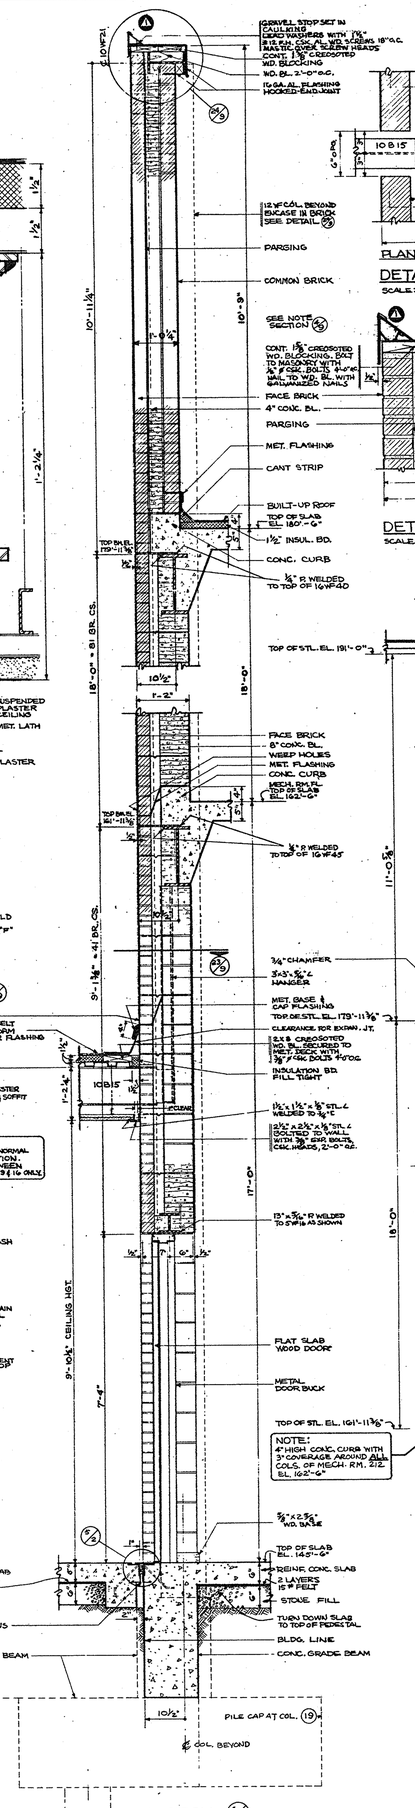

PLAN SECTION

SCALE: 1 1/2" = ONE FOOT

DETAIL 3/9

SCALE: 1 1/2" = ONE FOOT

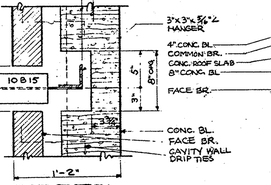

PLAN SECTION DETAIL 3/9

SCALE: 1 1/2" = ONE FOOT

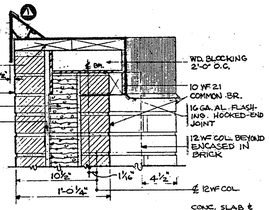

DETAIL 3/9

SCALE: 1 1/2" = ONE FOOT

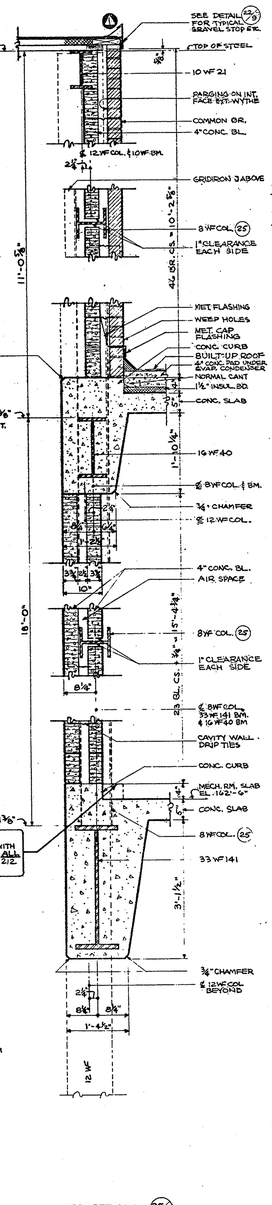

SECTION 4/9

SCALE: 3/4" = ONE FOOT

SECTION 25/9

SCALE: 3/4" = ONE FOOT

SECTION 5/9

SCALE: 3/4" = ONE FOOT

SECTION 6/9

SCALE: 3/4" = ONE FOOT

APPROVED
Commonwealth of Pennsylvania
Department of Welfare
Registered Architect — Date: 12-5-57
Secretary — Date:

REVISED
1 AS BUILT JAN. 29, 1957

James A. Nolen Jr. — ARCHITECT
ENGINEER
INSTITUTION
SUPERVISING ARCHITECT G.S.A.

CHECKED BY THE GENERAL STATE AUTHORITY

ARCH.	STRUCT.	HEAT.	PLUMB.	ELECT.
R.H.B. 2-14-55				
ELEVATORS	KITCH. EQ.	L'DRY. EQ.	HOSP. EQ.	MISC.

NOTE: ALL DIMENSIONS & EXISTING CONDITIONS SHALL BE CHECKED & VERIFIED BY THE CONTRACTOR AT THE SITE.

PROJECT No GSA—510-12

PHILA. STATE HOSPITAL

PHILADELPHIA PENNSYLVANIA

CHAPEL & AUDITORIUM BUILDING

WALL SECTIONS

NOLEN & SWINBURNE — REGISTERED ARCHITECTS
1649 NO. BROAD STREET PHILADELPHIA, PA.

DATE: 1 JAN. 1958

THE GENERAL STATE AUTHORITY

JOHN N. FORKER - EXECUTIVE DIRECTOR

HARRISBURG, PENNSYLVANIA

SCALE: AS NOTED

DWG. No A-9