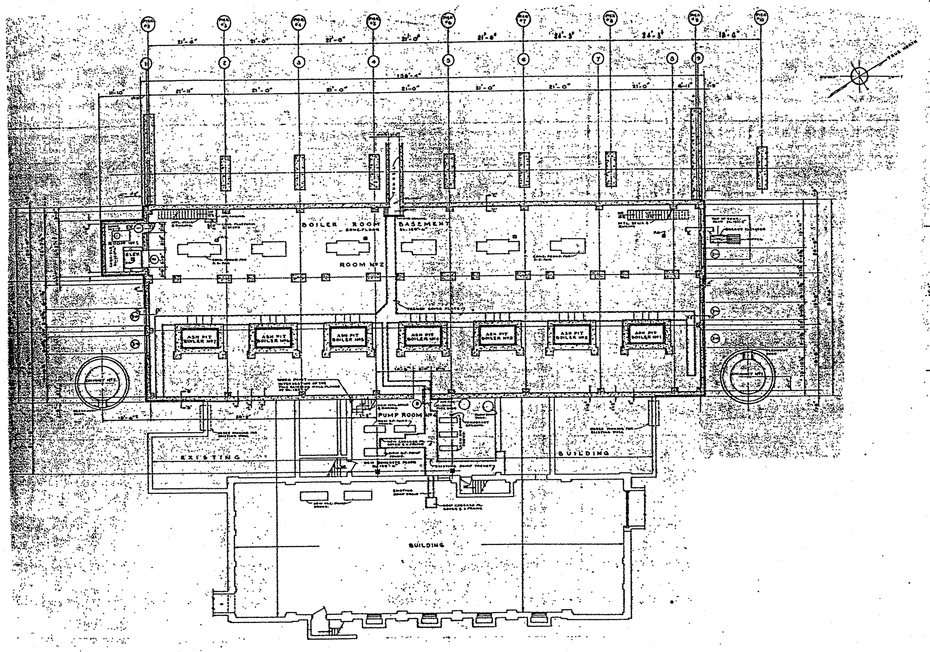

ORIGINAL BSMT. PLAN ⓓ

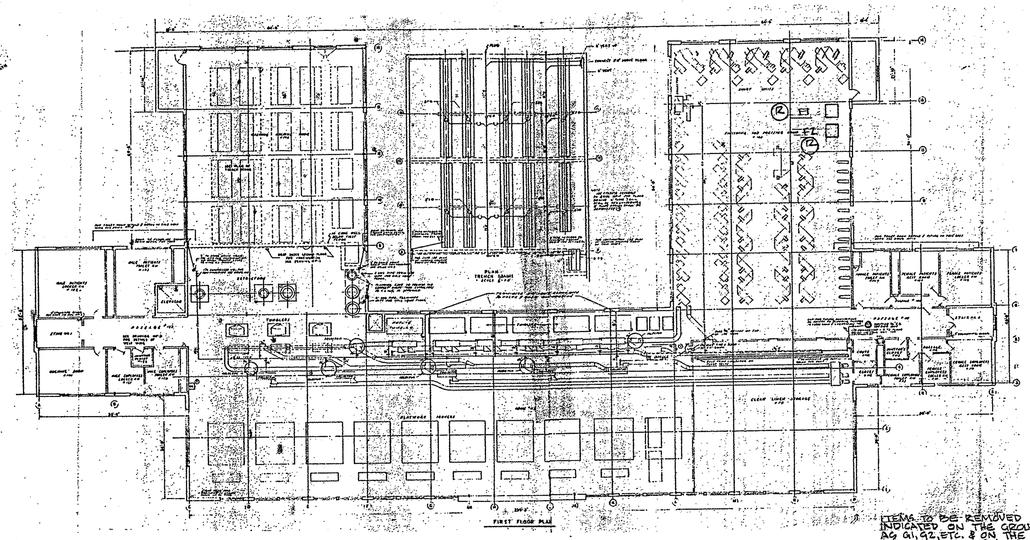

ITEMS TO BE REMOVED ARE INDICATED ON THE GROUND FLOOR AS G1, G2 ETC. & ON THE FIRST FLOOR AS F1, F2, BY AN 8"x 8" SPRAY OF FLUORESCENT ORANGE PAINT. VERIFY EXACT LOCATIONS OF ITEMS TO BE REMOVED (21 TOTAL).

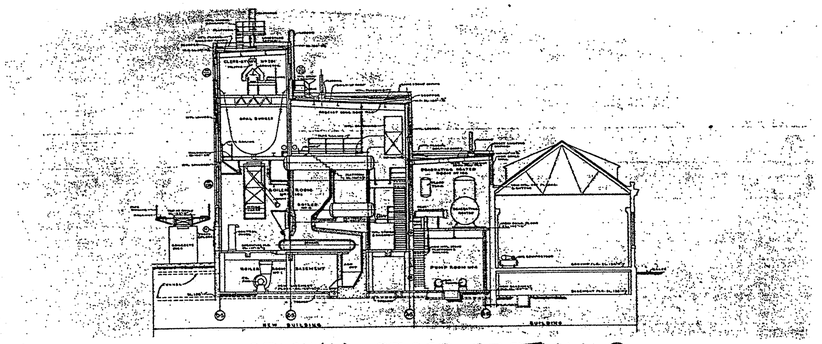

ORIGINAL CROSS-SECTION ⓓ

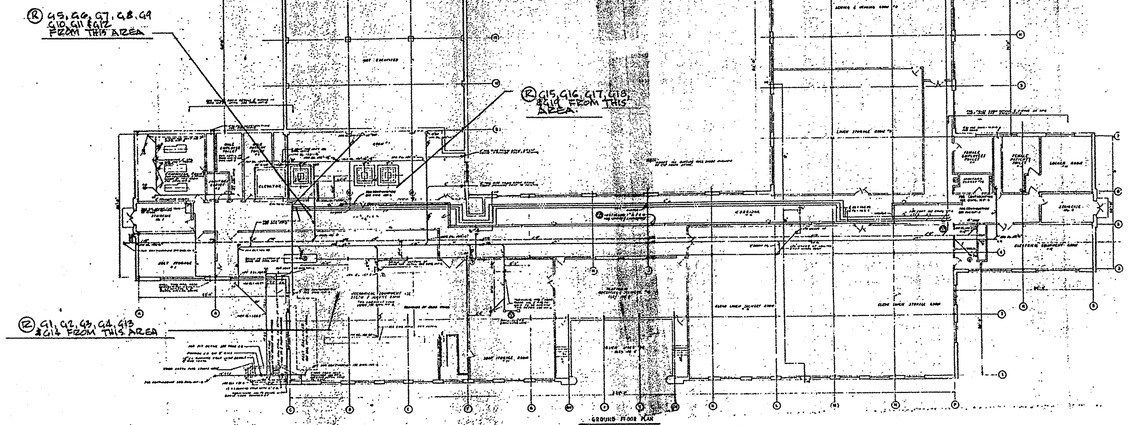

LAUNDRY BLDG FLOOR PLANS

NO SCALE

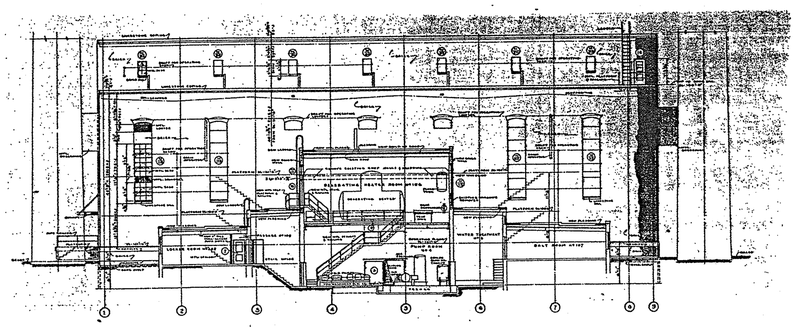

ORIGINAL EAST ELEVATION ⓓ

BOILER PLANT

NO SCALE

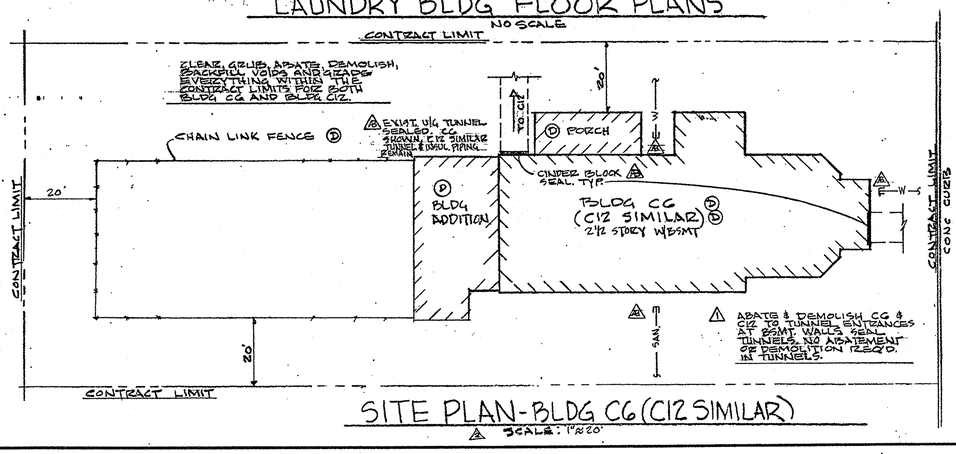

SITE PLAN-BLDG C6 (C12 SIMILAR)

SCALE: 1" = 20'

ALL DIMENSIONS AND MEASUREMENTS SHALL BE CHECKED AND VERIFIED BY THE CONTRACTOR AT THE SITE

REVISIONS					
1	AS PER CPM 1/22/02				
2	REV. PER 3/11/02				
SYMBOL	CORRECTIONS			3	AS BUILT W.J.S. 5/13/02

APPROVALS

APPROVED Thomas Rados PE
DIRECTOR–BUREAU OF ENGINEERING & ARCHITECTURE
APPROVED Joseph R. Mancuso PE
SUPERVISING ENGINEER–BUREAU OF ENGINEERING & ARCHITECTURE
APPROVED
FOR DEPT. OF GENERAL SERVICES
SUBMITTED BY William J. Leach, Jr.
ENG'R

CHECKED BY			
ARCH.	CIVIL & STRUCT.	MECH.	ELECT.

PROJECT NO. DGS 510-35 PH. IV EMERGENCY PROJECT

PLANS, ELEVATION & SECTION

ABATE & DEMOLISH BOILER HOUSE, BLDG. C6 & BLDG. C12
PHILADELPHIA STATE HOSPITAL
PHILADELPHIA, PENNSYLVANIA

BUREAU OF ENGINEERING & ARCHITECTURE
DEPARTMENT OF GENERAL SERVICES

DATE	COMMONWEALTH OF PENNSYLVANIA		SHEET NO.
DEC. 2001	MARK S. SCHWEIKER	GOVERNOR	2
SCALE	DEPT. OF GENERAL SERVICES		OF
AS NOTED	KELLY POWELL LOGAN	SECRETARY OF GENERAL SERVICES	2
	HARRISBURG, PENNSYLVANIA		

3-8-3