FIRST FLOOR MALE WARD WINGS		SCHEDULE OF ROOM FINISHES									
		FLOOR	BASE			WALL	WINDOW	CEILING		BEAM AND GIRDER	REMARKS
SPACE	NUMBER	MATERIAL	MATERIAL	TYPE	HGT.	MATERIAL	STOOL	MATERIAL	TYPE		
ELEVATOR VESTIBULE	1127	TER.	G.T.	COVE	5⅜"	G.T.	N	AC.T.	SUSP.	EXP. CONC.	
LINEN ROOMS	1128-54	TER.	G.T.	COVE	5⅜"	G.T.	N	PAINT CONC.	N	PAINT CONC.	MELT-MELVERS 5⅜" G.T. COVE BASE UNDER SHELVING
MOP ROOMS	1129-55	CER.T.	G.T.	COVE	5⅜"	G.T.	N	PAINT CONC.	N	PAINT CONC.	MEMBRANE W.P. IN FLOOR MARBLE SHELF IN ADJOINING CLOSET.
UTILITY ROOMS	1130-56	CER.T.	G.T.	COVE	5⅜"	G.T.	N	PAINT CONC.	N	PAINT CONC.	MEMBRANE W.P. IN FLOOR SLATE SHELF
TOILETS	1131-57	CER.T.	G.T.	COVE	5⅜"	G.T.	N	PAINT CONC.	N	PAINT CONC.	MEMBRANE W.P. IN FLOOR MARBLE TOILET PAR.
WASH ROOMS	1132-58	CER.T.	G.T.	COVE	5⅜"	G.T.	N	PAINT CONC.	N	PAINT CONC.	MEMBRANE W.P. IN FLOOR MARBLE SHELF MIRRORS
UNDRESSING ROOMS	1133-59	CER.T.	G.T.	COVE	5⅜"	G.T.	N	PAINT CONC.	N	PAINT CONC.	MEMBRANE W.P. IN FLOOR WOOD BENCH
BATH. ROOMS	1134-60	CER.T.	G.T.	COVE	5⅜"	G.T.	N	PAINT CONC.	N	PAINT CONC.	MEMBRANE W.P. IN FLOOR WOOD BENCH
DRESSING ROOMS	1135-61	CER.T.	G.T.	COVE	5⅜"	G.T.	N	PAINT CONC.	N	PAINT CONC.	MEMBRANE W.P. IN FLOOR WOOD BENCH
CLEAN CLOTHES ROOMS	1136-62	TER.	G.T.	COVE	5⅜"	G.T.	N	PAINT CONC.	N	PAINT CONC.	MEMBRANE W.P. IN FLOOR 5⅜" G.T. COVE BASE UNDER SHELVING
ATTENDANT'S TOILETS	1137-63	CER.T.	G.T.	COVE	5⅜"	G.T.	N	PAINT CONC.	N	PAINT CONC.	MIRROR
DAY ROOM TOILETS	1138-64	CER.T.	G.T.	COVE	5⅜"	G.T.	N	PAINT CONC.	N	PAINT CONC.	MEMBRANE W.P. IN FLOOR MARBLE TOILET PAR.
DAY ROOMS	1139-65	TER.	G.T.	COVE	5⅜"	G.T.	N	AC.T.	SUSP.	PAINT CONC.	
ATTENDANTS STATIONS	1140-66	TER.	G.T.	COVE	5⅜"	G.T.	N	AC.T.	SUSP.	PAINT CONC.	WOOD SHELF IN ADJOINING CLOSET
WARDS	1141-67	TER.	G.T.	COVE	5⅜"	G.T.	N	AC.T.	SUSP.	PAINT CONC.	DWARF TILE PAR. 5'-6⅝" HIGH
NURSE'S STATIONS	1142-68	TER.	G.T.	COVE	5⅜"	G.T.	N	AC.T.	SUSP.	PAINT CONC.	WOOD SHELF IN ADJOINING CLOSET
NURSE'S TOILETS	1143-69	CER.T.	G.T.	COVE	5⅜"	G.T.	N	PAINT CONC.	N	PAINT CONC.	MIRROR
TREATMENT ROOM	1144	TER.	G.T.	COVE	5⅜"	G.T.	N	AC.T.	SUSP.	PAINT CONC.	
PHYSIO THERAPY	1145	TER.	G.T.	COVE	5⅜"	G.T.	N	AC.T.	SUSP.	PAINT CONC.	TILE PAR. 5'-6" HIGH WOOD SHELVES IN ADJOINING CLOSET
SINGLE ROOMS	1146-7-8-9 1150-1-2-3	TER.	G.T.	COVE	5⅜"	G.T.	N	PAINT CONC.	N	PAINT CONC.	MEMBRANE W.P. IN FLOOR
PASSAGE	1-PD	TER.	G.T.	COVE	5⅜"	G.T.	N	AC.T.	SUSP.	EXP. CONC.	MEMBRANE W.P. IN FLOOR
PASSAGE	1-PE	TER.	G.T.	COVE	5⅜"	G.T.	N	AC.T.	SUSP.	PAINT CONC.	
OCCUPATIONAL THERAPY	1170	TER.	G.T.	COVE	5⅜"	G.T.	N	AC.T.	SUSP.	PAINT CONC.	
OCCUPATIONAL THERAPY TOILET	1171	CER.T.	G.T.	COVE	5⅜"	G.T.	N	PAINT CONC.	N	PAINT CONC.	MEMBRANE W.P. IN FLOOR MARBLE TOILET PAR.
OCCUPATIONAL THERAPY STORAGE	1172	CEM.	G.T.	COVE	5⅜"	G.T.	N	EXP. CONC.	N	EXP. CONC.	WOOD SHELVES
CORRIDOR	1-H	TER.	G.T.	COVE	5⅜"	G.T.	G.T.	AC.T.	SUSP.	EXP. CONC.	
CORRIDOR	1-J, 1-D	TER.	G.T.	COVE	5⅜"	G.T.	N	AC.T.	SUSP.	EXP. CONC.	FOR SHELVING SEE DWGS. A-25 SUSP. AC.T. CLG. 5'-4⅝"
CLOSETS		TER.	G.T.	COVE	5⅜"	G.T.	N	PLASTER	SUSP.	PAINT CONC.	
PIPE SPACES		CEM	N	N	N	M. FILL	N	EXP. CONC.	N	EXP. CONC.	
STAIRS	4-5	CONC.	G.T.	FLUSH	5⅜"	G.T.	G.T.	PAINT CONC.	N	PAINT CONC.	CONC. LANDINGS AND STEPS SAFETY TREADS
STORAGE ROOM	1144-A	TER.	G.T.	COVE	5⅜"	G.T.	N	PAINT CONC.	N	PAINT CONC.	METAL SHELVES

NOTE: OBSCURE GLASS IN ROOMS AND SPACES NOS: 1131, 1157, 1132, 1155, 1133, 1159, 1134, 1160, 1135, 1161, 1137, 1163, 1136, 1164, 1143, 1169, 1171, 1144-A, 1145.

NOTES: FOR DETAILS OF MOP ROOM, TOILET ROOM AND WASH AREAS - SEE DWG. NO A27
FOR DETAILS OF UTILITY ROOM, NURSE'S STATION, ATTENDANT'S STATION, TREATMENT ROOM, LOCKERS - SEE DWG. NO A26
FOR DETAILS OF SHELVING - SEE DWG. NO A25
FOR DETAILS OF STAIRS AND ELEVATOR - SEE DWG. NOS A33 AND A34
FOR DETAILS OF EXTERIOR DOORS - SEE DWG. NO. A21 AND A22.

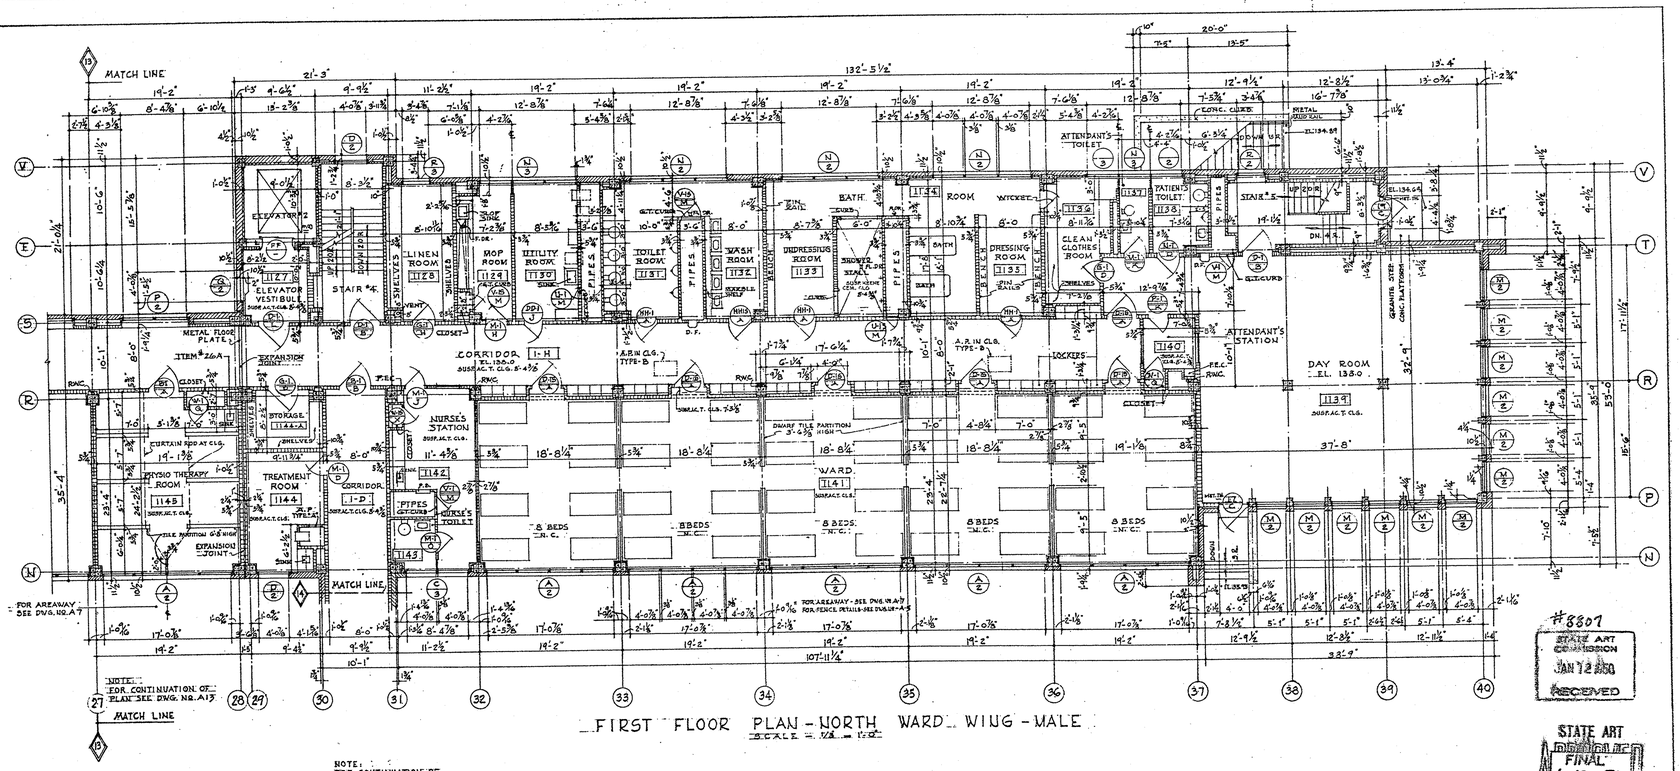

FIRST FLOOR PLAN - NORTH WARD WING - MALE
SCALE 1/8" = 1'-0"

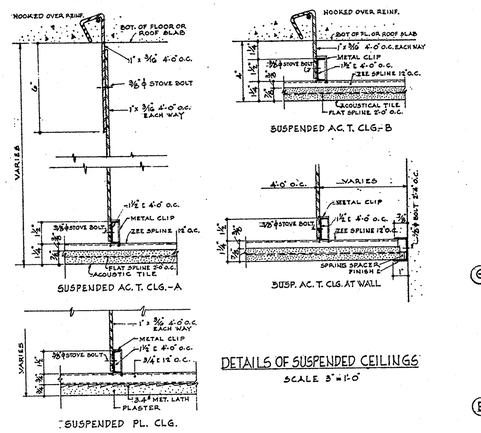

DETAILS OF SUSPENDED CEILINGS
SCALE 3" = 1'-0"

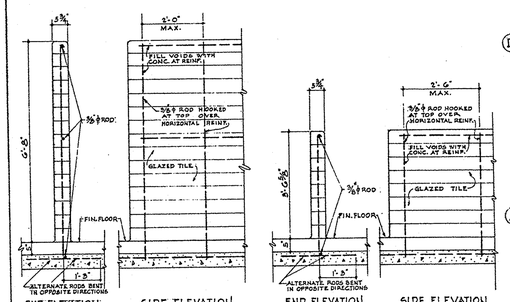

DETAILS OF DWARF TILE BARRIER PARTITIONS SCALE ½" = 1'-0"

NOTE: GLAZED TILE BARRIER PARTITIONS IN WARDS, PHYSIO-THERAPY ROOMS, VISITORS AREA, AND HAIR-DRESSING ROOM.

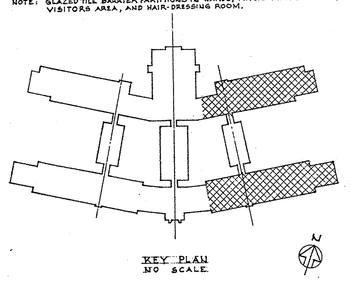

KEY PLAN
NO SCALE.

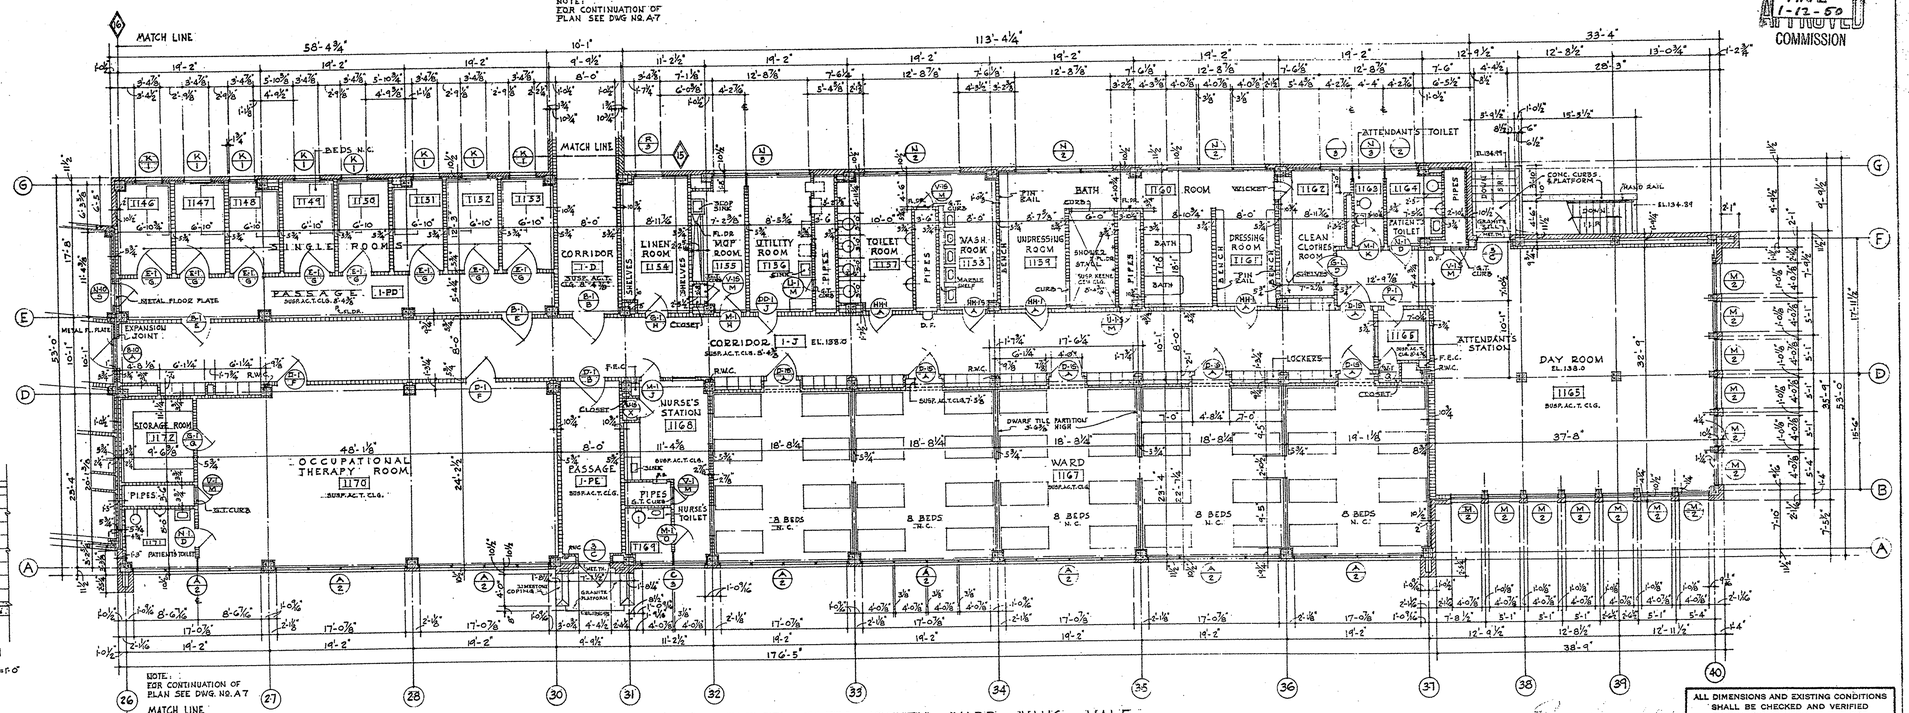

FIRST FLOOR PLAN - SOUTH WARD WING - MALE
SCALE - 1/8" = 1'-0"

ALL DIMENSIONS AND EXISTING CONDITIONS SHALL BE CHECKED AND VERIFIED BY THE CONTRACTOR AT THE SITE

APPROVED
Commonwealth of Pennsylvania
DEPARTMENT OF WELFARE
Approved ... Date ...
Secretary ... Date ...

STATE ART COMMISSION APPROVED 1-12-50 PENNSYLVANIA

REGISTERED ARCHITECT PENNSYLVANIA DAVIS AND POOLE

#8807 STATE ART COMMISSION JAN 12 1950 RECEIVED

STATE ART COMMISSION FINAL 1-12-50

REVISED
AS BUILT MARCH 16, 1952

THE GENERAL STATE AUTHORITY	
APPROVED	1-18-50 DIRECTOR
APPROVED	DIRECTING ENGINEER
SUBMITTED	ARCHITECTS
APPROVED	DEPT. OF WELFARE
APPROVED	1/19/50 DEPT. OF PROPERTY & SUPPLIES
APPROVED	DEPT. OF HEALTH
ACCEPTED	CONTRACTOR BY
ACCEPTED	CONTRACTOR BY
ACCEPTED	CONTRACTOR BY

PROJECT No. - GSA - 510-1

PHILADELPHIA STATE HOSPITAL
PHILADELPHIA PENNSYLVANIA

TUBERCULAR PATIENTS' BUILDING N-10
FIRST FLOOR PLAN - MALE WARD WINGS
DAVIS AND POOLE REGISTERED ARCHITECTS
112 S. 16th ST. PHILADELPHIA, PENNA.

1949	THE GENERAL STATE AUTHORITY	SHEET No.
PROGRAM	JAMES H. DUFF PRESIDENT	A-10
DATE JAN. 16 1950	OSCAR R. LINDAHL EXEC. DIRECTOR	
SCALE AS NOTED	HARRISBURG, PENNSYLVANIA	

CHECKED FOR G.S.A.

SUPV. ARCH.	ARCH.	STRUCT.	MECH.	ELEC.
JOR 11/1/50	AV			