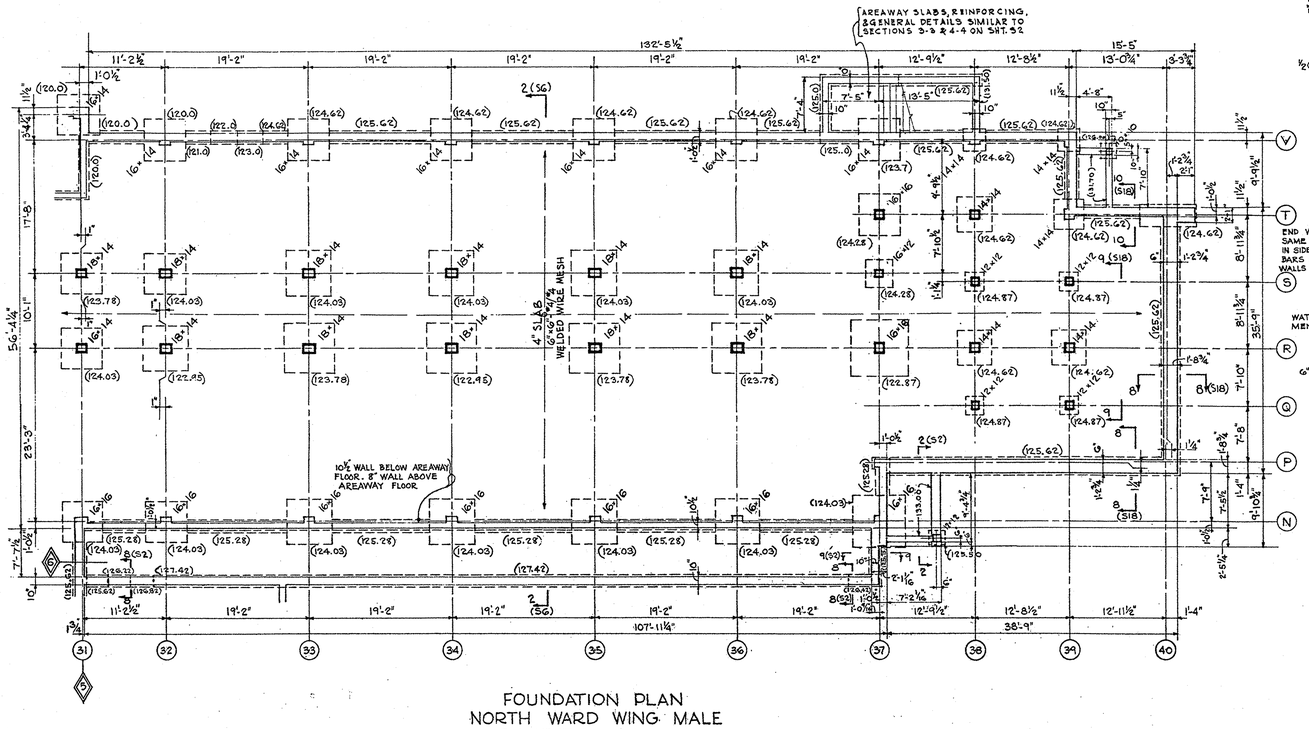

FOUNDATION PLAN
NORTH WARD WING MALE
BASEMENT COLUMNS SHOWN
SCALE: ⅛" = 1'-0"

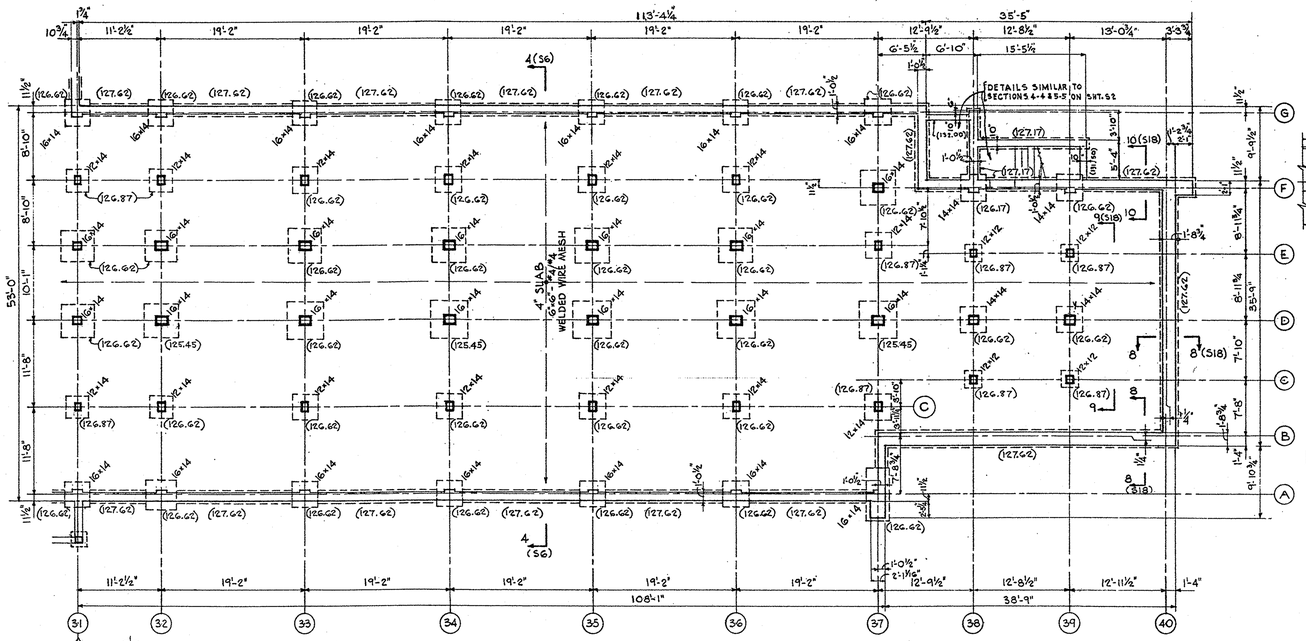

FOUNDATION PLAN
SOUTH WARD WING MALE
BASEMENT COLUMNS SHOWN
SCALE: ⅛" = 1'-0"

FIGURES SHOWN IN PARENTHESES; THUS (126.62) INDICATES ELEVATIONS OF BOTTOMS OF FOOTINGS. FIN. 1ST FL. ELEV. = 138.0'

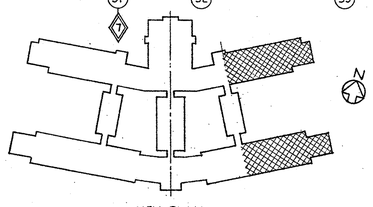

KEY PLAN

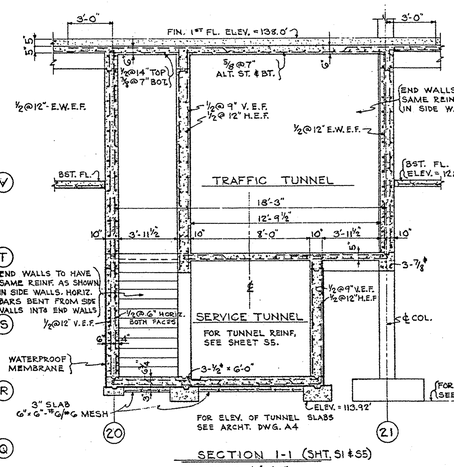

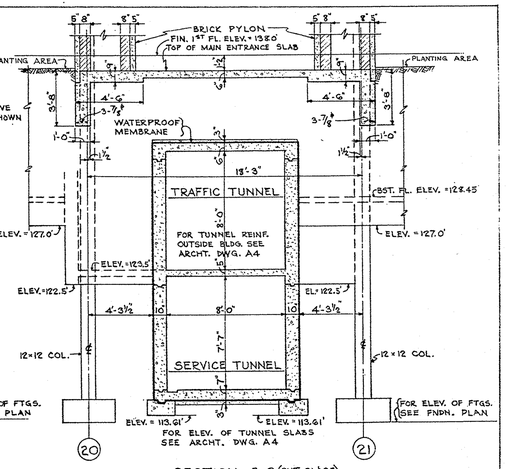

SECTION 1-1 (SHT. S1 & S5)
SCALE: ¼" = 1'-0"

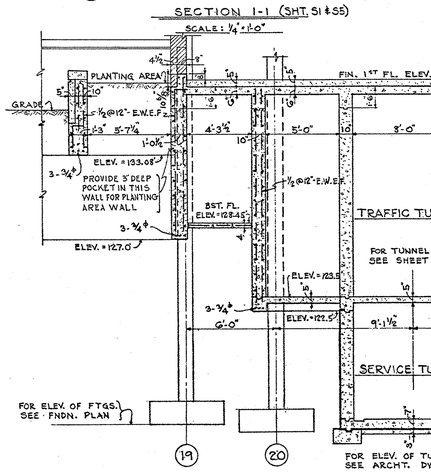

SECTION 3-3 (SHT. S1 & S5)
SCALE: ¼" = 1'-0"

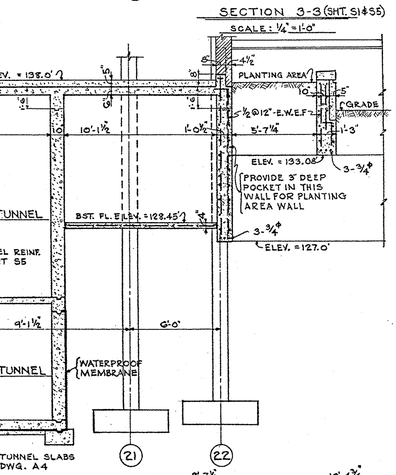

SECTION 2-2 (SHT. S1 & S5)
SCALE: ¼" = 1'-0"

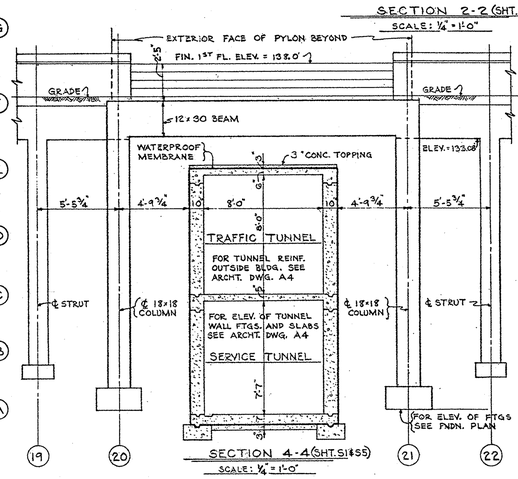

SECTION 4-4 (SHT. S1 & S5)
SCALE: ¼" = 1'-0"

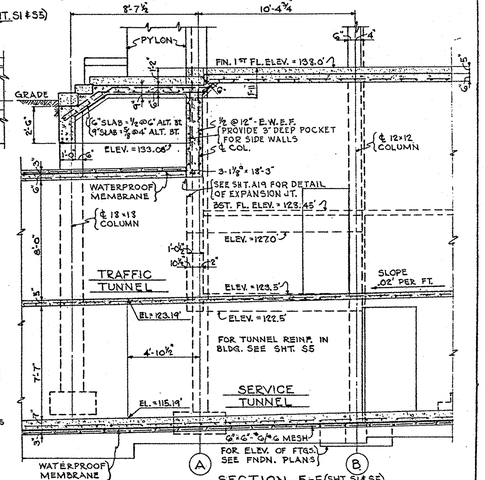

SECTION 5-5 (SHT. S1 & S5)
SCALE: ¼" = 1'-0"

Eugene P. Welsh '96

ALL DIMENSIONS AND EXISTING CONDITIONS SHALL BE CHECKED AND VERIFIED BY THE CONTRACTOR AT THE SITE

APPROVED
Commonwealth of Pennsylvania
DEPARTMENT OF WELFARE
Architect
Date
Secretary
Date

HORACE B. NICHOLSON
REGISTERED PROFESSIONAL ENGINEER
No. 772
COMMONWEALTH OF PENNSYLVANIA

Horace B. Nicholson

HORACE B. NICHOLSON
CONSULTING ENGINEER
223 BROAD ST. STATION
PHILADELPHIA, PA.

REGISTERED ARCHITECT PENNSYLVANIA
ALBERT M. DAVIS INC. 1930

REGISTERED ARCHITECT PENNSYLVANIA
DAVIS AND POOLE INC. 1930

REVISED
AS BUILT 3/10/52

THE GENERAL STATE AUTHORITY

APPROVED	Oscar N. Lindahl 11-8-50	EXECUTIVE DIRECTOR
APPROVED		DIRECTING ENGINEER
SUBMITTED		ARCHITECTS
APPROVED		DEPT. OF WELFARE
APPROVED	W.D. Griffin 11/9/50	DEPT. OF PROPERTY & SUPPLIES
APPROVED		DEPT. OF HEALTH
ACCEPTED		CONTRACTOR BY
ACCEPTED		CONTRACTOR BY
ACCEPTED		CONTRACTOR BY

PROJECT No. - GSA - 510-1

PHILADELPHIA STATE HOSPITAL
PHILADELPHIA PENNSYLVANIA

TUBERCULAR PATIENTS' BUILDING N-10
FOUNDATION PLAN
WARD WINGS MALE

DAVIS AND POOLE
112 S. 16th ST.
REGISTERED ARCHITECTS
PHILADELPHIA, PENNA.

1949 PROGRAM DATE JAN. 16, 1950 SCALE AS NOTED	THE GENERAL STATE AUTHORITY JAMES H. DUFF PRESIDENT OSCAR N. LINDAHL EXEC. DIRECTOR HARRISBURG, PENNSYLVANIA	SHEET No. S-3

CHECKED FOR G.S.A.

SUPV. ARCH.	ARCH.	STRUCT.	MECH.	ELEC.
JAR 11/9/50		E.M. 11/9/50		