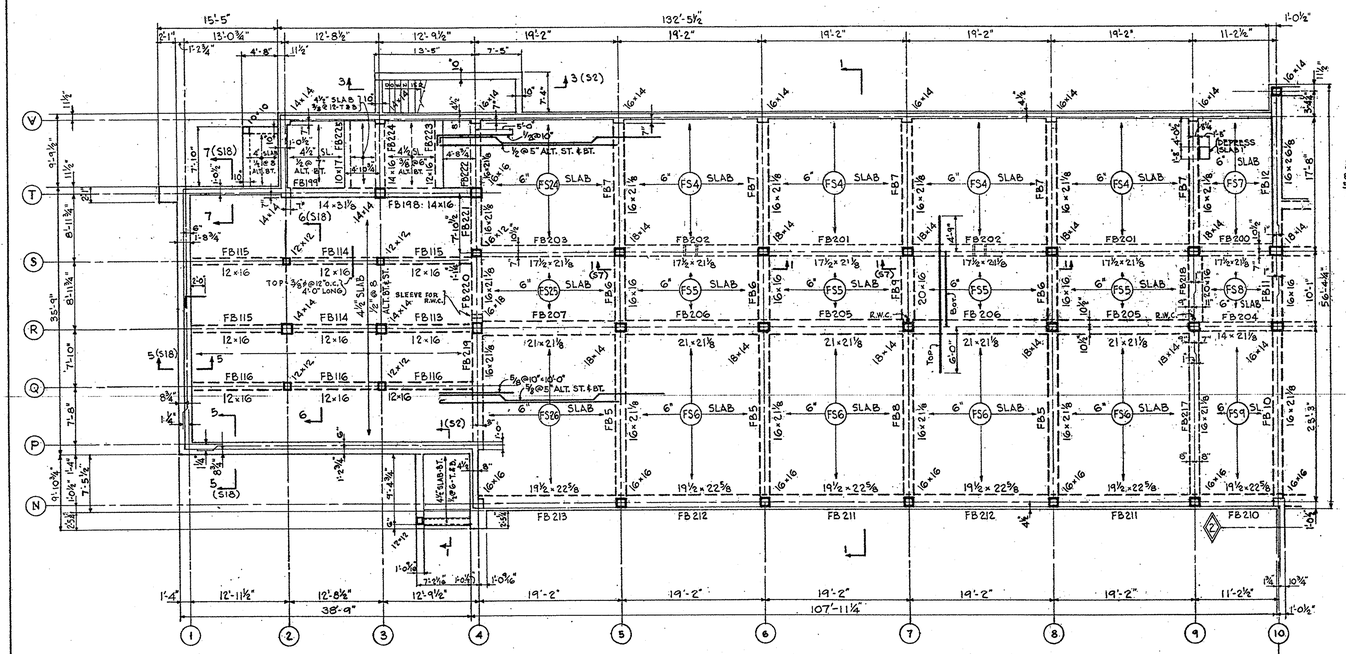

FIRST FLOOR CONSTRUCTION
NORTH WARD WING FEMALE
BASEMENT COLUMNS SHOWN
SCALE: 1/8" = 1'-0"

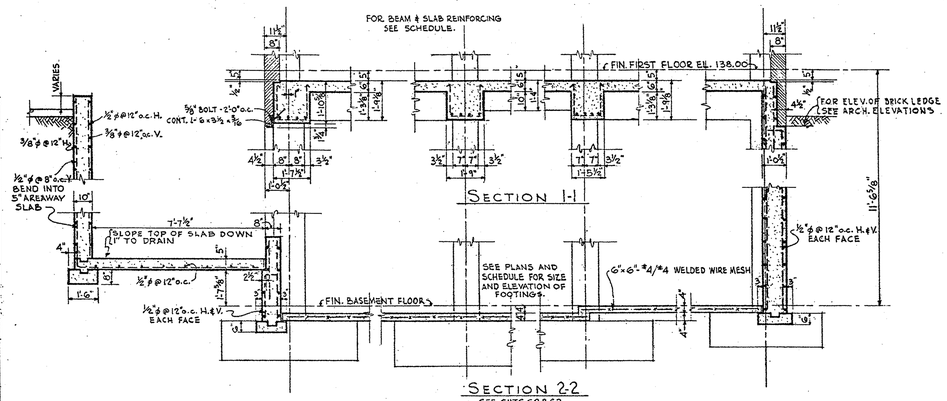

SECTION 2-2
SEE SHTS. S2 & S3.

TYPICAL SECTIONS THRU NORTH WARD WINGS
SCALE: 3/8" = 1'-0"

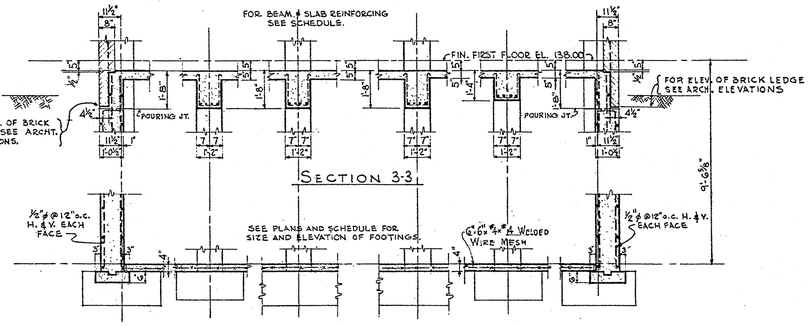

SECTION 4-4
SEE SHTS. S2 & S3.

TYPICAL SECTIONS THRU SOUTH WARD WINGS
SCALE: 3/8" = 1'-0"

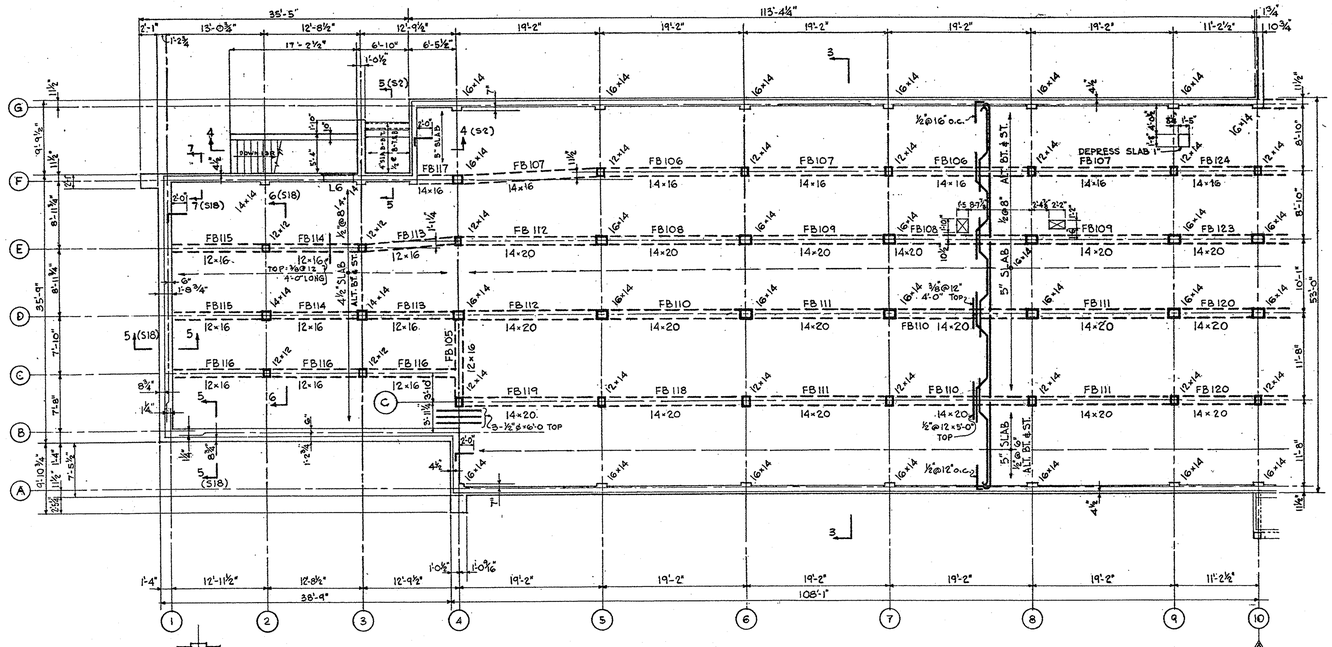

FIRST FLOOR CONSTRUCTION
SOUTH WARD WING FEMALE
BASEMENT COLUMNS SHOWN
SCALE: 1/8" = 1'-0"

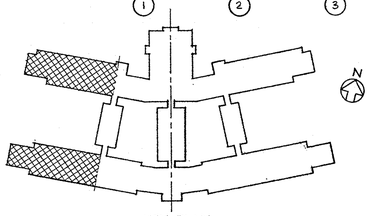

KEY PLAN

FOR SIZE OF LOOSE LINTELS, LG ETC., SEE SHEET S-16

APPROVED
Commonwealth of Pennsylvania
DEPARTMENT OF WELFARE
Archt. & Engr. ____ Date ____
Secretary ____ Date ____

HORACE B. NICHOLSON
CONSULTING ENGINEER
223 BROAD ST. STATION
PHILADELPHIA, PA.

ALL DIMENSIONS AND EXISTING CONDITIONS SHALL BE CHECKED AND VERIFIED BY THE CONTRACTOR AT THE SITE

REVISED
AS BUILT 3/18/52

THE GENERAL STATE AUTHORITY

APPROVED Oscar N. Lindahl 1-18-50
EXECUTIVE DIRECTOR

APPROVED [signature]
DIRECTING ENGINEER

SUBMITTED
ARCHITECTS

APPROVED
DEPT. OF WELFARE

APPROVED [signature] 4-7-50
DEPT. OF PROPERTY & SUPPLIES

APPROVED
DEPT. OF HEALTH

ACCEPTED
CONTRACTOR BY

ACCEPTED
CONTRACTOR BY

ACCEPTED
CONTRACTOR BY

PROJECT No. - GSA - 510-1

PHILADELPHIA STATE HOSPITAL
PHILADELPHIA PENNSYLVANIA

TUBERCULAR PATIENTS' BUILDING N-10
FIRST FLOOR CONSTRUCTION
WARD WINGS - FEMALE

DAVIS AND POOLE — REGISTERED ARCHITECTS
112 S. 16th ST. — PHILADELPHIA, PENNA.

1949 PROGRAM DATE
JAN. 16, 1950 SCALE AS NOTED

THE GENERAL STATE AUTHORITY
JAMES H. DUFF — PRESIDENT
OSCAR N. LINDAHL — EXEC. DIRECTOR
HARRISBURG, PENNSYLVANIA

SHEET No. S-6

CHECKED FOR G. S. A.

SUPV. ARCH.	ARCH.	STRUCT.	MECH.	ELEC.
JOE 11/4/50		EM 12.5.50		