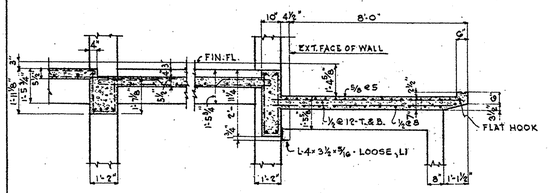

SECTION 5-5
SCALE: 3/8"=1'-0"

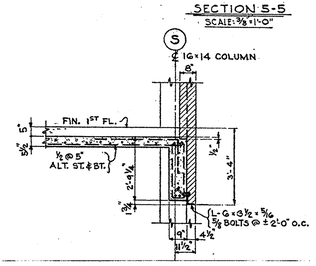

SECTION G-G
SCALE: 3/8"=1'-0"

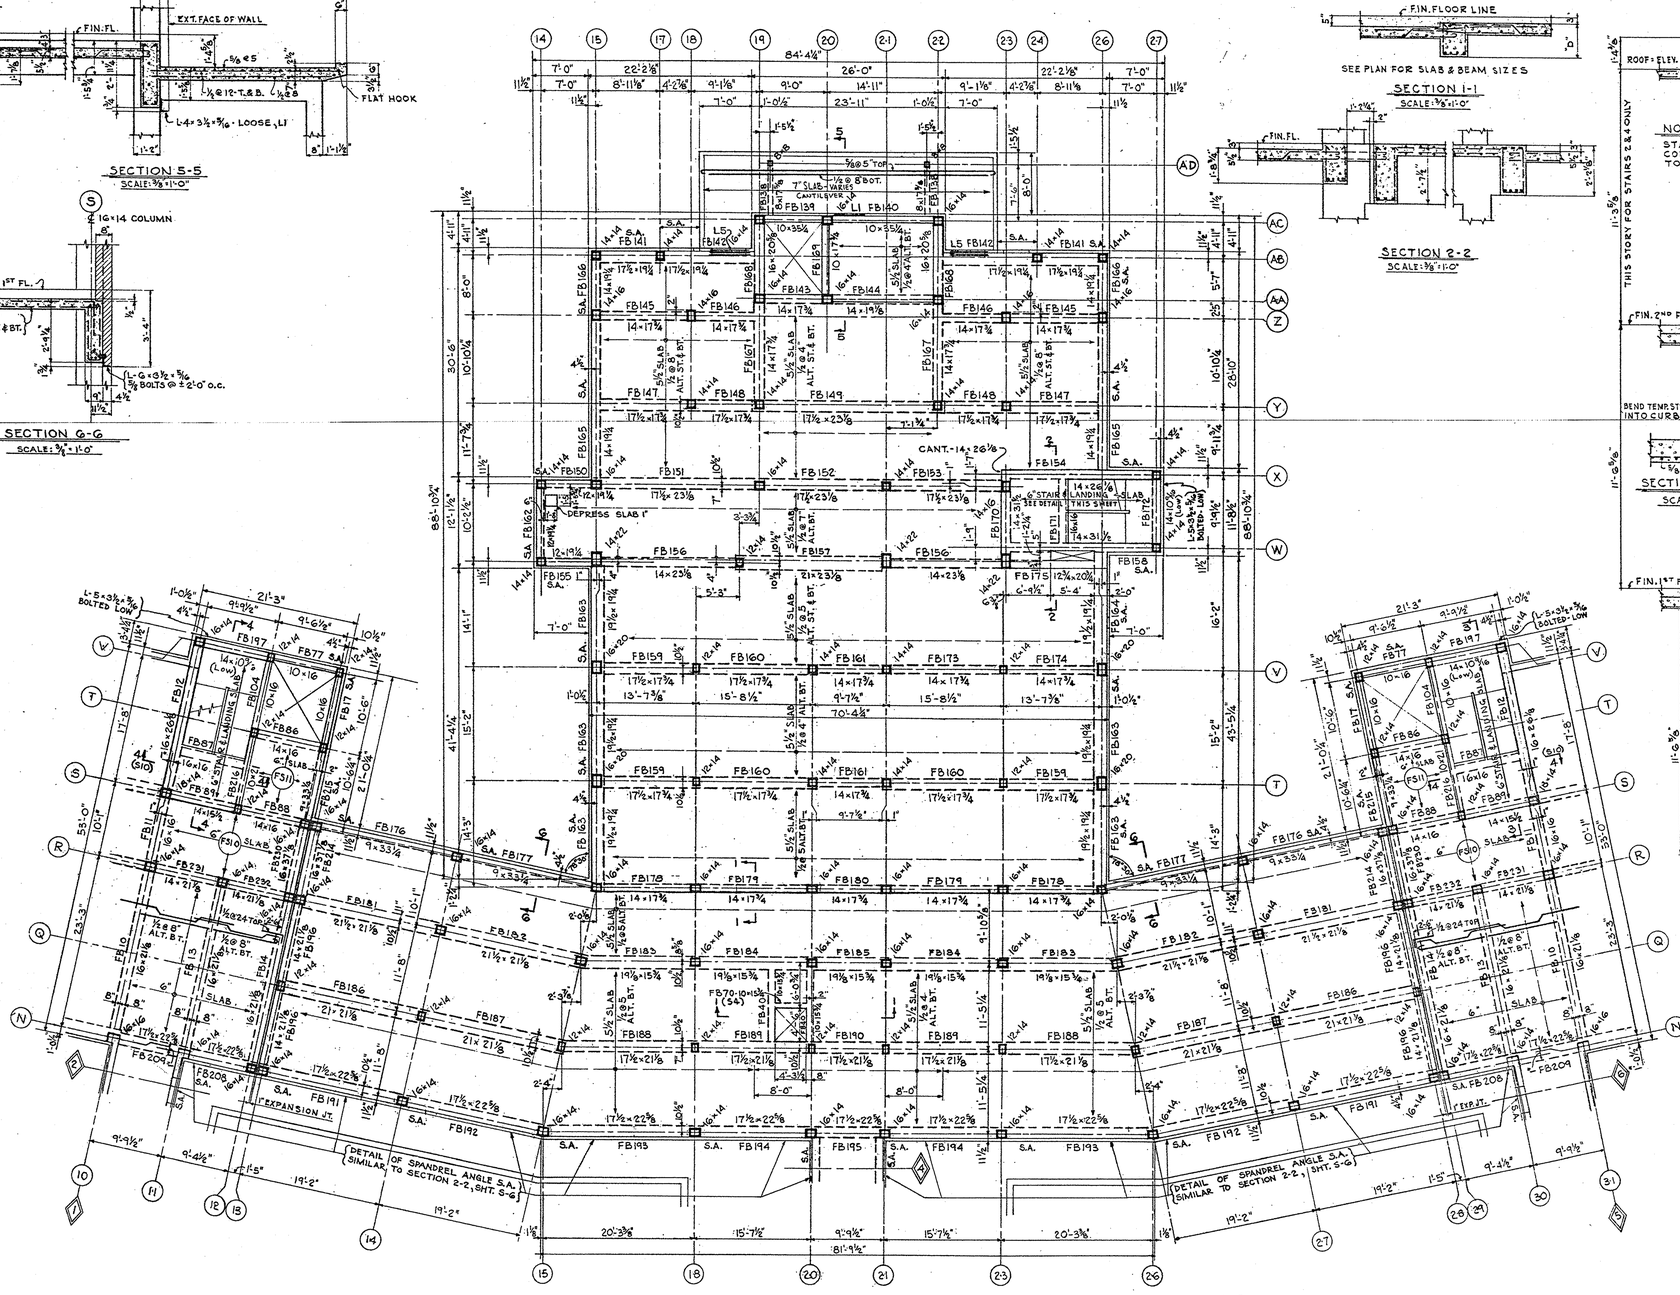

SECTION 1-1
SCALE: 3/8"=1'-0"

SECTION 2-2
SCALE: 3/8"=1'-0"

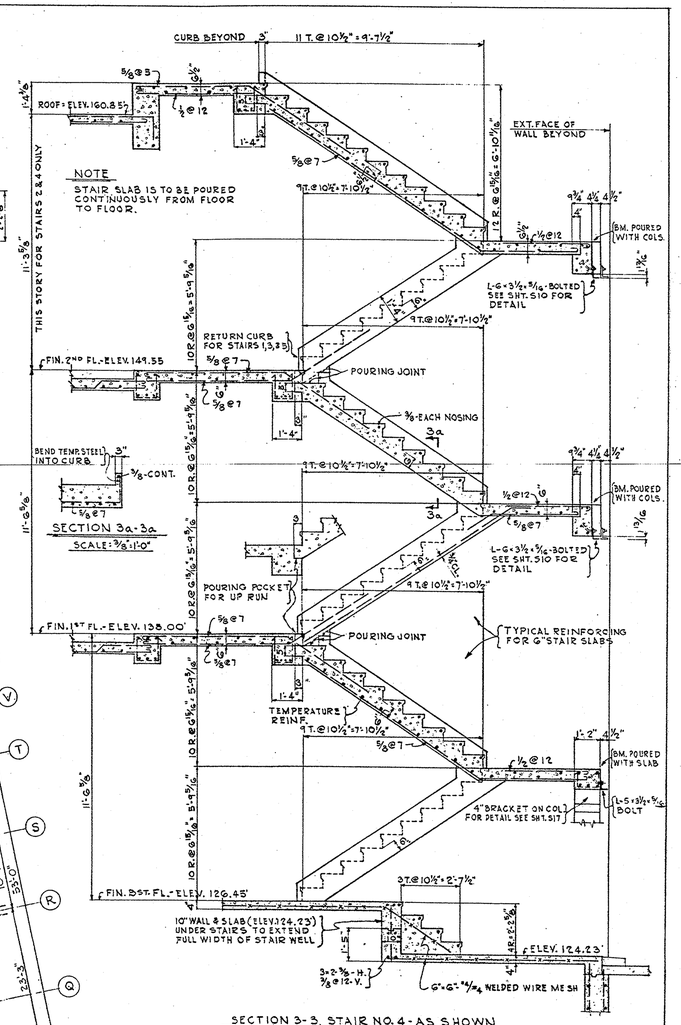

SECTION 3a-3a
SCALE: 3/8"=1'-0"

SECTION 3-3, STAIR NO. 4 - AS SHOWN
SECTION 4-4, STAIR NO. 2 - OPP. HAND
STAIR NO. 3 SIMILAR
STAIRS NO. 1 & NO. 5 SIMILAR FOR REINFORCING DETAILS ONLY
SCALE: 3/8"=1'-0"

FIRST FLOOR CONSTRUCTION
DINING KITCHEN WING
BASEMENT COLUMNS SHOWN
SCALE: 1/8"=1'-0"

S.A. INDICATES - SPANDREL L-G×3½×5/16 BOLTED
SEE TYPICAL SECTIONS & DETAILS FOR ELEVATION.

FOR SIZE OF LOOSE LINTELS L1, ETC. SEE SHT. S-1G.

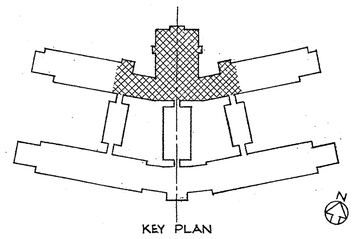

KEY PLAN

APPROVED
The Commonwealth of Pennsylvania
DEPARTMENT OF WELFARE
Archt. Admin. Eng. Sec. Date Rec'd To
Secretary _____ Dep.

COMMONWEALTH OF PENNSYLVANIA REGISTERED PROFESSIONAL HORACE B. NICHOLSON ENGINEER No. 772

Horace B. Nicholson
HORACE B. NICHOLSON
CONSULTING ENGINEER
223 BROAD ST. STATION
PHILADELPHIA, PA.

REGISTERED ARCHITECT PENNSYLVANIA No. 5329 JAMES H. DAVIS

REGISTERED ARCHITECT PENNSYLVANIA No. 5330 OSCAR N. POOLE

REVISED
AS BUILT 5/18/52

THE GENERAL STATE AUTHORITY

APPROVED	Oscar N. Poole 1-18-50 EXECUTIVE DIRECTOR	
APPROVED	J. F. Jones DIRECTOR, ENGINEER	
SUBMITTED	ARCHITECTS	
APPROVED	DEPT. OF WELFARE	
APPROVED	DEPT. OF PROPERTY & SUPPLIES	1/19/50
APPROVED	DEPT. OF HEALTH	
ACCEPTED	CONTRACTOR	BY
ACCEPTED	CONTRACTOR	BY
ACCEPTED	CONTRACTOR	BY

ALL DIMENSIONS AND EXISTING CONDITIONS SHALL BE CHECKED AND VERIFIED BY THE CONTRACTOR AT THE SITE

PROJECT No. - GSA - 510-1

PHILADELPHIA STATE HOSPITAL
PHILADELPHIA PENNSYLVANIA

TUBERCULAR PATIENTS' BUILDING N-10
FIRST FLOOR CONSTRUCTION
DINING-KITCHEN WING

DAVIS AND POOLE
112 S. 16th ST.
REGISTERED ARCHITECTS
PHILADELPHIA, PENNA.

1949 PROGRAM	THE GENERAL STATE AUTHORITY	SHEET No.
DATE JAN. 16, 1950	JAMES H. DUFF PRESIDENT	S-8
SCALE AS NOTED	OSCAR N. LINDAHL EXEC. DIRECTOR	
	HARRISBURG, PENNSYLVANIA	

CHECKED FOR G.S.A.

SUPV. ARCH.	ARCH.	STRUCT.	MECH.	ELEC.
JAR 1/16/50		EM 1/19/50		