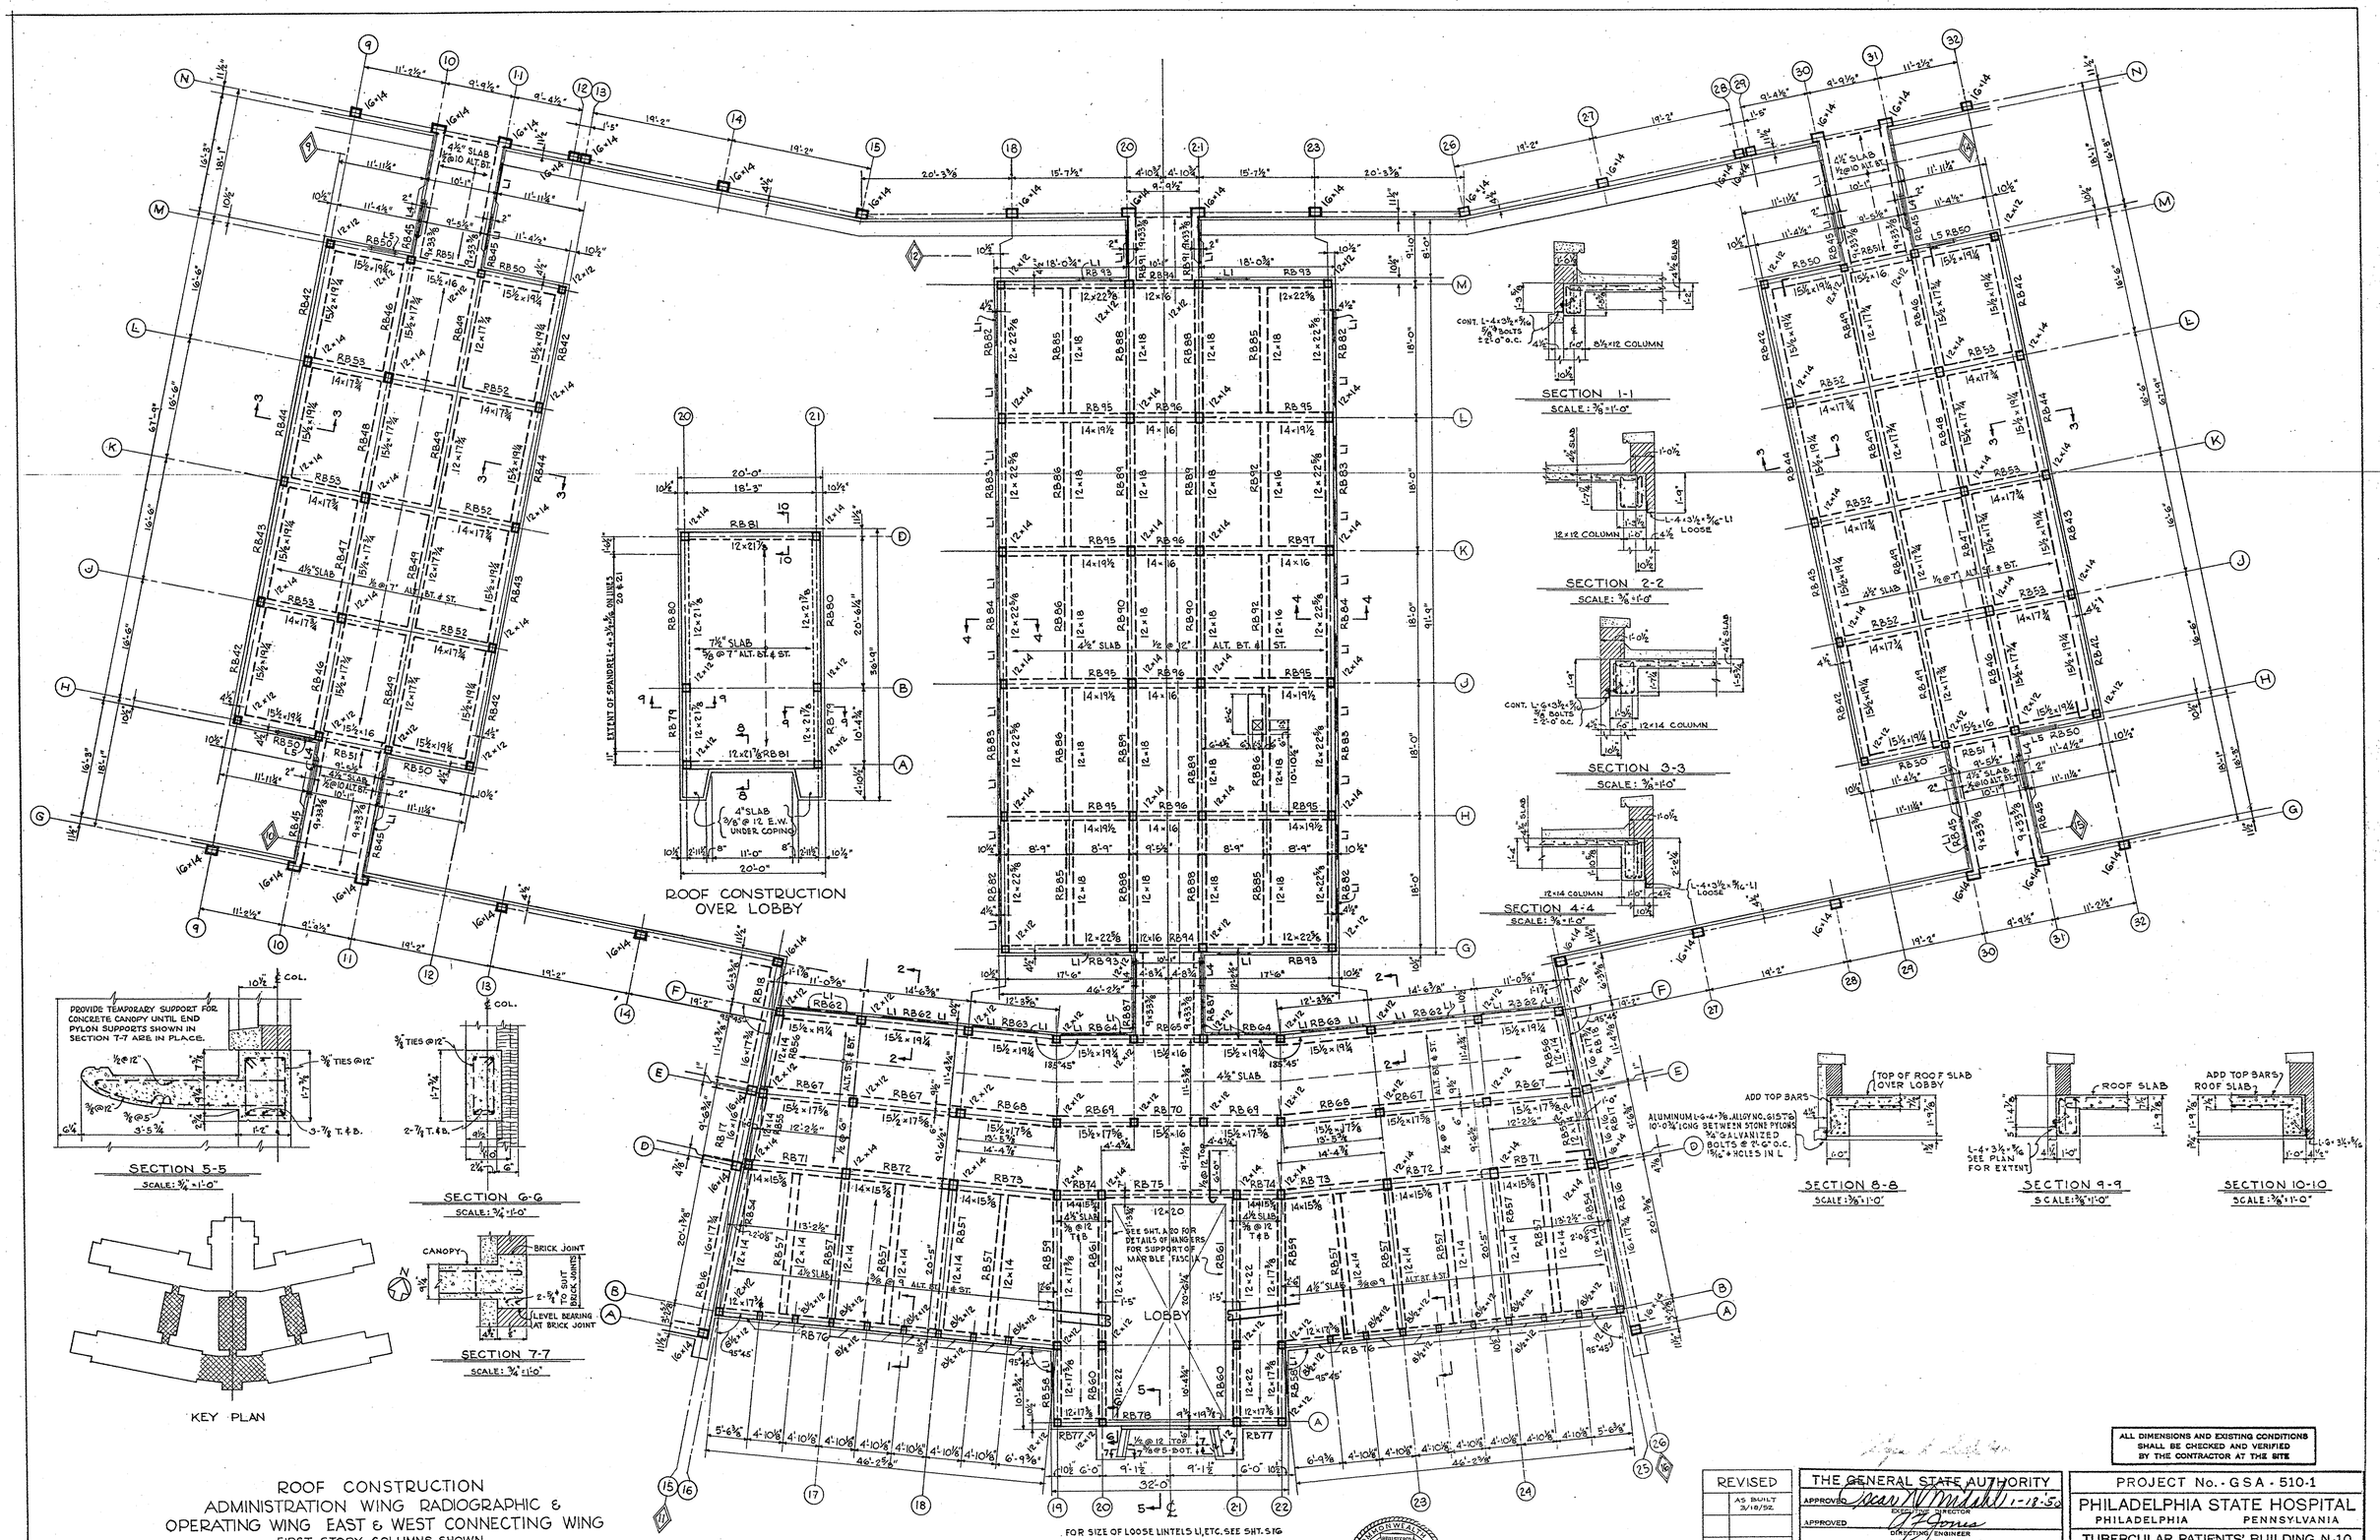

ROOF CONSTRUCTION
ADMINISTRATION WING RADIOGRAPHIC &
OPERATING WING EAST & WEST CONNECTING WING
FIRST STORY COLUMNS SHOWN
SCALE: 1/8"=1'-0"

APPROVED
Commonwealth of Pennsylvania
DEPARTMENT OF WELFARE
Archt. Date
Secretary Date

HORACE B. NICHOLSON
CONSULTING ENGINEER
223 BROAD ST. STATION
PHILADELPHIA, PA.

ALL DIMENSIONS AND EXISTING CONDITIONS SHALL BE CHECKED AND VERIFIED BY THE CONTRACTOR AT THE SITE

REVISED
AS BUILT 3/18/52

THE GENERAL STATE AUTHORITY
APPROVED — EXEC. DIRECTOR
APPROVED — DIRECTING ENGINEER
SUBMITTED — ARCHITECTS
APPROVED
APPROVED — DEPT. OF WELFARE — 11/9/50
APPROVED — DEPT. OF PROPERTY & SUPPLIES
APPROVED — DEPT. OF HEALTH
ACCEPTED — CONTRACTOR — BY
ACCEPTED — CONTRACTOR — BY
ACCEPTED — CONTRACTOR — BY

PROJECT No. - GSA - 510-1
PHILADELPHIA STATE HOSPITAL
PHILADELPHIA PENNSYLVANIA
TUBERCULAR PATIENTS' BUILDING N-10
ROOF CONSTRUCTION
ADMINISTRATION & CONNECTING WINGS
DAVIS AND POOLE — REGISTERED ARCHITECTS
112 S. 16th ST. — PHILADELPHIA, PENNA.

1949 PROGRAM DATE
JAN. 16, 1950 SCALE AS NOTED
THE GENERAL STATE AUTHORITY
JAMES H. DUFF — PRESIDENT
OSCAR N. LINDAHL — EXEC. DIRECTOR
HARRISBURG, PENNSYLVANIA
SHEET No. S-9

CHECKED FOR G.S.A.
SUPV. ARCH. JOR 11/8/50 | ARCH. | STRUCT. EM 1/17/52 | MECH. | ELEC.