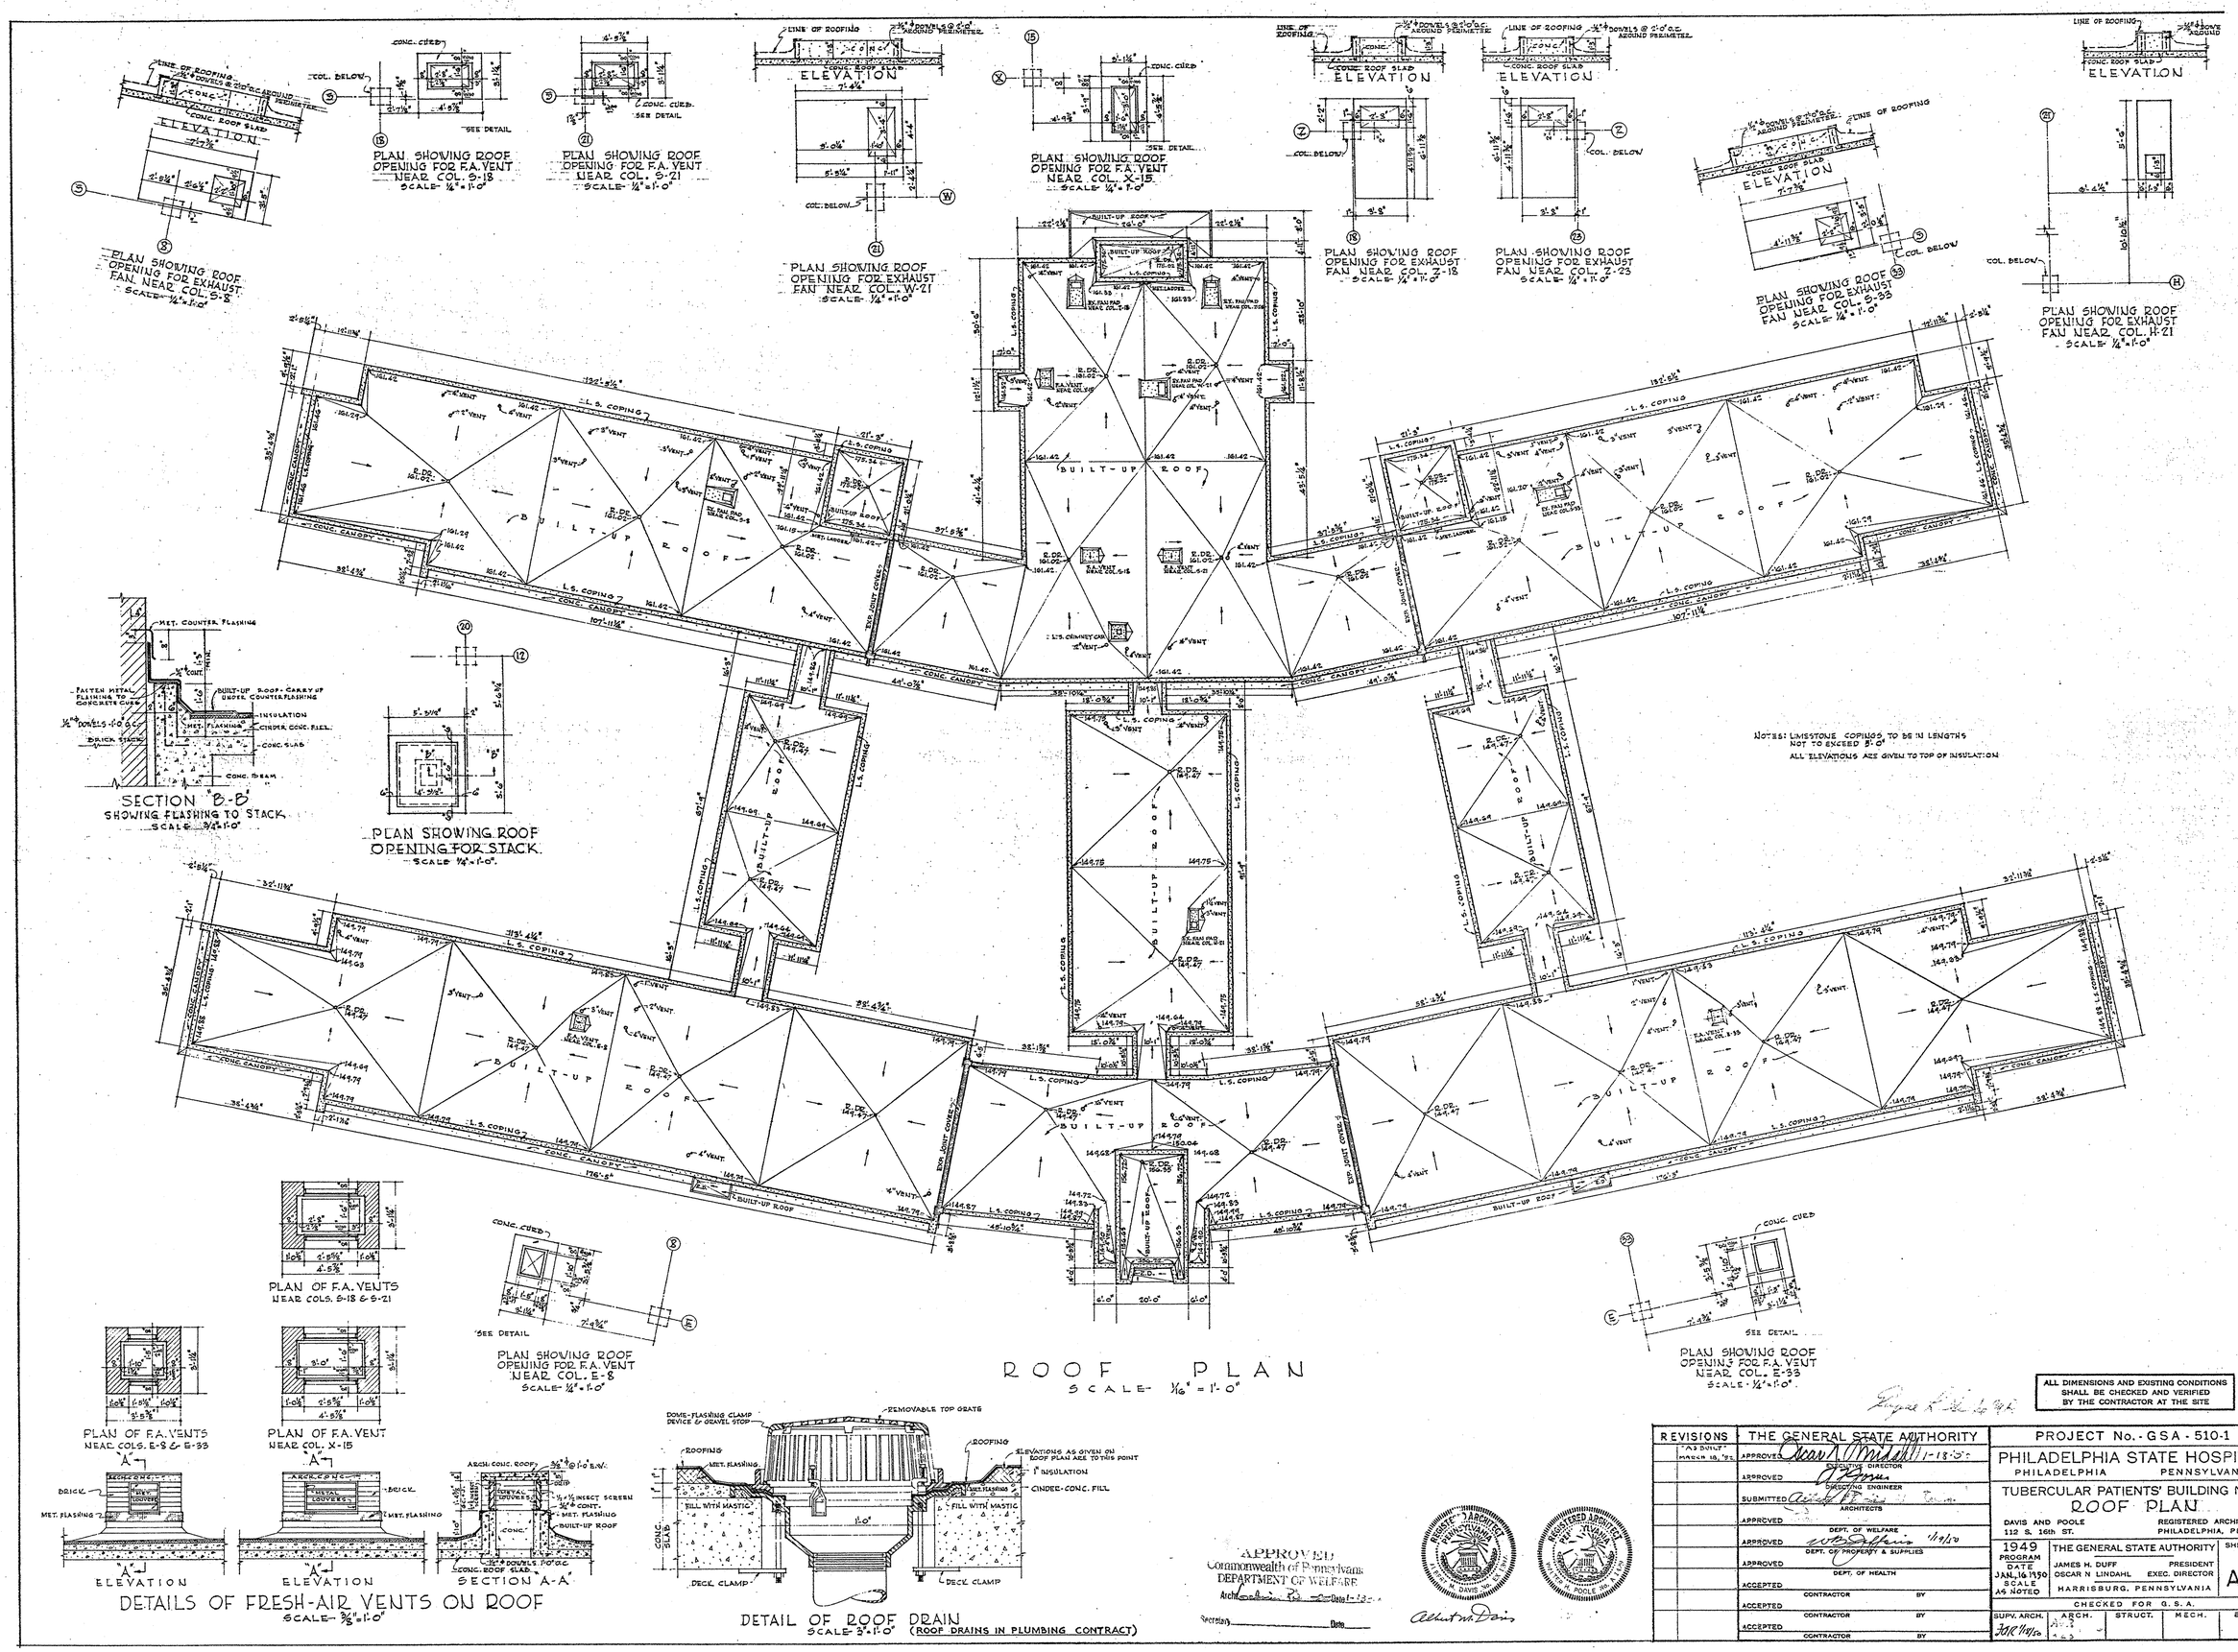
PLAN SHOWING ROOF OPENING FOR EXHAUST FAN NEAR COL. S-8
PLAN SHOWING ROOF OPENING FOR F.A. VENT NEAR COL. S-18
PLAN SHOWING ROOF OPENING FOR F.A. VENT NEAR COL. S-21
PLAN SHOWING ROOF OPENING FOR F.A. VENT NEAR COL. X-15
PLAN SHOWING ROOF OPENING FOR EXHAUST FAN NEAR COL. W-21
PLAN SHOWING ROOF OPENING FOR EXHAUST FAN NEAR COL. Z-18
PLAN SHOWING ROOF OPENING FOR EXHAUST FAN NEAR COL. Z-23
PLAN SHOWING ROOF OPENING FOR EXHAUST FAN NEAR COL. S-33
PLAN SHOWING ROOF OPENING FOR EXHAUST FAN NEAR COL. H-21
SECTION "B-B" SHOWING FLASHING TO STACK
PLAN SHOWING ROOF OPENING FOR STACK.
PLAN OF F.A. VENTS NEAR COLS. S-18 & S-21
PLAN SHOWING ROOF OPENING FOR F.A. VENT NEAR COL. E-8
PLAN SHOWING ROOF OPENING FOR F.A. VENT NEAR COL. E-33
PLAN OF F.A. VENTS NEAR COLS. E-8 & E-33
PLAN OF F.A. VENT NEAR COL. X-15
ELEVATION
SECTION A-A
DETAILS OF FRESH-AIR VENTS ON ROOF
SCALE- 3/8"=1'-0"
DETAIL OF ROOF DRAIN
SCALE- 3"=1'-0" (ROOF DRAINS IN PLUMBING CONTRACT)
ROOF PLAN
SCALE- 1/16"=1'-0"
NOTES: LIMESTONE COPINGS TO BE IN LENGTHS NOT TO EXCEED 5'-0"
ALL ELEVATIONS ARE GIVEN TO TOP OF INSULATION
APPROVED Commonwealth of Pennsylvania DEPARTMENT OF WELFARE
ALL DIMENSIONS AND EXISTING CONDITIONS SHALL BE CHECKED AND VERIFIED BY THE CONTRACTOR AT THE SITE
REVISIONS
"AS BUILT" MARCH 18, '52
THE GENERAL STATE AUTHORITY
APPROVED EXECUTIVE DIRECTOR
APPROVED DIRECTING ENGINEER
SUBMITTED ARCHITECTS
APPROVED DEPT. OF WELFARE
APPROVED DEPT. OF PROPERTY & SUPPLIES
APPROVED DEPT. OF HEALTH
ACCEPTED CONTRACTOR BY
ACCEPTED CONTRACTOR BY
ACCEPTED CONTRACTOR BY
PROJECT No. - GSA - 510-1
PHILADELPHIA STATE HOSPITAL
PHILADELPHIA PENNSYLVANIA
TUBERCULAR PATIENTS' BUILDING N-10
ROOF PLAN
DAVIS AND POOLE REGISTERED ARCHITECTS
112 S. 16th ST. PHILADELPHIA, PENNA.
1949 PROGRAM
DATE JAN. 16 1950
SCALE AS NOTED
THE GENERAL STATE AUTHORITY
JAMES H. DUFF PRESIDENT
OSCAR N LINDAHL EXEC. DIRECTOR
HARRISBURG, PENNSYLVANIA
SHEET No. A-2
CHECKED FOR G.S.A.
SUPV. ARCH. ARCH. STRUCT. MECH. ELEC.