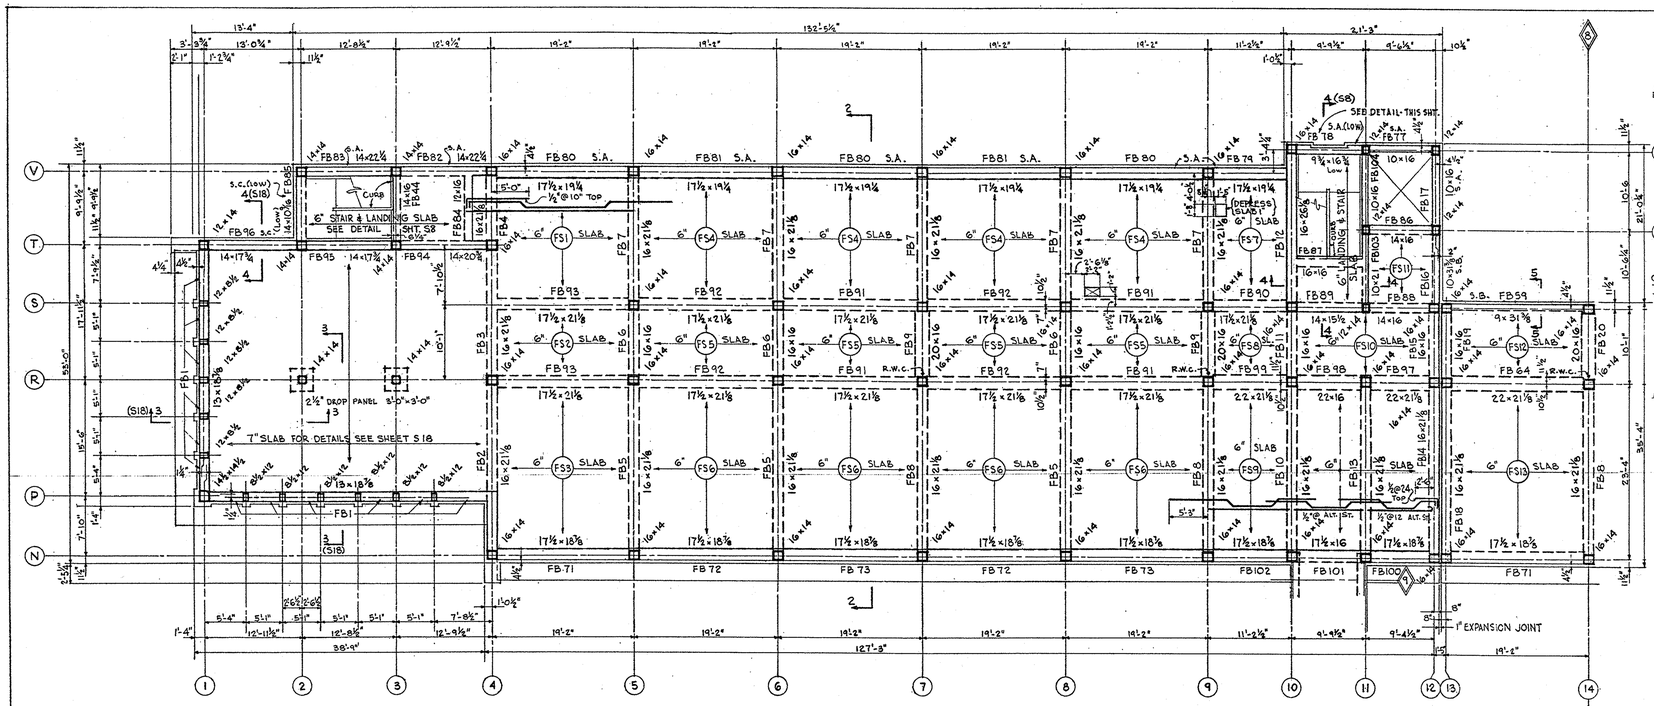

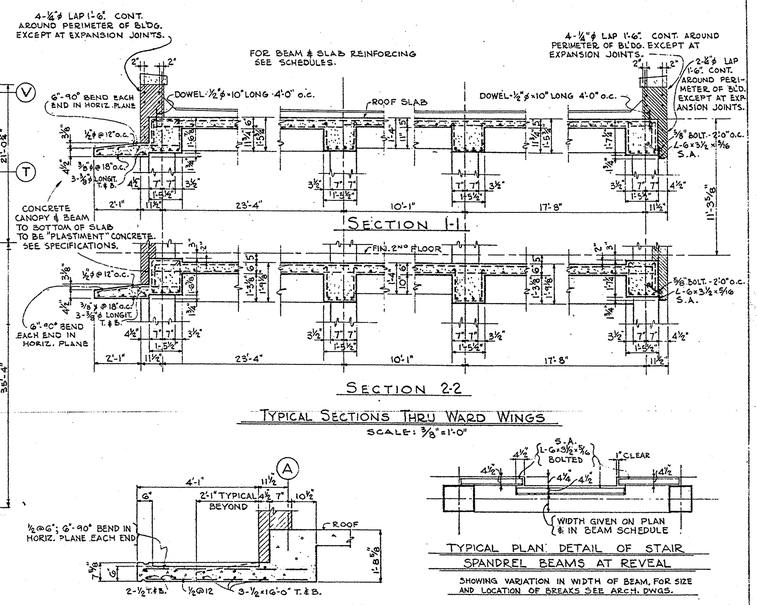

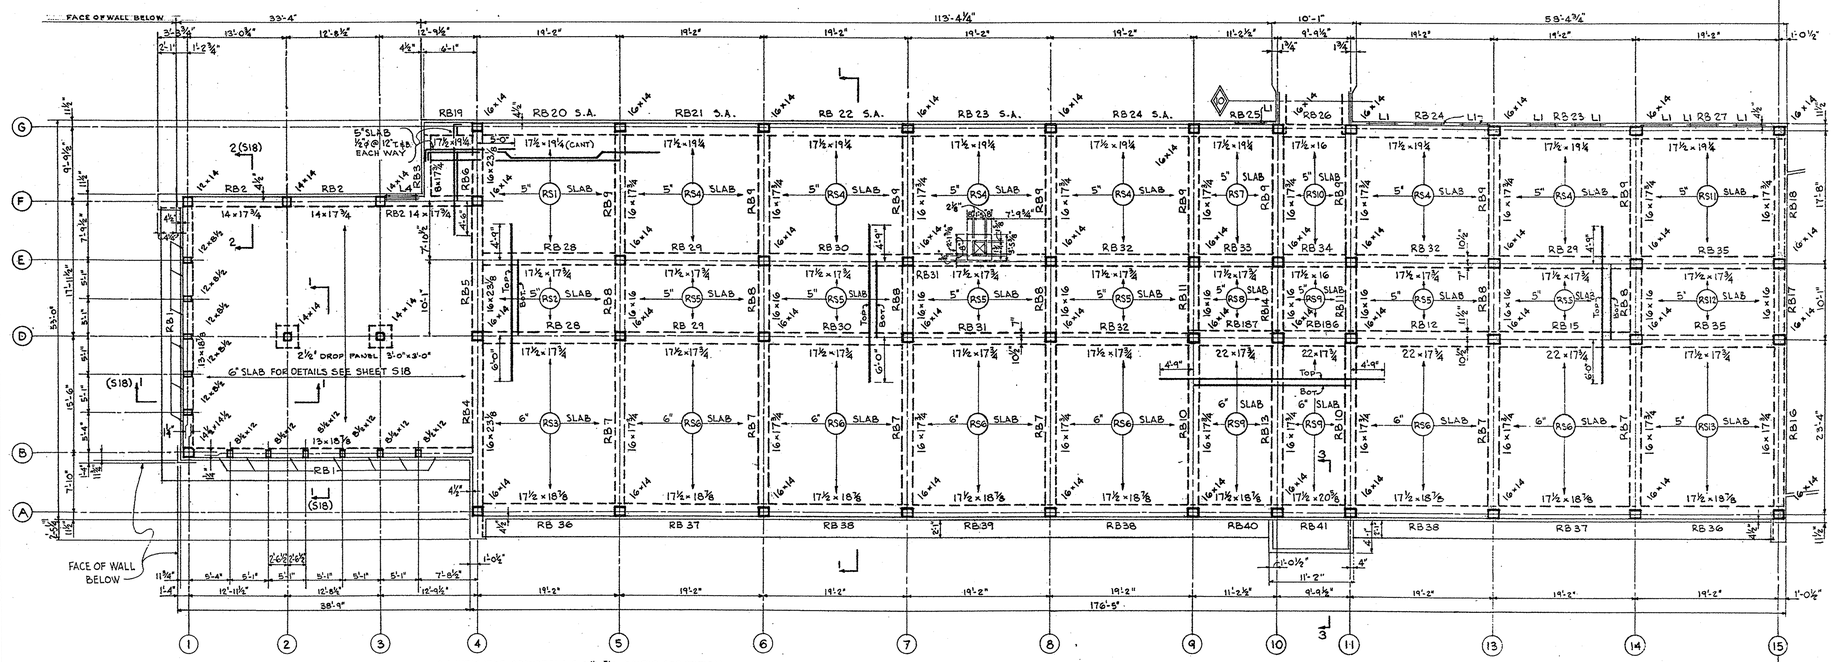

S.A. INDICATES 3 PANDREL L-G-3½"×5/16"-BOLTED. SEE TYPICAL SECTIONS AND DETAILS FOR ELEVATION.
S.B. INDICATES 5 PANDREL L-5"×3½"×5/16" WITH 4-⅛"×4" WELDED LUGS-BOLTED.
S.C. INDICATES 5 PANDREL L-5"×3½"×5/16"-BOLTED.
FOR SIZE OF LOOSE LINTELS L1, ETC. SEE SHT. S10

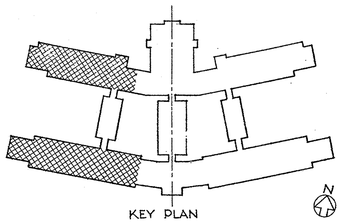

HORACE B. NICHOLSON
CONSULTING ENGINEER
223 BROAD ST. STATION
PHILADELPHIA, PA.

REVISED
AS BUILT 3/18/52

ALL DIMENSIONS AND EXISTING CONDITIONS SHALL BE CHECKED AND VERIFIED BY THE CONTRACTOR AT THE SITE

THE GENERAL STATE AUTHORITY		
APPROVED	Oscar N. Lindahl 1-18-50	EXECUTIVE DIRECTOR
APPROVED	J.J. Gous	DIRECTING ENGINEER
SUBMITTED		ARCHITECTS
APPROVED		DEPT. OF WELFARE
APPROVED	W.S. Gilpin 11/9/50	DEPT. OF PROPERTY & SUPPLIES
APPROVED		DEPT. OF HEALTH
ACCEPTED		CONTRACTOR BY
ACCEPTED		CONTRACTOR BY
ACCEPTED		CONTRACTOR BY

PROJECT No. - GSA - 510-1

PHILADELPHIA STATE HOSPITAL

PHILADELPHIA PENNSYLVANIA

TUBERCULAR PATIENTS' BUILDING N-10

ROOF & SECOND FLOOR CONSTRUCTION
WARD WINGS - FEMALE

DAVIS AND POOLE, 112 S. 16th ST. — REGISTERED ARCHITECTS, PHILADELPHIA, PENNA.

1949 PROGRAM DATE JAN. 16, 1950 SCALE AS NOTED	THE GENERAL STATE AUTHORITY JAMES H. DUFF PRESIDENT OSCAR N. LINDAHL EXEC. DIRECTOR HARRISBURG, PENNSYLVANIA	SHEET No. S-10

CHECKED FOR G. S. A.

SUPV. ARCH.	ARCH.	STRUCT.	MECH.	ELEC.
FOR 11/52		EM 1/13/50		