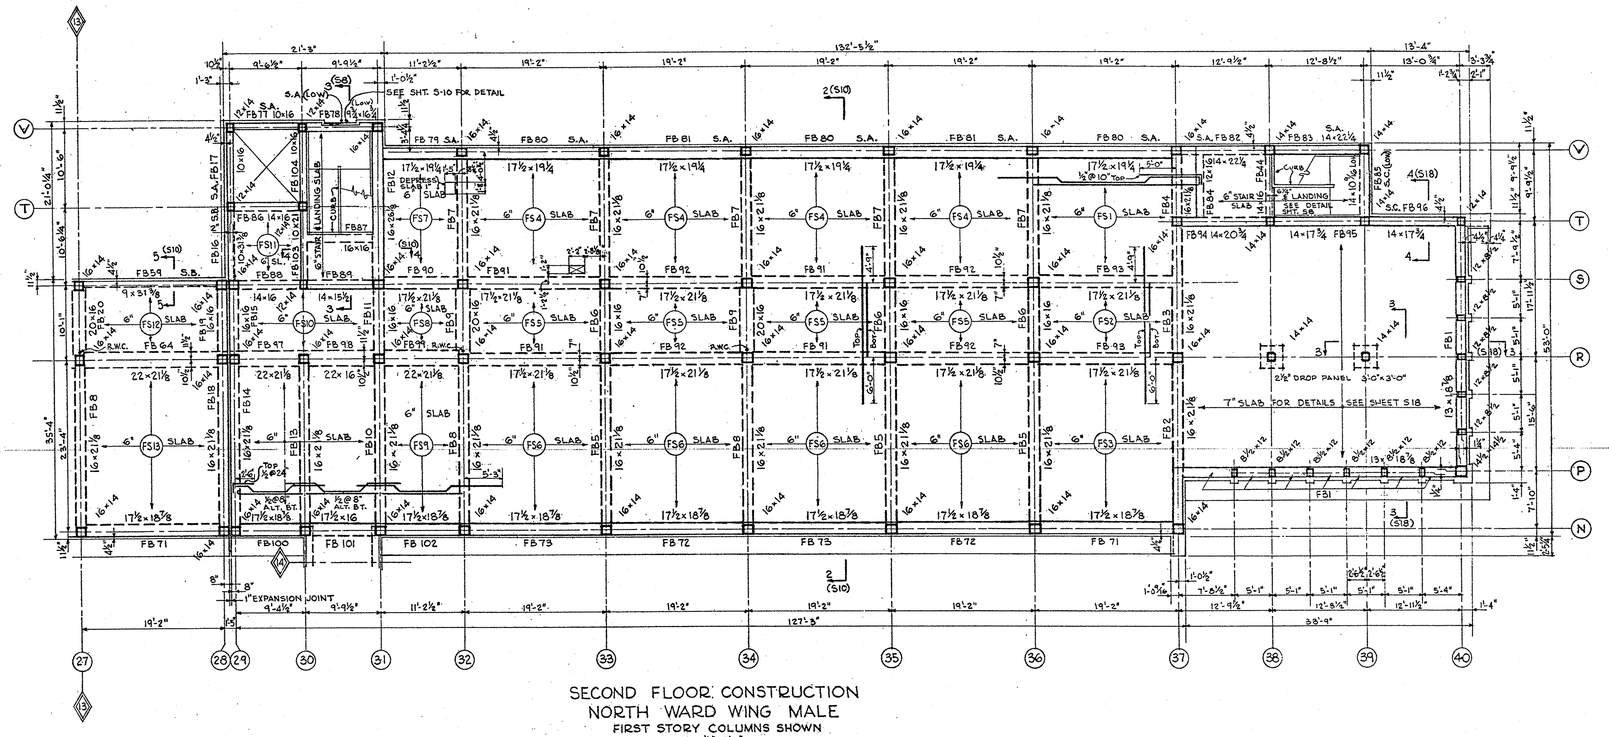

SECOND FLOOR CONSTRUCTION
NORTH WARD WING MALE
FIRST STORY COLUMNS SHOWN
SCALE: 1/8" = 1'-0"

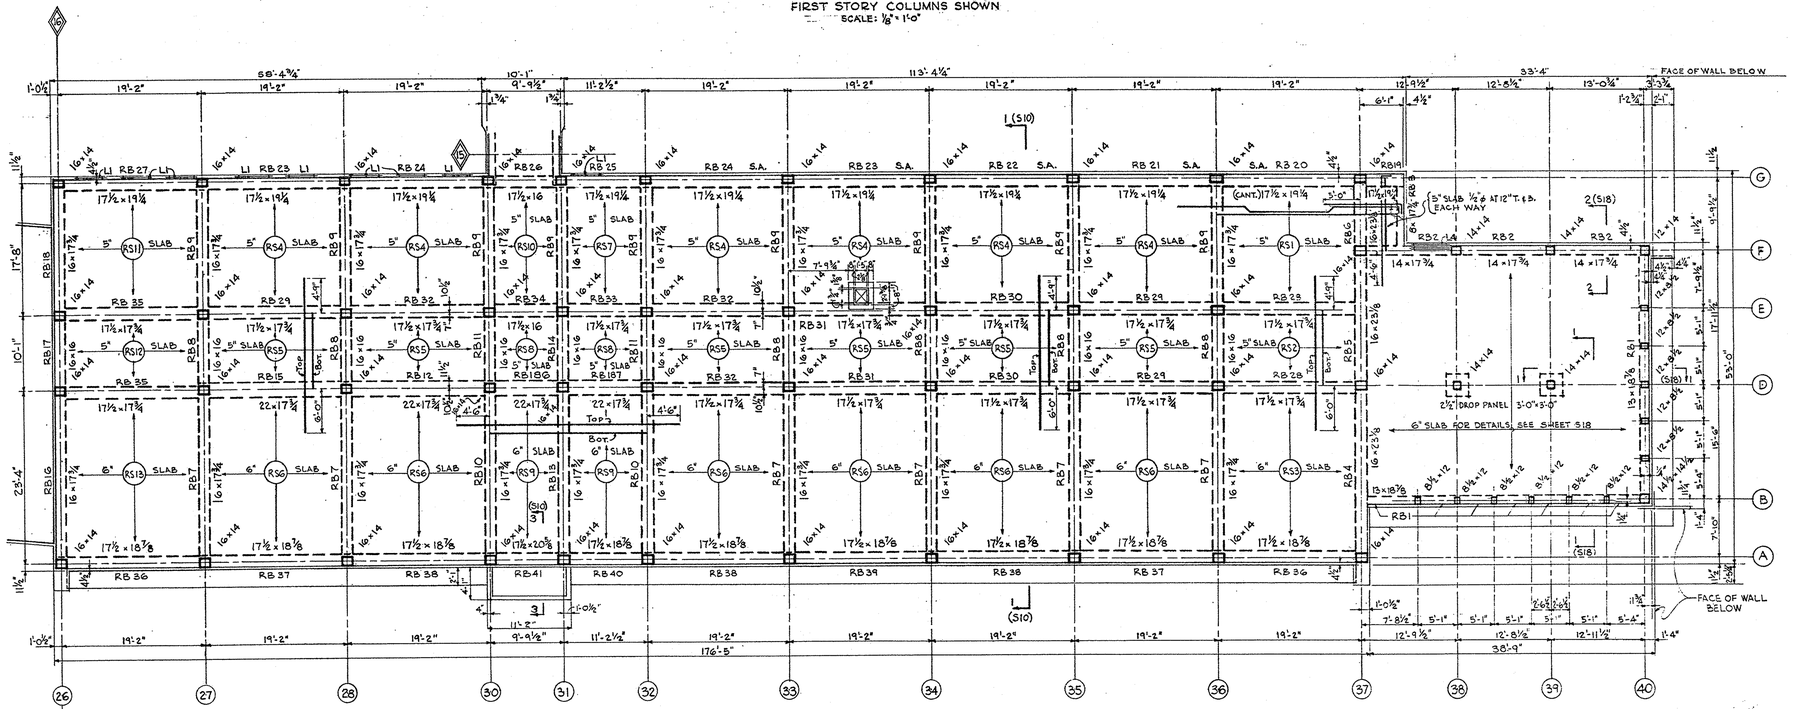

ROOF CONSTRUCTION
SOUTH WARD WING MALE
FIRST STORY COLUMNS SHOWN
SCALE: 1/8" = 1'-0"

S.A. INDICATES SPANDREL L 6×3½×5/16 - BOLTED.
SEE TYPICAL SECTIONS AND DETAILS FOR ELEVATION
S.B. INDICATES SPANDREL L 5×3½×5/16 WITH 4×4×4 WELDED LUGS BOLTED.
S.C. INDICATES SPANDREL L 5×3½×5/16-BOLTED.
FOR SIZE OF LOOSE LINTELS L1, ETC. SEE SHEET S-16

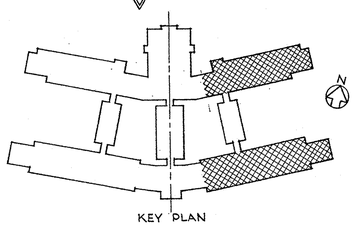

KEY PLAN

HORACE B. NICHOLSON
CONSULTING ENGINEER
223 BROAD ST. STATION
PHILADELPHIA, PA.

REVISED
AS BUILT 5/18/52.

THE GENERAL STATE AUTHORITY		
APPROVED	Oscar N. Lindahl 1-8-50	EXECUTIVE DIRECTOR
APPROVED		DIRECTING ENGINEER
SUBMITTED		ARCHITECTS
APPROVED		DEPT. OF WELFARE
APPROVED		DEPT. OF PROPERTY & SUPPLIES
APPROVED		DEPT. OF HEALTH
ACCEPTED	CONTRACTOR	BY
ACCEPTED	CONTRACTOR	BY
ACCEPTED	CONTRACTOR	BY

ALL DIMENSIONS AND EXISTING CONDITIONS SHALL BE CHECKED AND VERIFIED BY THE CONTRACTOR AT THE SITE

PROJECT No. - GSA - 510-1

PHILADELPHIA STATE HOSPITAL
PHILADELPHIA PENNSYLVANIA

TUBERCULAR PATIENTS' BUILDING N-10
ROOF & SECOND FLOOR CONSTRUCTION
WARD WINGS - MALE

DAVIS AND POOLE
112 S. 16th ST.
REGISTERED ARCHITECTS
PHILADELPHIA, PENNA.

1949 PROGRAM DATE	THE GENERAL STATE AUTHORITY	SHEET No.
JAN. 16, 1950 SCALE AS NOTED	JAMES H. DUFF PRESIDENT OSCAR N. LINDAHL EXEC. DIRECTOR HARRISBURG, PENNSYLVANIA	S-11

CHECKED FOR G. S. A.

SUPV. ARCH.	ARCH.	STRUCT.	MECH.	ELEC.
JAR 11/8/49		EM 1/13/50		