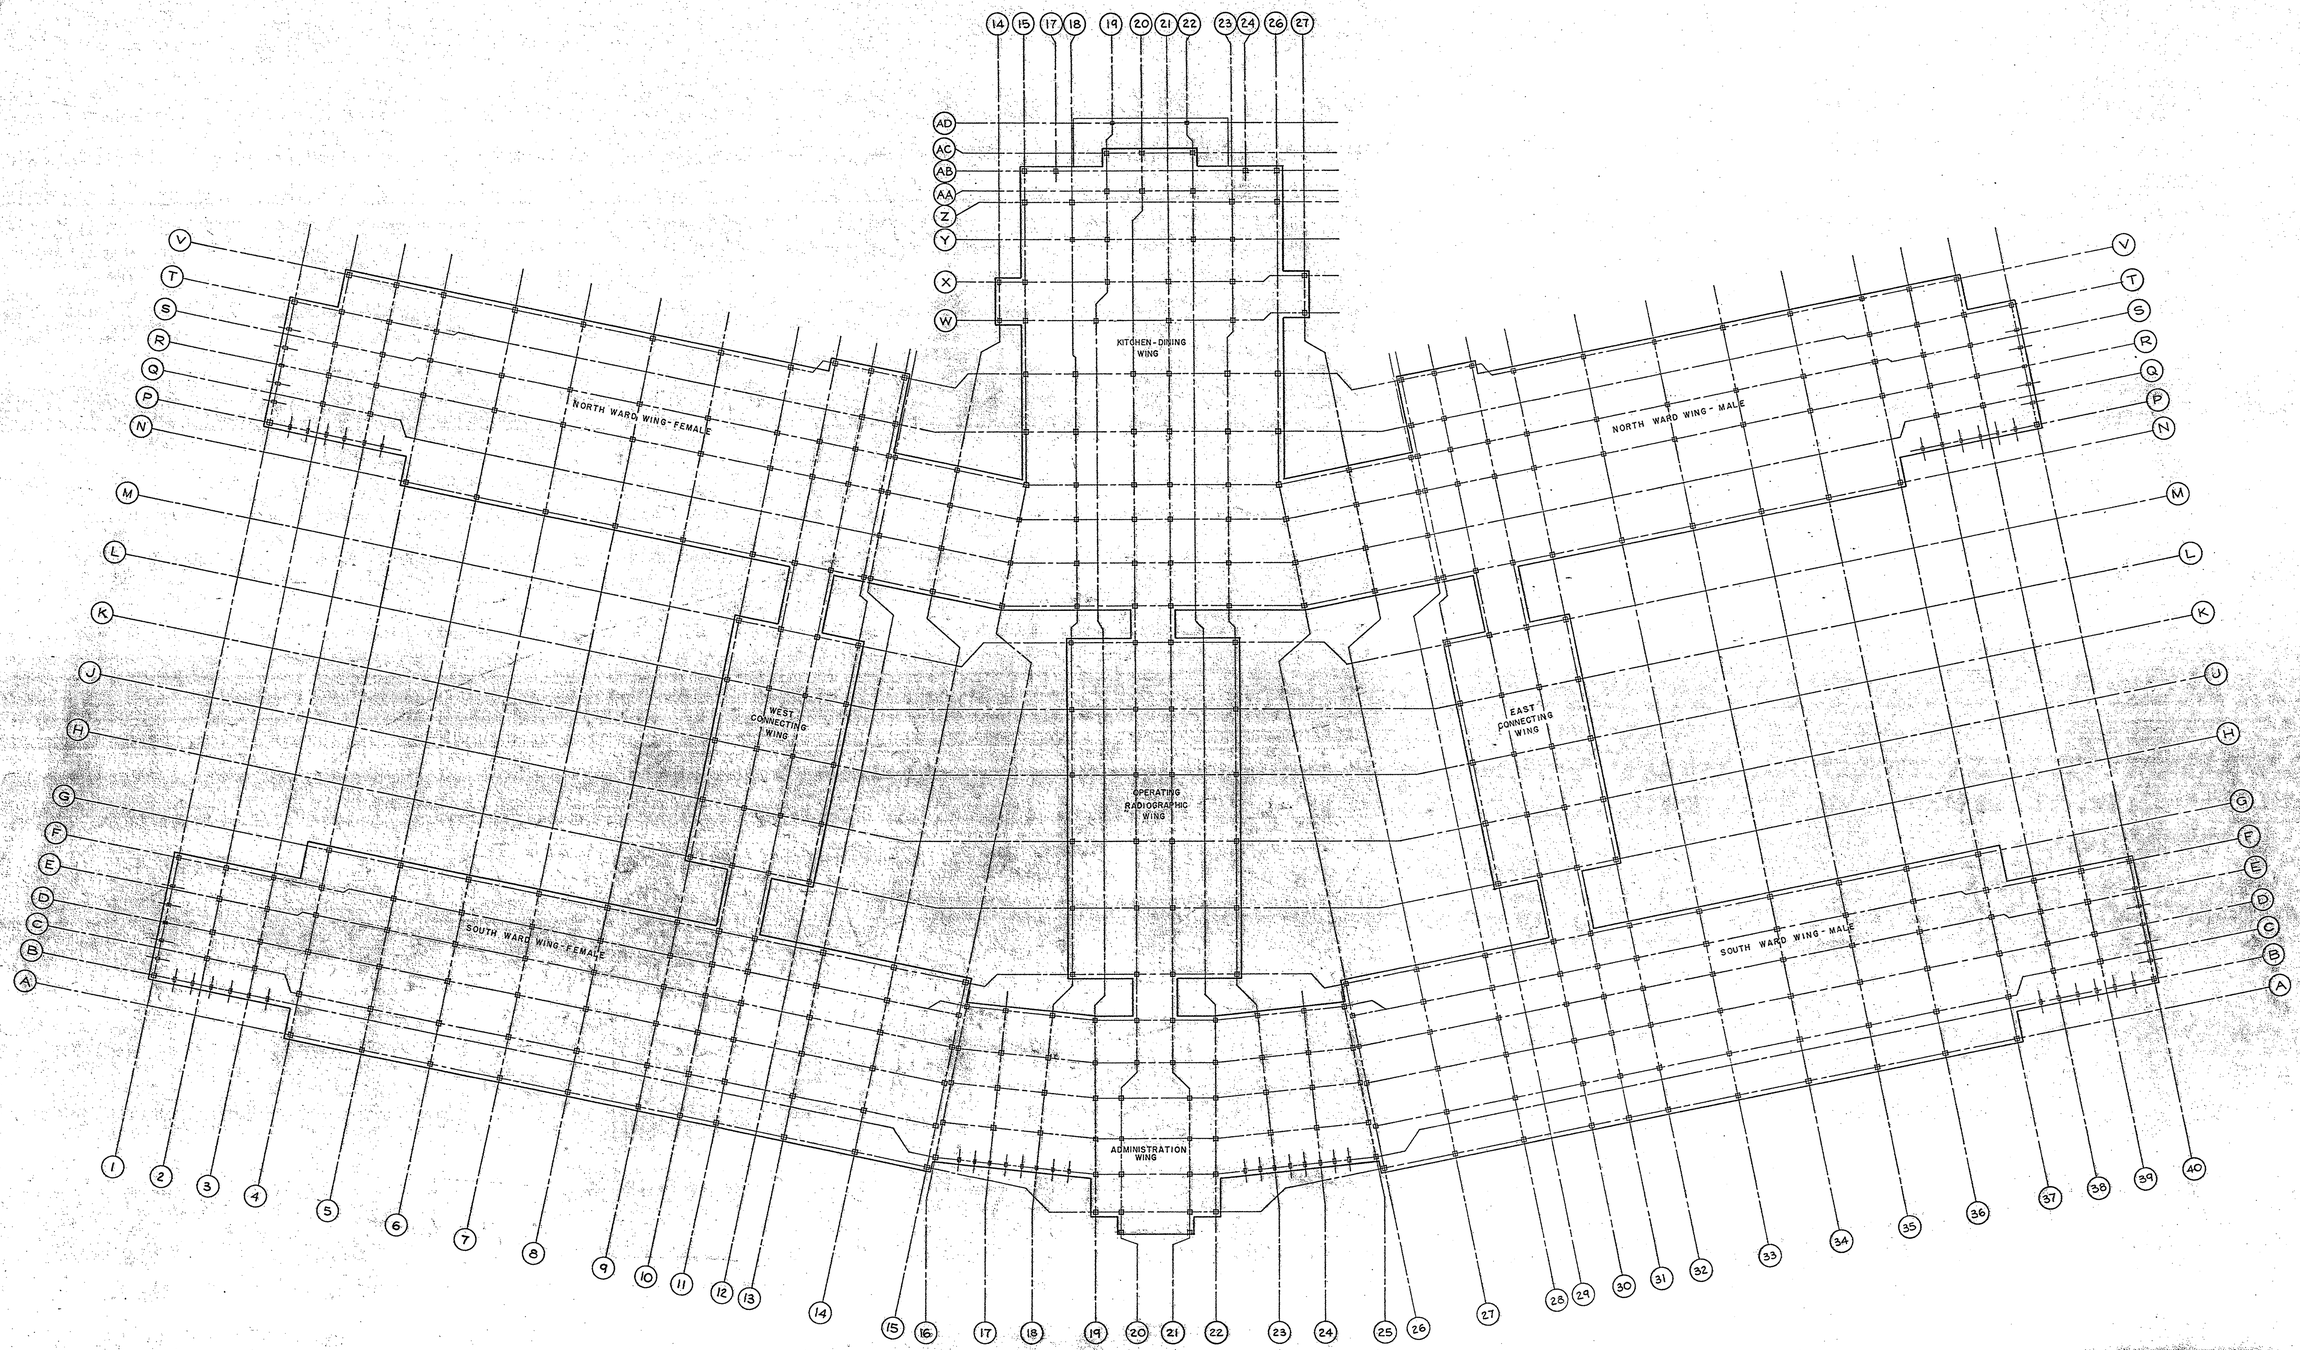

ALL DIMENSIONS AND EXISTING CONDITIONS SHALL BE CHECKED AND VERIFIED BY THE CONTRACTOR AT THE SITE

APPROVED
Commonwealth of Pennsylvania
DEPARTMENT OF WELFARE
Architect [signature] Date 1-13-50
Secretary _____ Date _____

Allen M. Davis

William H. Poole

REVISED	
	"AS BUILT" MARCH 10, '52

THE GENERAL STATE AUTHORITY

APPROVED [signature] 1-18-50
EXECUTIVE DIRECTOR
APPROVED [signature]
CONSULTING ENGINEER
SUBMITTED Allen M. Davis William H. Poole
ARCHITECTS
APPROVED [signature]
DEPT. OF WELFARE
APPROVED [signature] 11/9/52
DEPT. OF PROPERTY & SUPPLIES
APPROVED [signature]
DEPT. OF HEALTH
ACCEPTED
CONTRACTOR BY
ACCEPTED
CONTRACTOR BY
ACCEPTED
CONTRACTOR BY

PROJECT No. GSA - 510-1

PHILADELPHIA STATE HOSPITAL
PHILADELPHIA PENNSYLVANIA

TUBERCULAR PATIENTS' BUILDING N-10
COLUMN LAYOUT

DAVIS AND POOLE
112 S. 16th ST.
REGISTERED ARCHITECTS
PHILADELPHIA, PENNA.

1949 PROGRAM
DATE JAN. 16 1950
SCALE 1/16"-1'-0"

THE GENERAL STATE AUTHORITY
JAMES H. DUFF PRESIDENT
OSCAR N. LINDARL EXEC. DIRECTOR
HARRISBURG, PENNSYLVANIA

SHEET No. A-3

CHECKED FOR G. S. A.

SUPV. ARCH.	ARCH.	STRUCT.	MECH.	ELEC.
JOE 1/31/50	AVR H.E.B 1/31/50	EM 1/13/50		