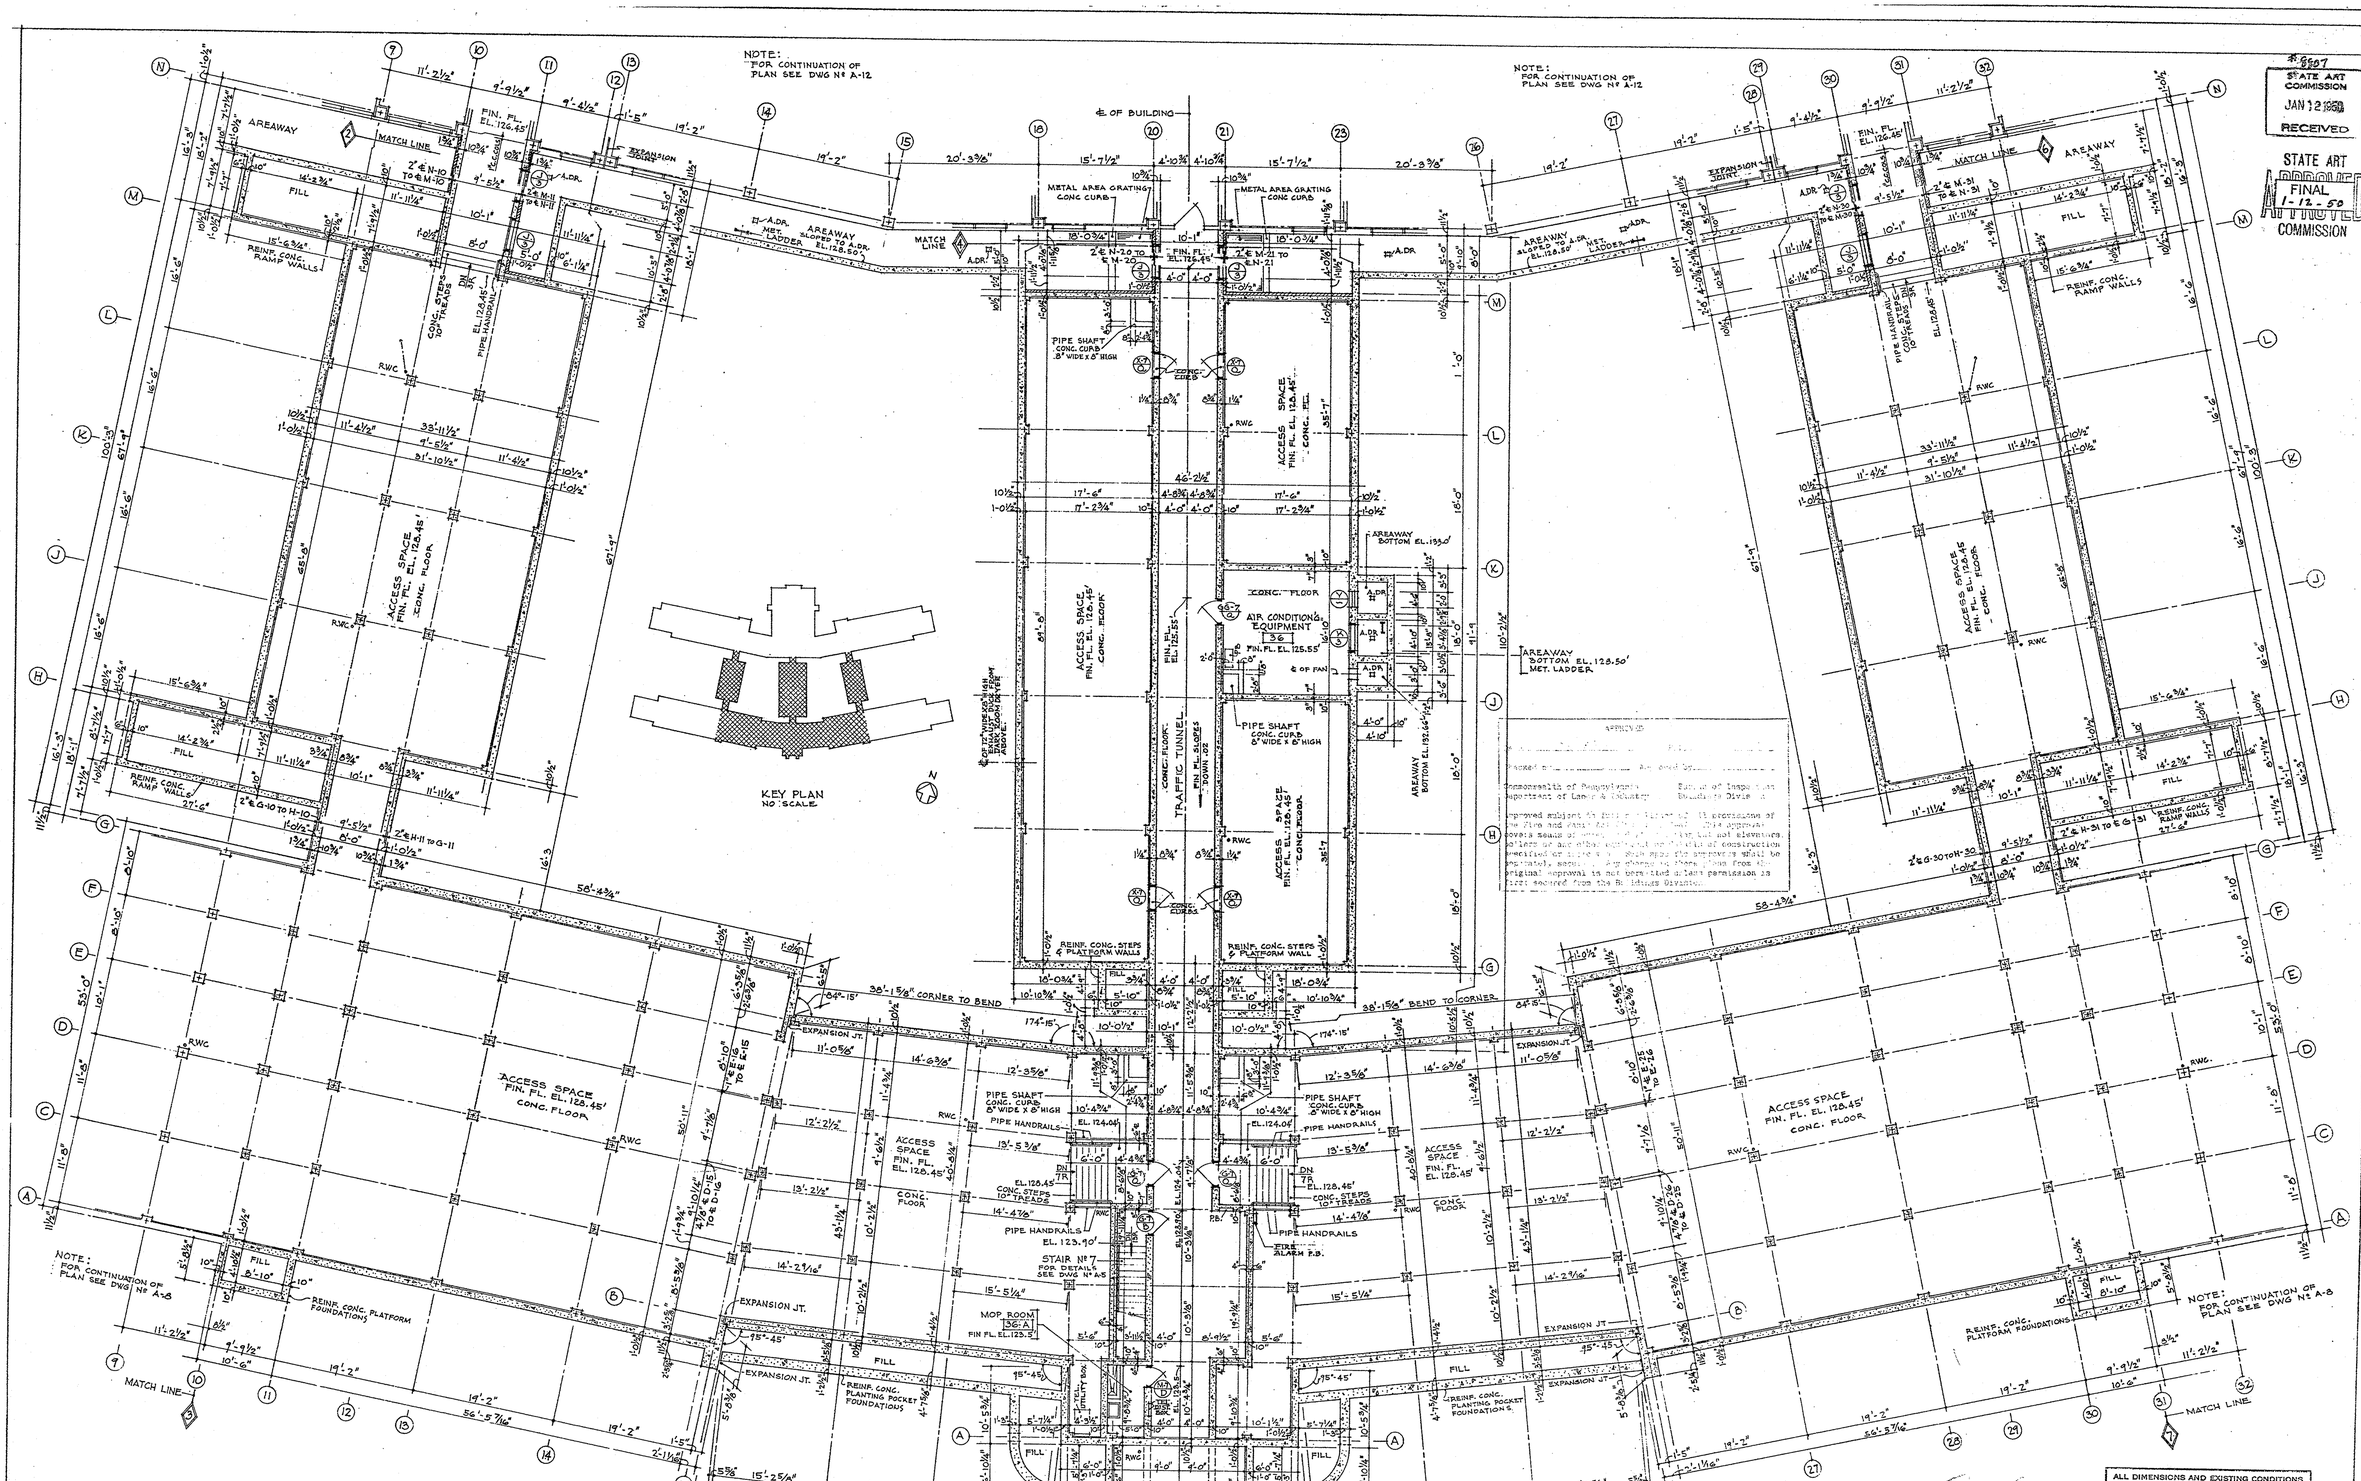

BASEMENT FLOOR ADMINISTRATION WING-ETC		SCHEDULE OF ROOM FINISHES									
		FLOOR	BASE			WALL	WINB. STOOL	CEILING		BEAM & GIRDER	REMARKS
SPACE	NUMBER	MAT.	MAT.	TYPE	HT.	MAT.		MAT.	TYPE		
AIR CONDITION'G EQUIP.	36	CONC.	N	N	N	EXP. CONC.	N	EXP. CONC.	N	EXP. CONC.	
MOPS	36-A	CONC.	N	N	N	EXP. CONC.	N	EXP. CONC.	N	EXP. CONC.	CEM. MOP TROUGH WITH 6" x 6" CEM. CURB. MOP RACK
TRAFFIC TUNNEL	—	CONC.	N	N	N	EXP. CONC.	N	EXP. CONC.	N	EXP. CONC.	
ACCESS SPACES	—	CONC.	N	N	N	EXP. CONC.	N	EXP. CONC.	N	EXP. CONC.	
STAIR Nº 7	—	CONC.	N	N	N	EXP. CONC.	N	EXP. CONC.	N	EXP. CONC.	ABRASIVE CEM. TREADS AND LANDINGS. - PIPE RAILINGS.
STEPS	—	CONC.	N	N	N	EXP. CONC.	N	EXP. CONC.	N	EXP. CONC.	ABRASIVE CEM. TREADS. - PIPE RAILINGS.

BASEMENT FLOOR PLAN OF ADMINISTRATION WING - PARTIAL SOUTH WARD WINGS - RADIOGRAPHIC & OPERATING WING - EAST & WEST CONNECTING WINGS.
SCALE 1/8" = 1'-0"

REVISED
AS BUILT MARCH 16, '52

THE GENERAL STATE AUTHORITY

APPROVED Oscar N. Lindahl 1-18-50 EXECUTIVE DIRECTOR
APPROVED DIRECTOR, ENGINEER
SUBMITTED ARCHITECTS
APPROVED DEPT. OF WELFARE
APPROVED 1/19/50 DEPT. OF PROPERTY & SUPPLIES
APPROVED DEPT. OF HEALTH
ACCEPTED CONTRACTOR BY
ACCEPTED CONTRACTOR BY
ACCEPTED CONTRACTOR BY

PROJECT No. - GSA - 510-1

PHILADELPHIA STATE HOSPITAL

PHILADELPHIA PENNSYLVANIA

TUBERCULAR PATIENTS' BUILDING N-10
BASEMENT PLAN
ADMINISTRATION & CONNECTING WINGS
DAVIS AND POOLE REGISTERED ARCHITECTS
112 S. 16th ST. PHILADELPHIA, PENNA.

1949 PROGRAM DATE	THE GENERAL STATE AUTHORITY	SHEET No.
JAN. 16 1950 SCALE 1/8" = 1'-0"	JAMES H. DUFF PRESIDENT; OSCAR N LINDAHL EXEC. DIRECTOR; HARRISBURG, PENNSYLVANIA	A-6

CHECKED FOR G.S.A.

SUPV. ARCH.	ARCH.	STRUCT.	MECH.	ELEC.
Jan 16 '50				