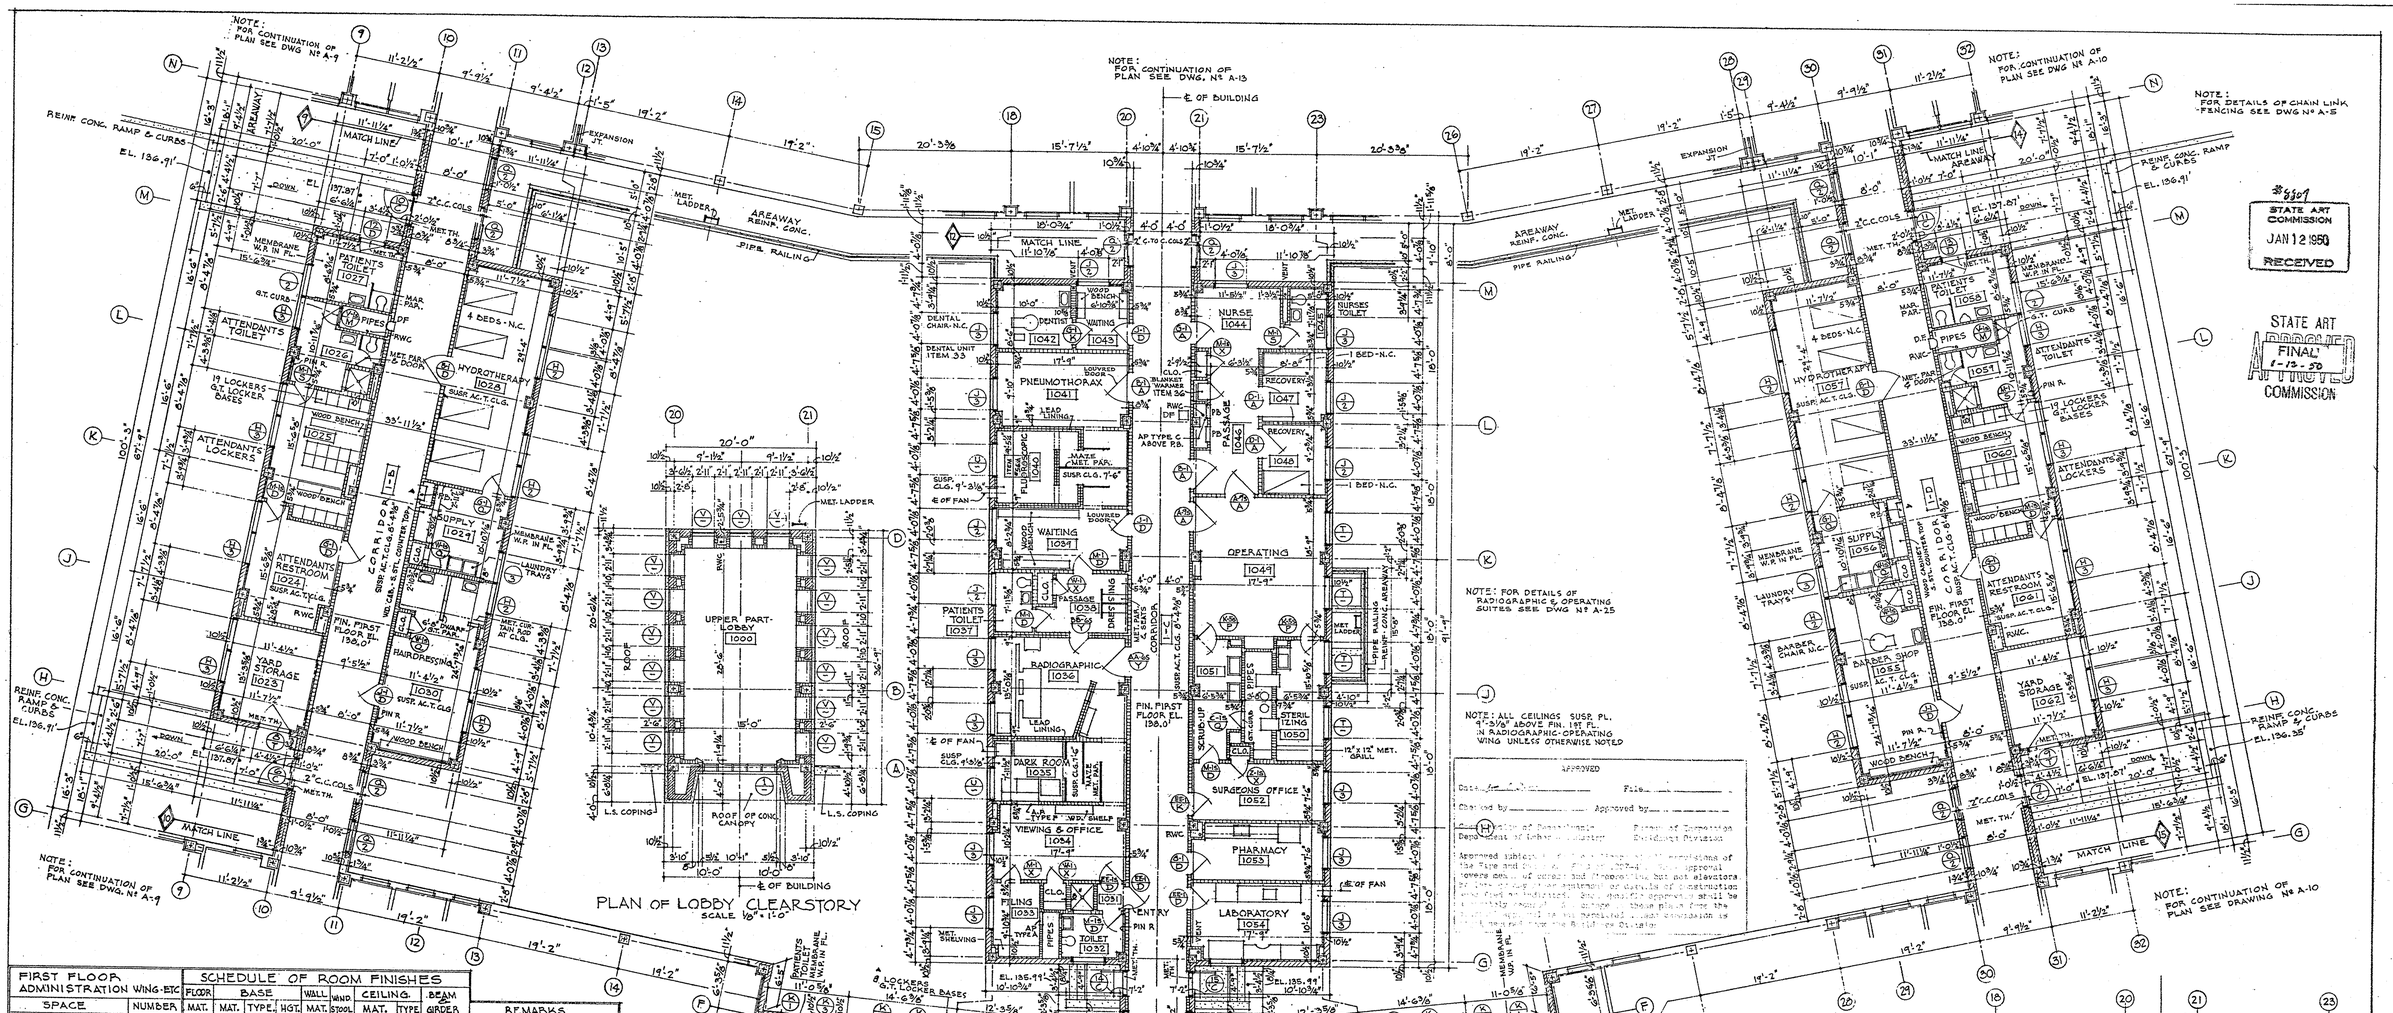

OBSCURE GLASS IN SASH IN ROOMS Nº: CLEARSTORY WINDOWS IN 1000; 1001, 1003, 1004, 1005, 1006, 1007, 1008, 1009, 1011, 1013, 1014, 1016, 1019, 1022, 1024, 1025, 1026, 1027, 1032, 1034, 1041, 1045, 1058, 1059, 1060, 1061, 1020, 1057.

SCHEDULE OF ROOM FINISHES

FIRST FLOOR ADMINISTRATION WING-ETC

SPACE	NUMBER	FLOOR MAT.	BASE MAT.	BASE TYPE	BASE HGT.	WALL MAT.	WAINSCOT STOOL	CEILING MAT.	CEILING TYPE	BEAM GIRDER	REMARKS
LOBBY	1000	TER.	MAR.	FLUSH	0"	MAR.	MAR.	PL	SUSP	N	COFFERED PL. CLG.
VISITORS TOILET	1001-1022	CER.T.	G.T.	COVE	5 3/4"	G.T.	G.T.	PL	SUSP	N	MET. TOILET PAR.- MIRROR
VISITORS	1002	TER.	G.T.	COVE	5 3/4"	G.T.	G.T.	AC. T.	SUSP	N	3'-6" GT DWARF PAR.
PATIENTS TOILET	1003-1014	CER.T.	G.T.	COVE	5 3/4"	G.T.	N	PAINT CONC	N	PAINT CONC	SP. ST. TOILET PAR. MEMBRANE W.P. IN FLOOR
NURSES RESTROOM NURSES LOCKERS	1004-1005	TER.	G.T.	COVE	5 3/4"	G.T.	N	AC. T.	SUSP	PAINT CONC	G.T. LOCKER BASES
NURSES TOILET	1006	CER.T.	G.T.	COVE	5 3/4"	G.T.	N	PAINT CONC	N	PAINT CONC	MET. TOILET PAR. - SUSP. KEENE CEM. SHOWER CLG. - MIRROR
WOMENS TOILET MENS TOILET	1007-1009	CER.T.	G.T.	COVE	5 3/4"	G.T.	N	PAINT CONC	N	PAINT CONC	MET. TOILET PAR. MIRROR
WOMENS RESTROOM	1008	TER.	G.T.	COVE	5 3/4"	G.T.	N	AC. T.	SUSP	PAINT CONC	
MOP ROOM	1010	CER.T.	G.T.	COVE	5 3/4"	G.T.	N	PAINT CONC	N	PAINT CONC	CLOSET FL. + CEM. 5 3/4" HIGH. CLOSET CLG. - SUSP. PL. 8'-4 3/8" SP. ST. SHELVES - SEE DWG Nº A-25
EXAMINING	1011	TER.	G.T.	COVE	5 3/4"	G.T.	N	AC. T.	SUSP	PAINT CONC	
ASST. PHYSICIAN	1012	TER.	G.T.	COVE	5 3/4"	G.T.	N	AC. T.	SUSP	PAINT CONC	
ASST. PHYS. TOILET	1013	CER.T.	G.T.	COVE	5 3/4"	G.T.	N	PAINT CONC	N	PAINT CONC	MEDICINE CABINET
STORAGE	1015-1020	TER.	TER.	COVE	5 3/4"	PL.	N	PL.	SUSP.	N	WOOD SHELVES - SEE DWG Nº A-25
CHIEF PHYS. TOILET SUP. OF NURSES TOILET	1016-1019	CER.T.	G.T.	COVE	5 3/4"	G.T.	G.T.	PL.	SUSP.	N	MEDICINE CAB. IN 1016 & 1019
CHIEF PHYSICIANS OFFICE	1017	TER.	TER.	COVE	5 3/4"	PL	MAR.	AC. T.	SUSP.	N	MET. PICTURE MOLD.
SUPER OF NURSES OFFICE	1018	TER.	TER.	COVE	5 3/4"	PL	MAR.	AC. T.	SUSP.	N	MET. PICTURE MOLD
OFFICE	1021	TER.	TER.	COVE	5 3/4"	PL	MAR.	AC. T.	SUSP.	N	MET. PICTURE MOLD
CORRIDOR	1-A 1-B	T-2 T-2	G.T.	COVE	5 3/4"	G.T.	G.T.	AC. T.	SUSP	N	
YARD STORAGE	1023-1062	CEM.	G.T.	COVE	5 3/4"	G.T.	N	PAINT CONC	N	PAINT CONC.	
ATTENDANTS RESTROOM	1024-1061	TER.	G.T.	COVE	5 3/4"	G.T.	N	AC. T.	SUSP	PAINT CONC.	
ATTENDANTS LOCKERS	1025-1060	TER.	G.T.	COVE	5 3/4"	G.T.	N	PAINT CONC	N.	PAINT CONC.	G.T. LOCKER BASES
ATTENDANTS TOILET	1026-1059	CER.T.	G.T.	COVE	5 3/4"	G.T.	N	PAINT CONC	N	PAINT CONC	MET. TOILET PAR. - SUSP KEENE CEM. SHOWER CLG. MIRROR
PATIENTS TOILET	1027-1058	CER.T.	G.T.	COVE	5 3/4"	G.T.	N	PAINT CONC	N	PAINT CONC	SP. ST. TOILET PAR. MEMBRANE W.P. IN FLOOR
HYDROTHERAPY	1028-1057	CER.T.	G.T.	COVE	5 3/4"	G.T.	N	AC. T.	SUSP	PAINT CONC.	
HYDRO. SUPPLY	1029-1056	CER.T.	G.T.	COVE	5 3/4"	G.T.	N	PAINT CONC	N	PAINT CONC	MEMBRANE W.P. IN FLOOR.
HAIRDRESSING BARBER SHOP	1030-1055	TER.	G.T.	COVE	5 3/4"	G.T.	N	AC. T.	SUSP	PAINT CONC.	WOOD BENCHES 6'-0" DWARF PAR. IN 1030
ENTRY	1031	TER.	G.T.	COVE	5 3/4"	G.T.	N	PL.	SUSP	N	
DOCTORS TOILET	1032	CER.T.	G.T.	COVE	5 3/4"	G.T.	N	PL.	SUSP	N	SUSP. KEENE CEM. SHOWER CLG. MEDICINE CAB.
FILING	1033	TER.	G.T.	COVE	5 3/4"	G.T.	N	PL.	SUSP.	N	MET. SHELVES - SEE DWG Nº A-25
VIEWING & OFFICE	1034	TER.	G.T.	COVE	5 3/4"	G.T.	N	PL.	SUSP.	N	WOOD SHELF - SEE DWG Nº A-25
DARK ROOM	1035	Q.T.	Q.T.	COVE	5 3/4"	G.T.	N	PL.	SUSP.	N	REMOVABLE MET. PAR. & PAINT UNGLAZED T. IN MAZE
RADIOGRAPHIC	1036	TER.	G.T.	COVE	5 3/4"	G.T.	N	PL.	SUSP.	N	LEAD LINED PAR.
PATIENTS TOILET	1037	CER.T.	G.T.	COVE	5 3/4"	G.T.	N	AC. T.	SUSP.	N	
PASSAGE	1038	TER	G.T.	COVE	5 3/4"	G.T.	N	PL.	SUSP.	N	MET. CUBICLE PAR. & SEATS
WAITING	1039	TER.	G.T.	COVE	5 3/4"	G.T.	N	PL.	SUSP.	N	WOOD BENCHES
FLUOROSCOPIC	1040	TER.	G.T.	COVE	5 3/4"	G.T.	N	PL.	SUSP.	N	LEAD LINED PAR. REMOVABLE MET. PAR & PAINT UNGLAZED T. IN MAZE
PNEUMOTHORAX	1041	TER.	G.T.	COVE	5 3/4"	G.T.	N	PL.	SUSP.	N	
DENTIST'S OFFICE & WAITING ROOM	1042-1043	TER	G.T.	COVE	5 3/4"	G.T.	N	PL.	SUSP.	N	WD. BENCHES IN 1043
NURSE	1044	TER.	G.T.	COVE	5 3/4"	G.T.	N	PL.	SUSP.	N	
NURSES TOILET	1045	CER.T.	G.T.	COVE	5 3/4"	G.T.	N	PL.	SUSP.	N	MIRROR
PASSAGE	1046	TER.	G.T.	COVE	5 3/4"	G.T.	N	PL.	SUSP.	N	
RECOVERY	1047-1048	TER.	G.T.	COVE	5 3/4"	G.T.	N	PL.	SUSP.	N	
OPERATING	1049	TER.	G.T.	COVE	5 3/4"	G.T.	N	PL.	SUSP.	N	TER. STRIP GRID IN FL
STERILIZING SCRUB-UP	1050-1051	TER.	G.T.	COVE	5 3/4"	G.T.	N	KEENE CEM.	SUSP.	N	
SURGEON	1052	TER.	G.T.	COVE	5 3/4"	G.T.	N	PL.	SUSP.	N	
PHARMACY LABORATORY	1053-1054	CER.T.	G.T.	COVE	5 3/4"	G.T.	N	PL.	SUSP.	N	
CLOSETS ADJ.	1017-1018-1020	TER.	TER.	COVE	5 3/4"	PL	N	PL.	SUSP	N	WOOD SHELVES - SEE DWG Nº A-25 SUSP. PL. CLG. 8'-4 3/4"
CLOSETS ADJ.	1012-1013-1032-1034-1022-1008	TER.	G.T.	COVE	5 3/4"	G.T.	N	" PL.	SUSP	N	WOOD SHELVES - SEE DWG Nº A-25 SUSP. PL. CLG 8'-4 3/4"
CLOSETS ADJ.	1029-1052-1056	CER.T.	G.T.	COVE	5 3/4"	G.T.	N	PL	SUSP	N	WOOD SHELVES - SEE DWG Nº A-25 SUSP. PL. CLG 8'-4 3/4"
PIPE SPACES		CEM.	N	N	N	EXPOSED CONC		EXPOSED CONC		EXP. CONC.	
PIPE SPACE ADJACENT	1050	CEM	G.T.	COVE	5 3/4"	2" INSULATION		EXPOSED CONC		EXP. CONC.	

REVISED	
A	AS BUILT MAR. 18, '52

THE GENERAL STATE AUTHORITY

APPROVED — EXECUTIVE DIRECTOR
APPROVED — DIRECTING ENGINEER
SUBMITTED — ARCHITECTS
APPROVED — DEPT. OF WELFARE
APPROVED — DEPT. OF PROPERTY & SUPPLIES
APPROVED — DEPT. OF HEALTH
ACCEPTED — CONTRACTOR BY
ACCEPTED — CONTRACTOR BY
ACCEPTED — CONTRACTOR BY

PROJECT No. - GSA - 510-1

PHILADELPHIA STATE HOSPITAL

PHILADELPHIA PENNSYLVANIA

TUBERCULAR PATIENTS' BUILDING N-10

FIRST FLOOR PLAN
ADMINISTRATION & CONNECTING WINGS

DAVIS AND POOLE — REGISTERED ARCHITECTS
112 S. 16th ST. — PHILADELPHIA, PENNA.

1949 PROGRAM
DATE JAN. 16 1950
SCALE 1/8" = 1'-0"

THE GENERAL STATE AUTHORITY
JAMES H. DUFF — PRESIDENT
OSCAR N. LINDAHL — EXEC. DIRECTOR
HARRISBURG, PENNSYLVANIA

SHEET No. A-7

CHECKED FOR G. S. A.

SUPV. ARCH.	ARCH.	STRUCT.	MECH.	ELEC.
FOR 1/14/52				