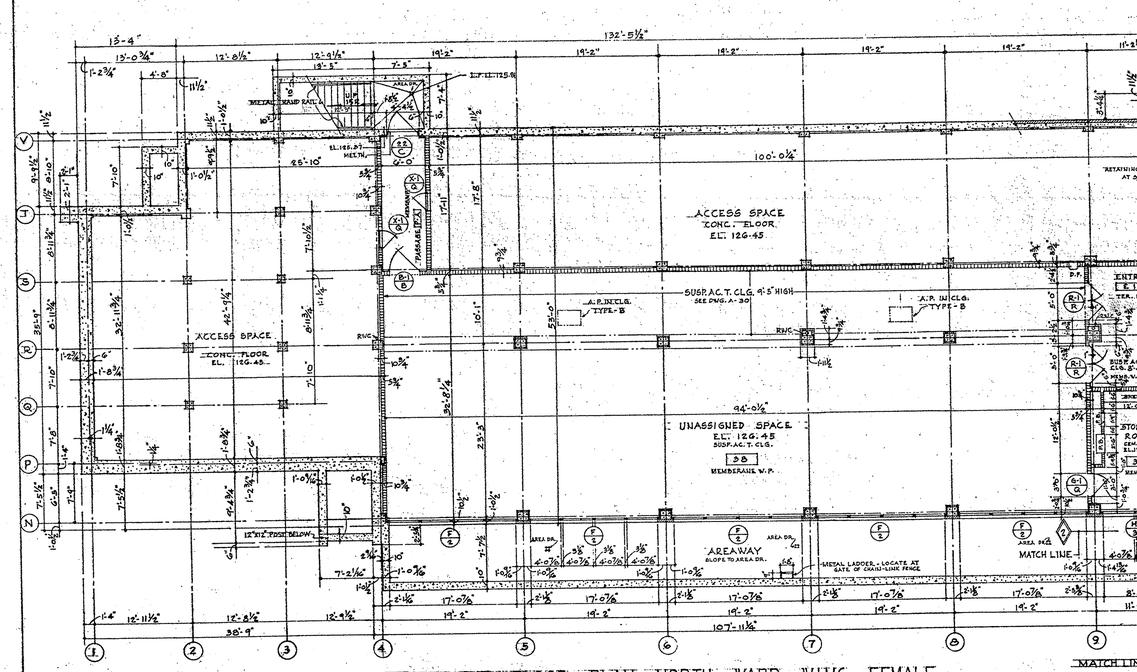

BASEMENT FLOOR PLAN - NORTH WARD WING - FEMALE
SCALE - 1/8" = 1'-0"

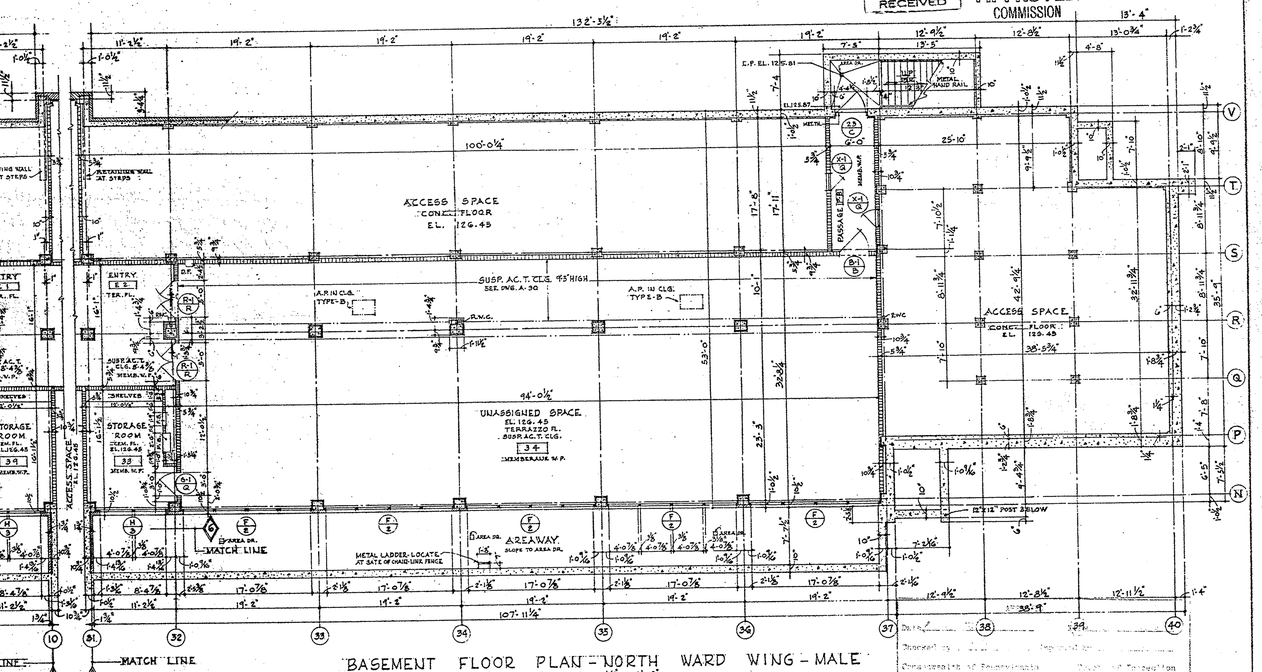

BASEMENT FLOOR PLAN - NORTH WARD WING - MALE
SCALE - 1/8" = 1'-0"

NOTE. FOR CONTINUATION OF PLAN - SEE DRAWING NO G AND NO 12.

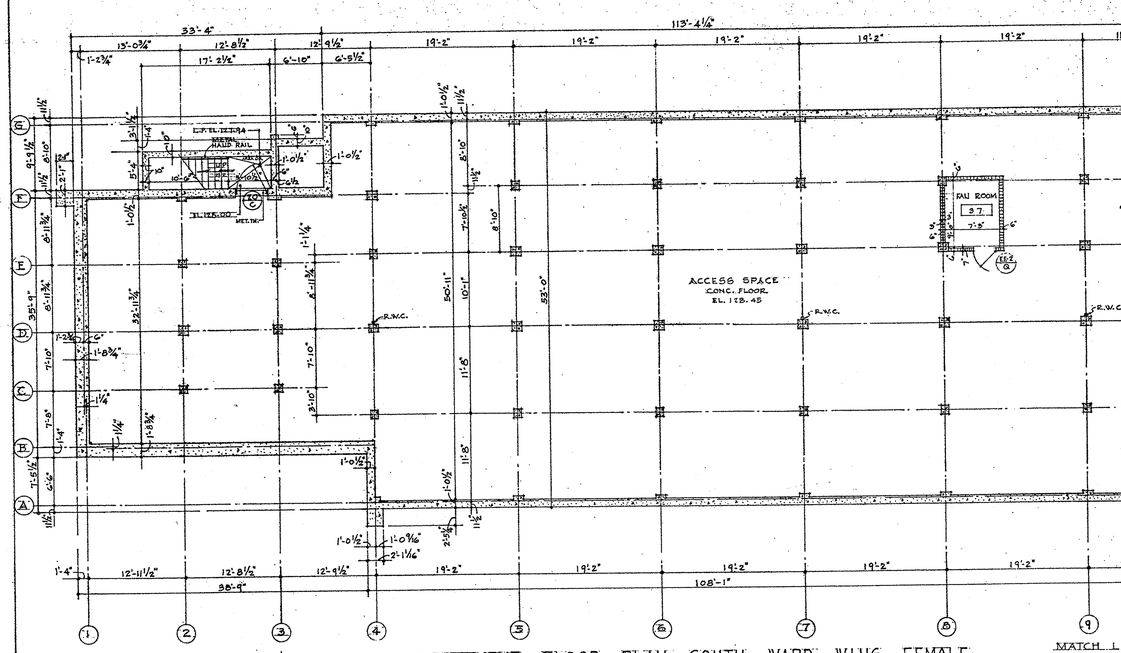

BASEMENT FLOOR PLAN - SOUTH WARD WING - FEMALE
SCALE - 1/8" = 1'-0"

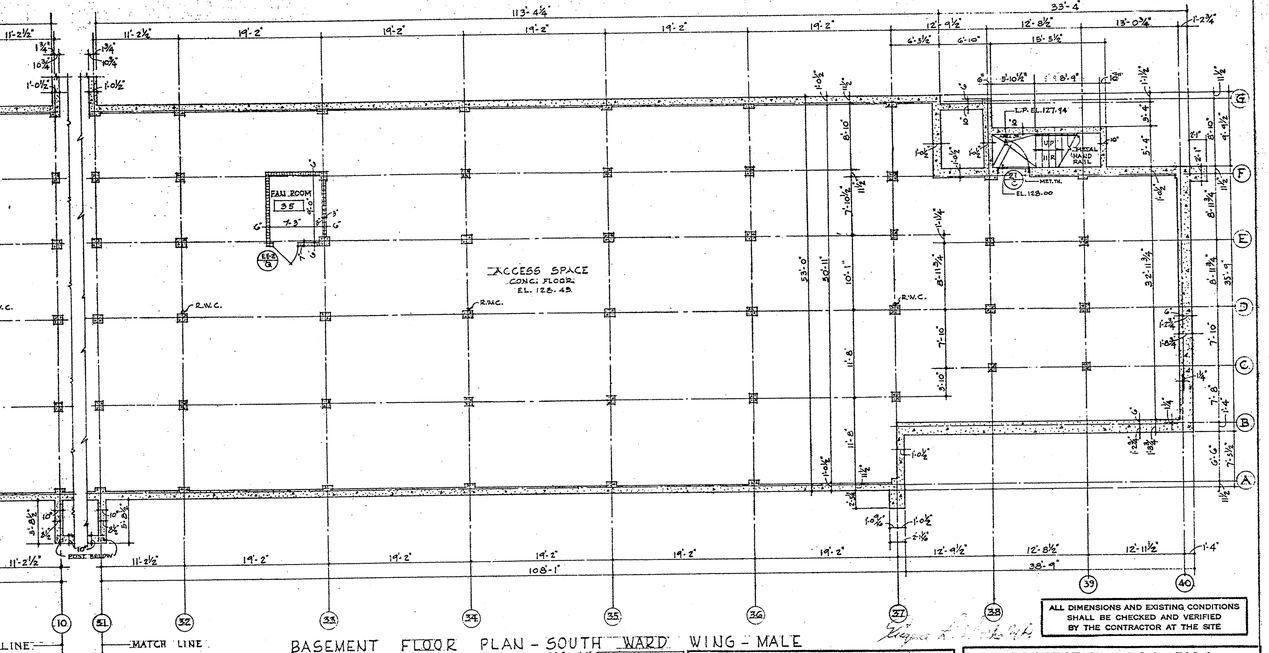

BASEMENT FLOOR PLAN - SOUTH WARD WING - MALE
SCALE - 1/8" = 1'-0"

NOTE. FOR CONTINUATION OF PLAN SEE DRAWING NO G.

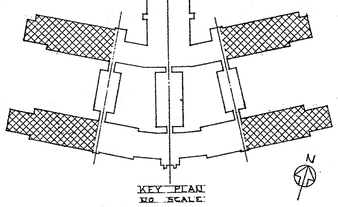

KEY PLAN
NO SCALE

BASEMENT FLOOR FEMALE & MALE WARD WINGS		SCHEDULE OF ROOM FINISHES								
		FLOOR	BASE			WALL	CEILING		BEAM AND GIRDER	REMARKS
SPACE	NUMBER	MATERIAL	MATERIAL	TYPE	HGT.	MATERIAL	MATERIAL	TYPE		
UNASSIGNED SPACES	34-38	TER.	G.T.	COVE	5 3/8"	G.T.	A.C.T.	SUSP.	PAINT CONC.	MEMBRANE W.P. IN FLOOR.
STORAGE ROOMS	33-39	CEM.	G.T.	COVE	5 3/8"	G.T.	EXP. CONC.	N	EXP. CONC.	MET. SHELVES — FOR DETAIL - SEE DWG. NO 25 MEMBRANE W.P. IN FLOOR.
ACCESS SPACES		CONC.	N	N	N	CONC. E.S.P.T.	EXP. CONC.	N	EXP. CONC.	
FAN ROOMS	35-37	CONC.	CONC.	COVE	5 7/8"	CONC. BL.	EXP. CONC.	N	EXP. CONC.	
ENTRIES	E1-E2	TER.	G.T.	COVE	5 3/8"	G.T.	A.C.T.	SUSP.	EXP. CONC.	MEMBRANE W.P. IN FLOOR.
PASSAGES	PA-PB	TER.	G.T.	COVE	5 3/8"	G.T.	PAINT CONC.	N	PAINT CONC.	MEMBRANE W.P. IN FLOOR.

STATE ART COMMISSION
APPROVED
1-12-50
PENNSYLVANIA

REGISTERED ARCHITECT PENNSYLVANIA

Commonwealth of Pennsylvania
DEPARTMENT OF WELFARE
Architect ... Date 1-5-50

Secretary ... Date ...

Approved subject to full compliance of all provisions of the Fire and Panic Act P.L.D. of 1927-47. This approval covers scope of agency and fireproofing only not elevators, kitchen or any other equipment or details of construction required or indicated. Each variation approvals shall be separately secured. Any change in these plans from the original approved plans shall be submitted for approval in the manner and form as set forth in 34 P.S. 1.101.

ALL DIMENSIONS AND EXISTING CONDITIONS SHALL BE CHECKED AND VERIFIED BY THE CONTRACTOR AT THE SITE

REVISED
AS BUILT MARCH 18, '52

THE GENERAL STATE AUTHORITY

APPROVED — EXECUTIVE DIRECTOR
APPROVED — DIRECTING ENGINEER
SUBMITTED — ARCHITECTS
APPROVED — DEPT. OF WELFARE
APPROVED — DEPT. OF PROPERTY & SUPPLIES
APPROVED — DEPT. OF HEALTH
ACCEPTED — CONTRACTOR BY
ACCEPTED — CONTRACTOR BY
ACCEPTED — CONTRACTOR BY

PROJECT No. - GSA - 510-1

PHILADELPHIA STATE HOSPITAL

PHILADELPHIA PENNSYLVANIA

TUBERCULAR PATIENTS' BUILDING N-10
BASEMENT FLOOR PLAN - WARD WINGS

DAVIS AND POOLE — REGISTERED ARCHITECTS
112 S. 16th ST. — PHILADELPHIA, PENNA.

1949 PROGRAM
DATE JAN. 16 1950
SCALE 1/8" = 1'-0"

THE GENERAL STATE AUTHORITY
JAMES H. DUFF — PRESIDENT
OSCAR N. LINDAHL — EXEC. DIRECTOR
HARRISBURG, PENNSYLVANIA

SHEET No. A-8

CHECKED FOR G.S.A.

SUPV. ARCH.	ARCH.	STRUCT.	MECH.	ELEC.