#8283
STATE ARCHITECT
APR 3, 1947
RECEIVED

STATE ARCHITECT
4-3-47
COMMISSION

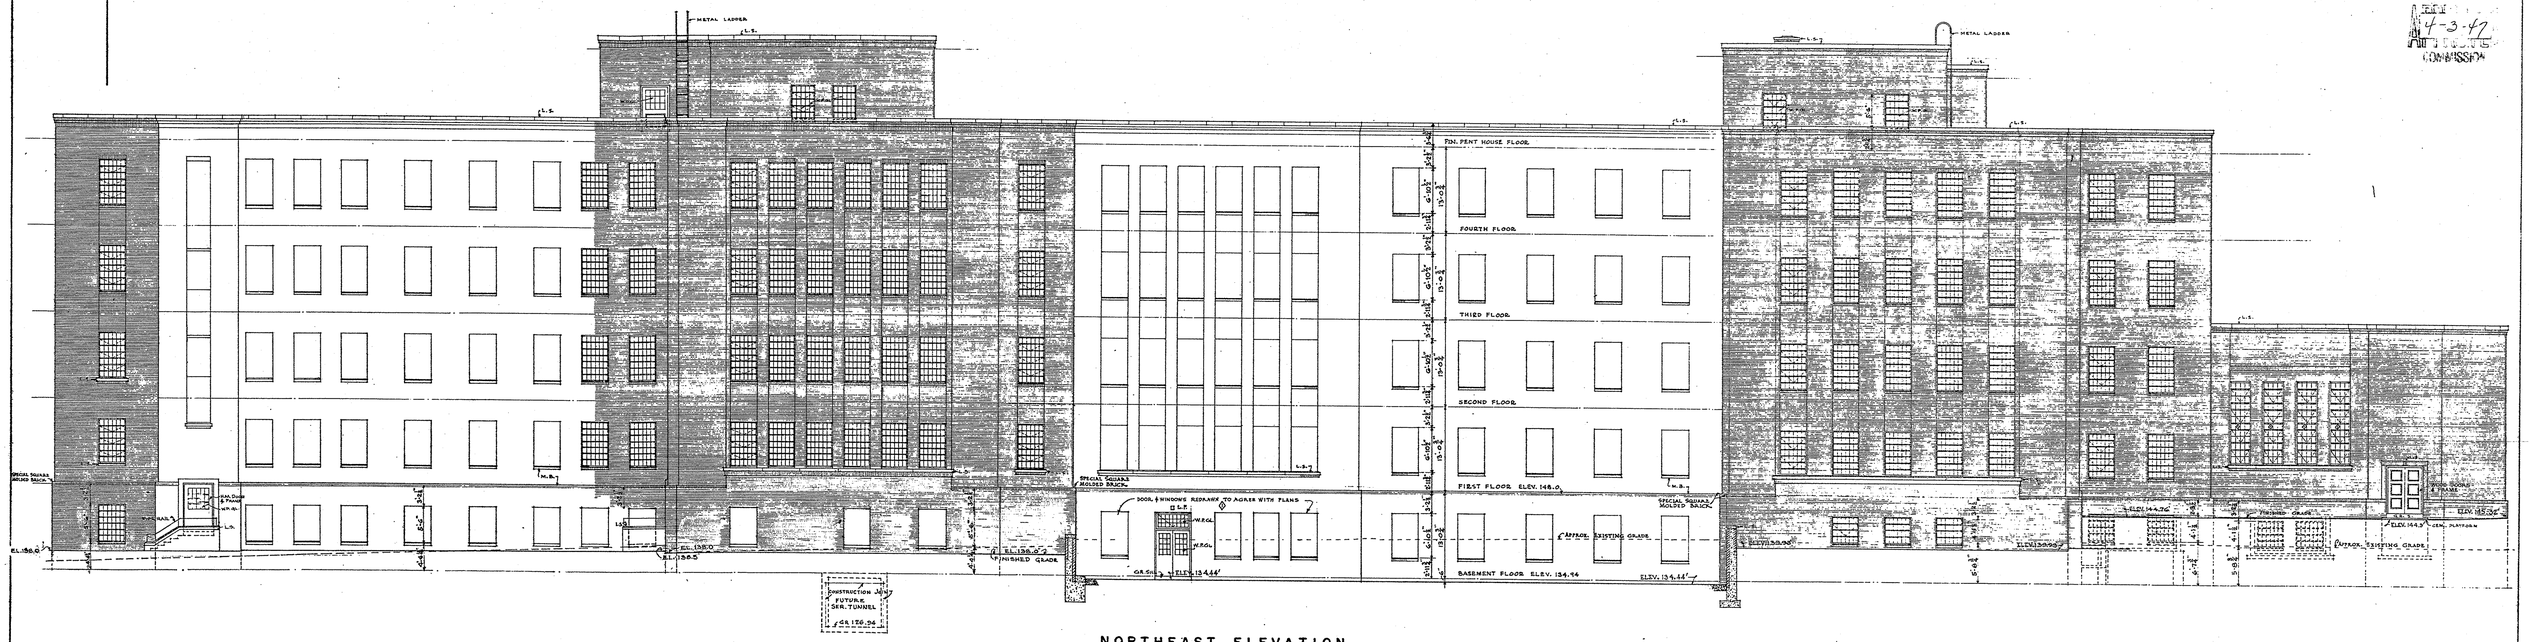

NORTHEAST ELEVATION

NOTES:
SEE SHEET 1R; FOR GENERAL NOTES & SYMBOLS
ALL BASEMENT WINDOWS TO HAVE EXTERIOR WIRE GUARDS
SEE STRUCTURAL DRAWINGS FOR LOCATION & DEPTH OF FOOTINGS
ALL EXTERIOR DOORS & FRAMES ARE HOLLOW METAL UNLESS NOTED OTHERWISE.

SPECIAL SQUARE BRICK AT ALL INTERNAL AND EXTERNAL CORNERS OF WATERTABLE.

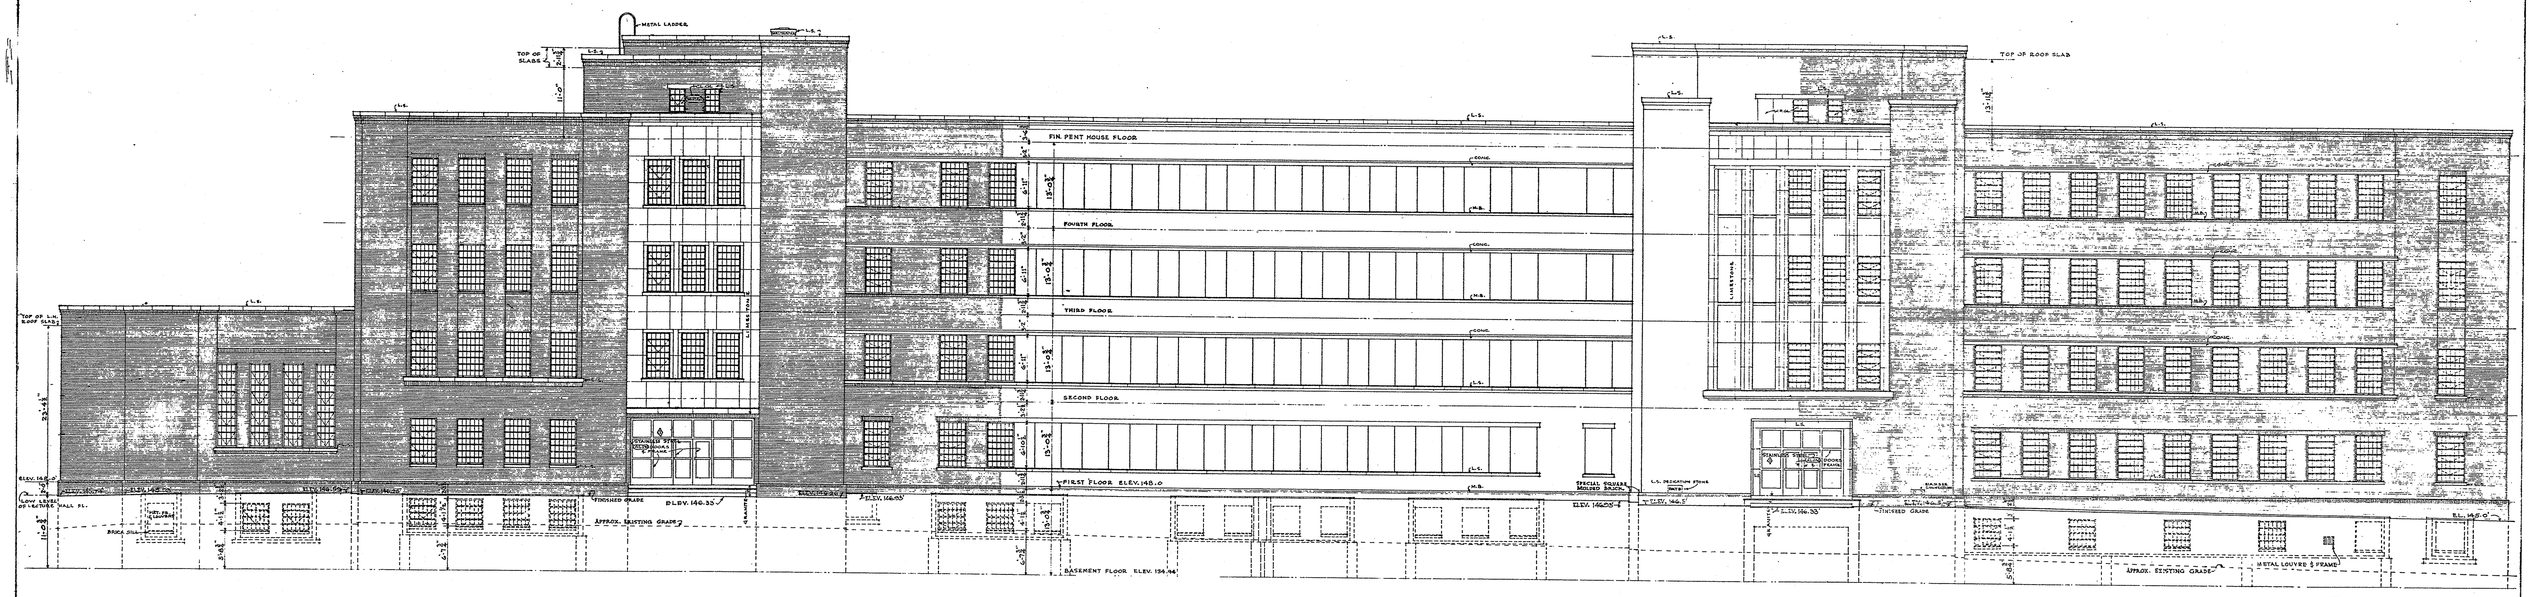

SOUTHWEST ELEVATION

APPROVED
Commonwealth of Pennsylvania
DEPARTMENT OF WELFARE
BUREAU OF BUILDING MANAGEMENT
Architect [signature] Date 4-30-47
[signature] Date 5-22-47

APPROVED
Commonwealth of Pennsylvania
Department of Labor & Industry
Bureau of Inspection
Buildings Section
Checked By
Approved By Chief
Approval Date

◊ REVISED AS CONSTRUCTED
1-16-1950

4-3-47

REVISED BY APPROVED
JAMES H. DUFF
GOVERNOR
DEPT. PROPERTY & SUPPLIES
C. M. WOOLWORTH
SECRETARY
HARRISBURG, PENNSYLVANIA

APPROVED	[signature] FOR THE SECRETARY OF PROPERTY & SUPPLIES
APPROVED	[signature] CHIEF CONSTRUCTION ENGINEER OF PROPERTY & SUPPLIES
APPROVED	
SUBMITTED	[signature] ARCHITECT
ACCEPTED	CONTRACTOR

REVISED

SOUTHWEST & NORTHEAST ELEVATIONS
ACTIVE THERAPY BUILDING N3
PHILADELPHIA STATE HOSPITAL
PHILADELPHIA PENNSYLVANIA
GEORGE W PEPPER, JR. REGISTERED ARCHITECT
225 S. 15TH. STREET PHILADELPHIA PA.

DATE	COMMONWEALTH OF PENNA.	SHEET NO
4-1-47	JAMES H. DUFF GOVERNOR	8
SCALE 1/8"=1'-0"	DEPT. PROPERTY & SUPPLIES C. M. WOOLWORTH SECRETARY HARRISBURG, PENNSYLVANIA	

3-6-3