#8283

4-3-47

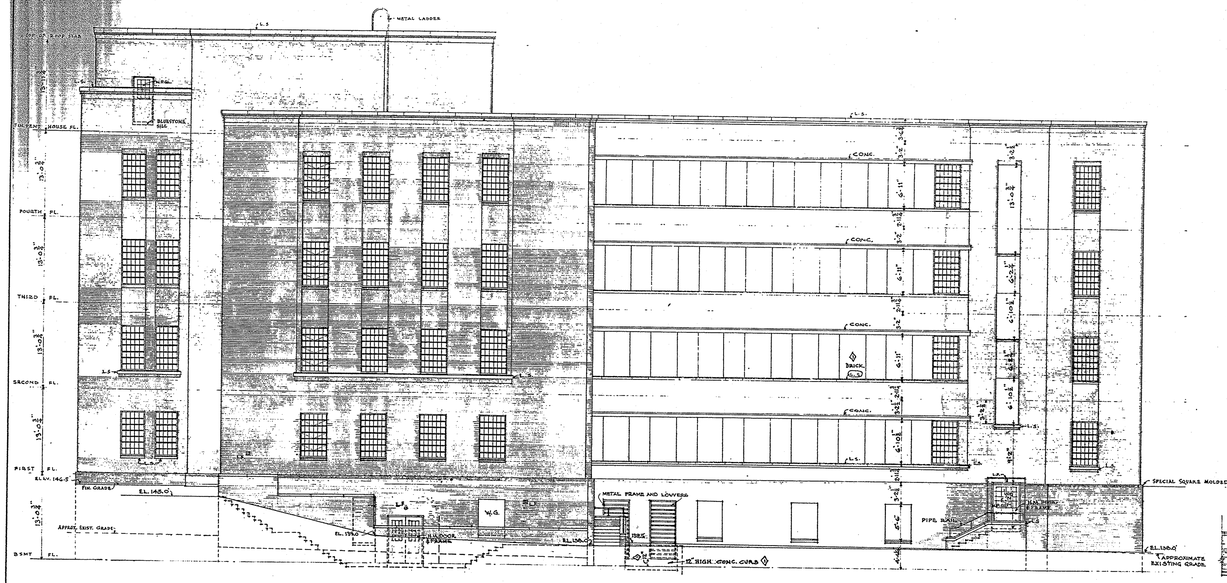

SOUTHEAST ELEVATION

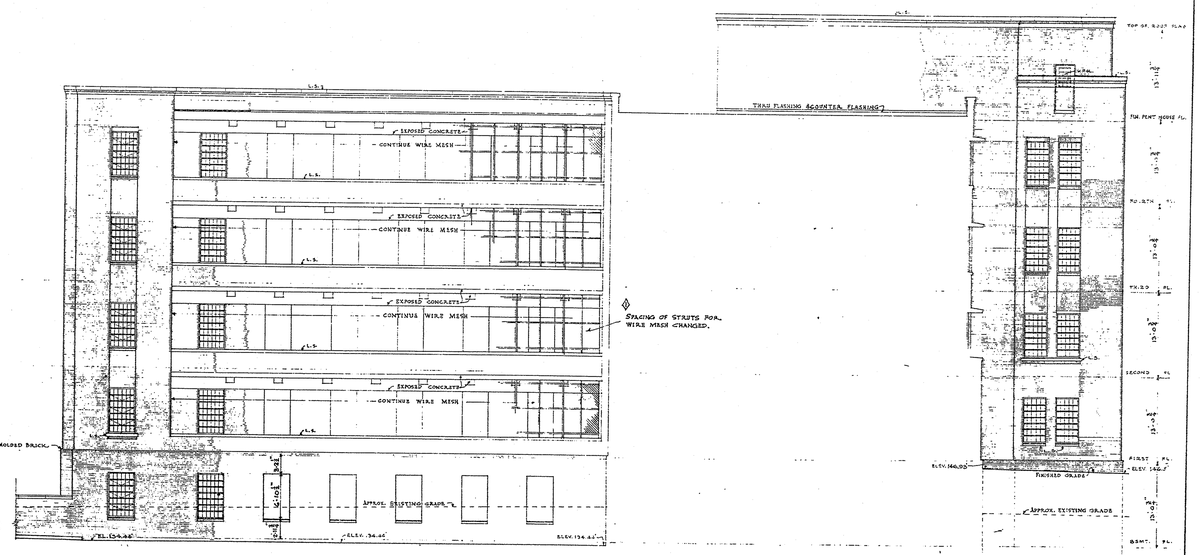

SECTION THRU SERVICE COURT LOOKING SOUTHEAST

SUB-BASEMENT LEVEL EL. 126.94

NOTES

SEE SHEET No 1 FOR GENERAL NOTES & SYMBOLS
ALL BASEMENT WINDOWS TO HAVE EXTERIOR WIRE GUARDS
SEE STRUCTURAL DRAWINGS FOR LOCATION & DEPTH OF FOOTINGS
ALL EXTERIOR DOORS & FRAMES ARE HOLLOW METAL UNLESS OTHERWISE S.C.

SPECIAL SQUARE MOULDED BRICK AT ALL INTERNAL AND EXTERNAL CORNERS OF WATERTABLE.

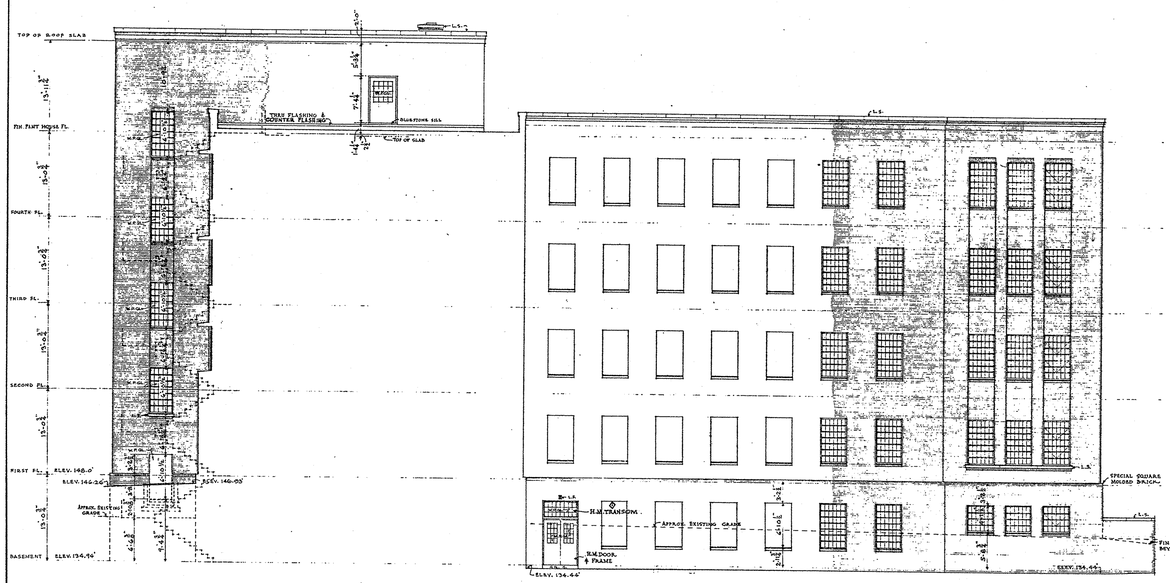

SECTION THRU SERVICE COURT LOOKING NORTHWEST

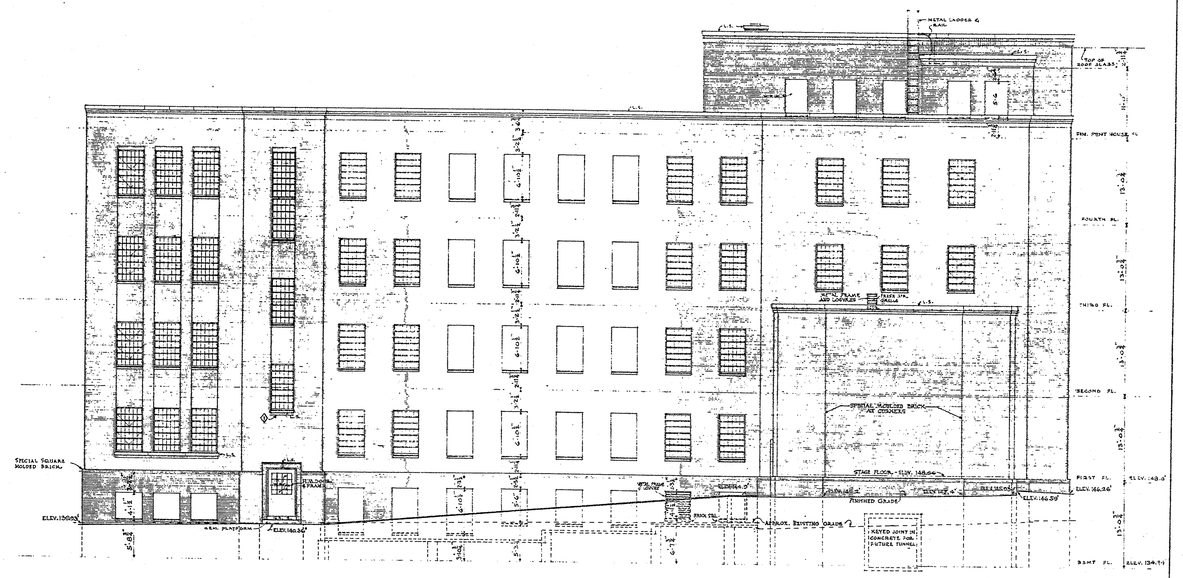

NORTHWEST ELEVATION

◊ REVISED AS CONSTRUCTED
1-16-1950

APPROVED
Commonwealth of Pennsylvania
DEPARTMENT OF WELFARE
BUREAU OF INSTITUTIONAL MANAGEMENT
Architect [signature] Date 4-10-47
Date
Secy. [signature] Date 5-22-47

APPROVED
Commonwealth of Pennsylvania
Department of Industry
Bureau of Inspection
Buildings Section
Checked By
Approved By Chief
Approval Date

APPROVED 4-3-47

REGISTERED ARCHITECT
PENNSYLVANIA
GEORGE W. PEPPER, JR.

APPROVED	[signature] SECRETARY OF PROPERTY & SUPPLIES
APPROVED	[signature] CHIEF CONSTRUCTION ENGINEER OF PROPERTY & SUPPLIES
APPROVED	
SUBMITTED	[signature] ARCHITECT
ACCEPTED	CONTRACTOR

REVISED

SIDE ELEVATIONS

ACTIVE THERAPY BUILDING N 3
FOR THE
PHILADELPHIA STATE HOSPITAL
PHILADELPHIA PENNSYLVANIA
GEORGE W. PEPPER, JR., REGISTERED ARCHITECT
225 SO. 15 TH. STREET PHILADELPHIA PA.

DATE	COMMONWEALTH OF PENNA.	SHEET NO.
4-1-47	JAMES H. DUFF GOVERNOR	9
SCALE 1/8" = 1'-0"	DEPT. PROPERTY & SUPPLIES C. M. WOOLWORTH SECRETARY HARRISBURG, PENNSYLVANIA	