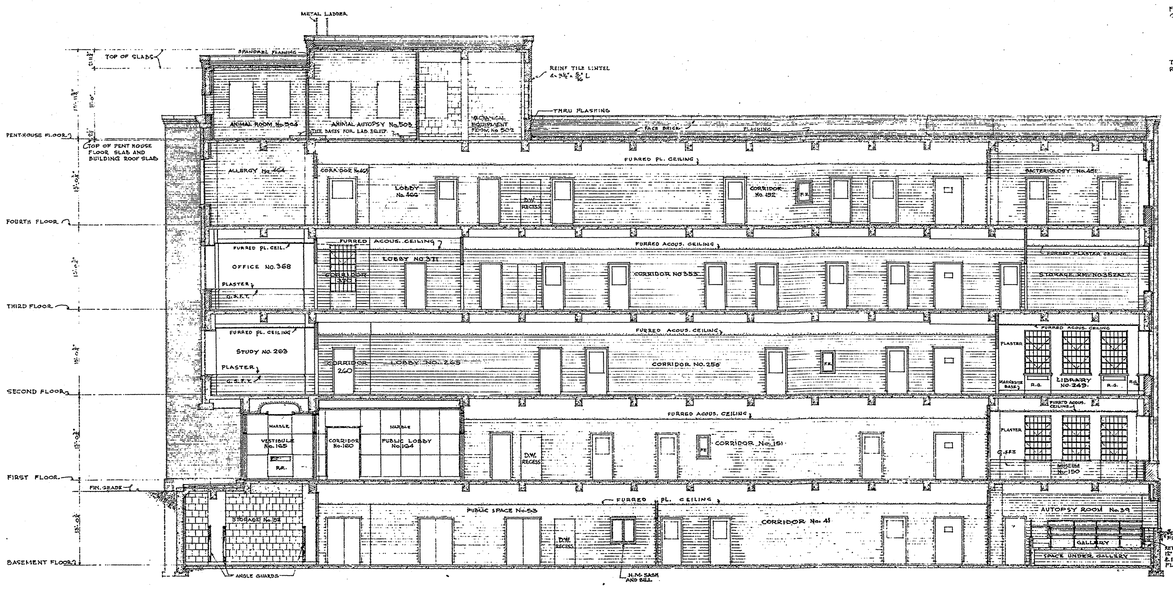

SECTION "A-A"
SCALE 1/8" = 1'-0"

· NOTE ·

ALL CORRIDOR PARTITIONS EXTEND TO FLOOR CONSTRUCTION ABOVE.

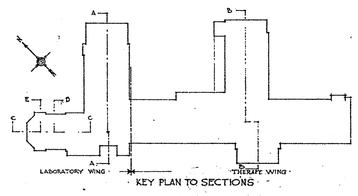

KEY PLAN TO SECTIONS

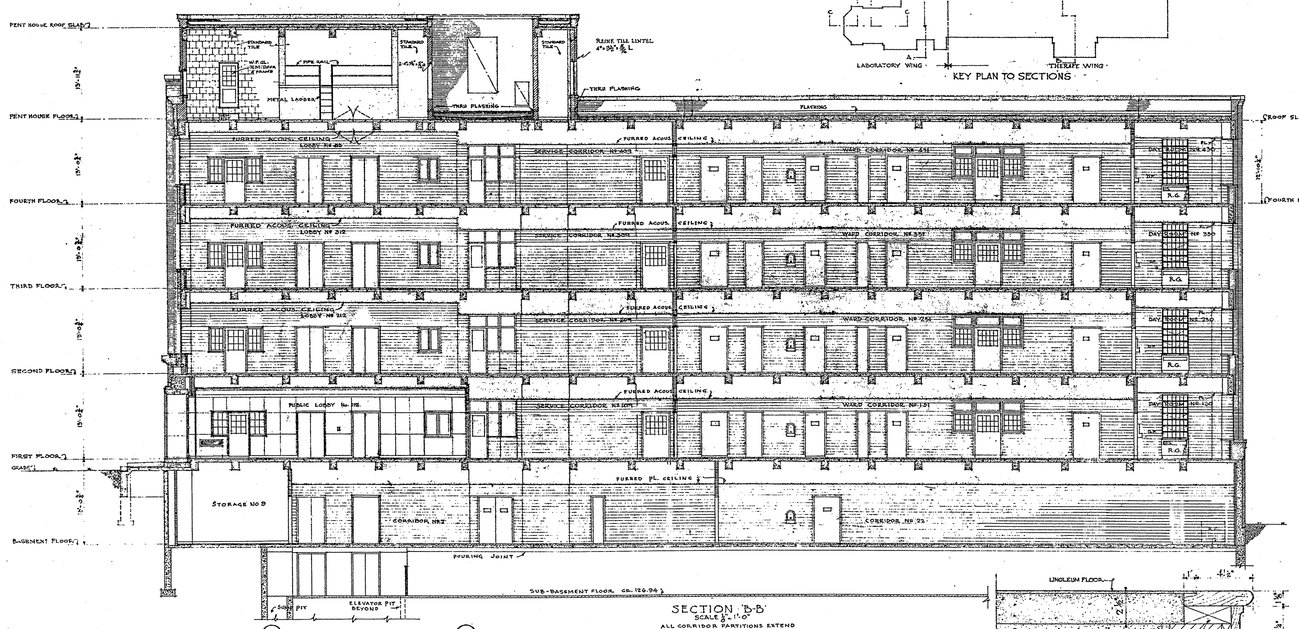

SECTION "B-B"
SCALE 1/8" = 1'-0"

ALL CORRIDOR PARTITIONS EXTEND TO FLOOR CONSTRUCTION ABOVE.

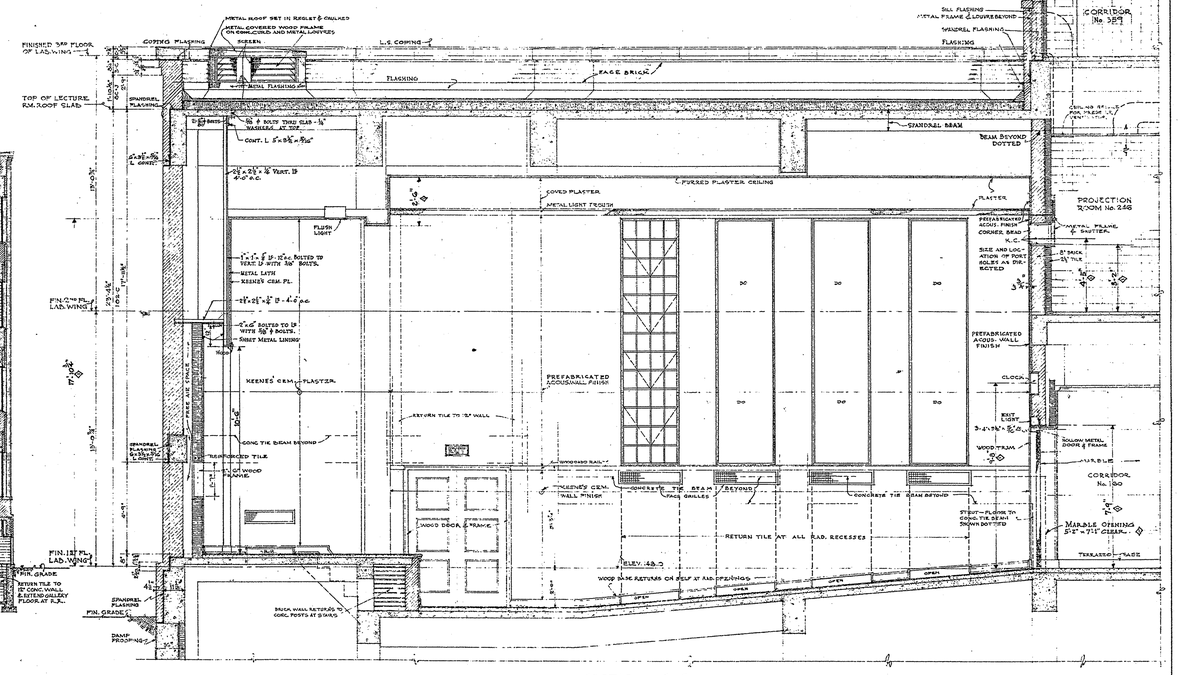

SECTION "C-C"
SCALE 1/8" = 1'-0"

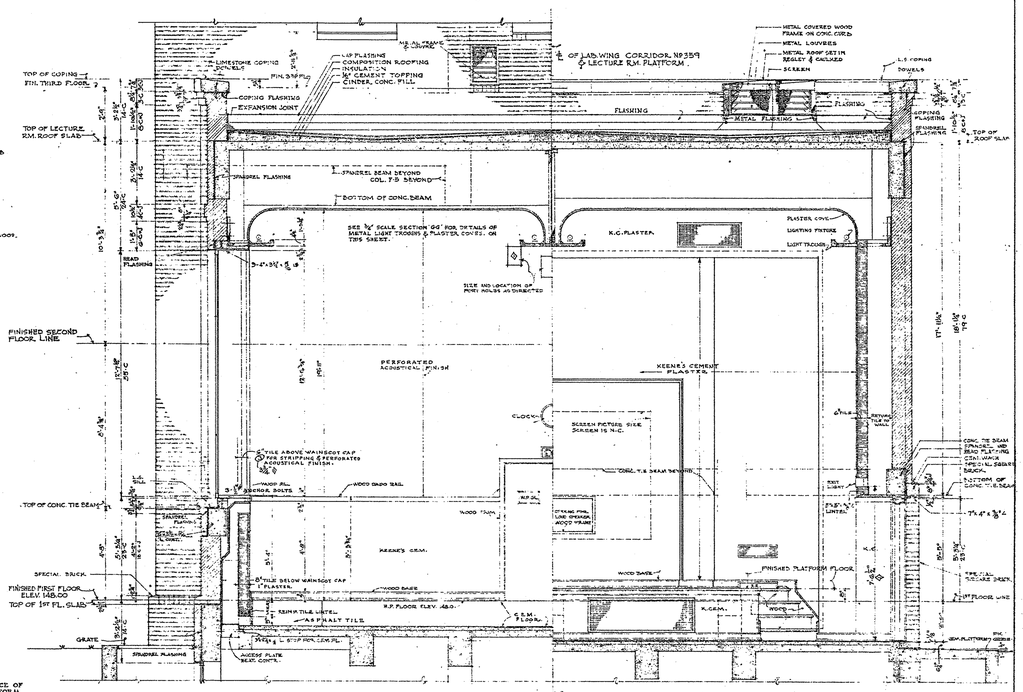

· HALF SECTION · D ·
SCALE 1/8" = 1'-0"

· HALF SECTION · E ·
SCALE 1/8" = 1'-0"

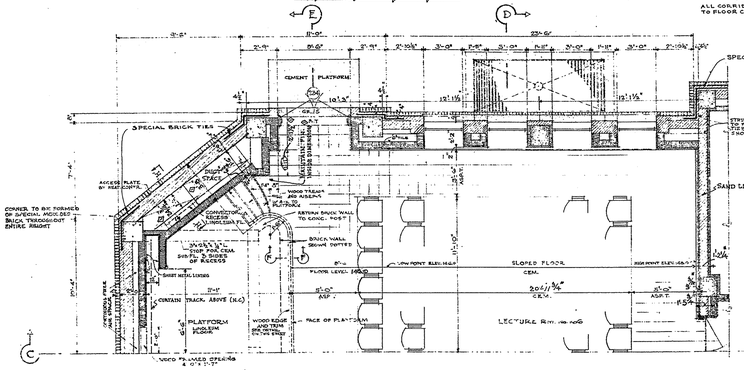

HALF PLAN OF LECTURE ROOM
SCALE 1/4" = 1'-0"

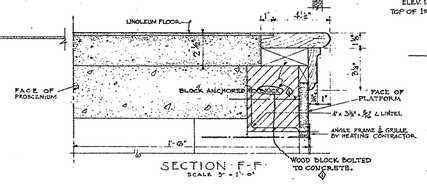

SECTION "F-F"
SCALE 3" = 1'-0"

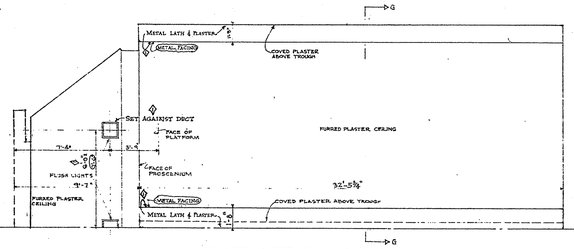

HALF REFLECTED CEILING PLAN · LECTURE ROOM ·
SYMETRICAL ABOUT "E"
SCALE 1/4" = 1'-0"

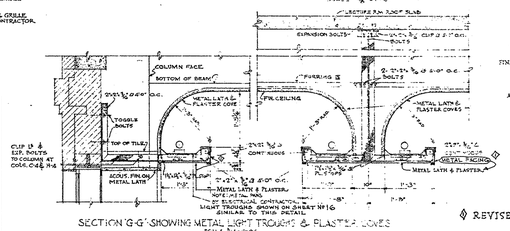

SECTION "GG" SHOWING METAL LIGHT TROUGH & PLASTER COVES
SCALE 3/4" = 1'-0"

NOTE: LIGHT TROUGH & PLASTER CEILING IN PUBLIC LOBBIES No. 104 SHOWN ON SHEET No. 16 ARE SIMILAR.

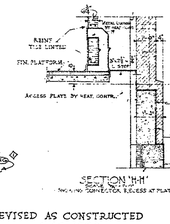

SECTION "HH"
SCALE 1/4" = 1'-0"

◊ REVISED AS CONSTRUCTED 1-16-1950

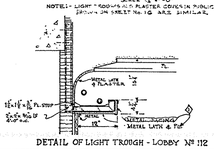

DETAIL OF LIGHT TROUGH - LOBBY No. 112

APPROVED
Commonwealth of Pennsylvania
DEPARTMENT OF WELFARE
BUREAU OF INSTITUTIONAL MANAGEMENT
Date 5-23-47
Chief
Date 5-23-47

APPROVED
Commonwealth of Pennsylvania
Department of Labor and Industry
Buildings Section
Checked By
Approved By
Chief
Approval Date

APPROVED	C. M. Woolworth SECRETARY OF PROPERTY & SUPPLIES
APPROVED	CHIEF CONSTRUCTION ENGINEER OF PROPERTY & SUPPLIES
APPROVED	
SUBMITTED	ARCHITECT
ACCEPTED	CONTRACTOR

REVISED

CROSS SECTIONS
LECTURE ROOM DETAILS

ACTIVE THERAPY BUILDING N 3
PHILADELPHIA STATE HOSPITAL
PHILADELPHIA PENNSYLVANIA

GEORGE W. PEPPER, JR., REGISTERED ARCHITECT
2.23 SO.13 TH. STREET PHILADELPHIA, PA.

DATE	COMMONWEALTH OF PENNA.	SHEET NO.
4-1-47	JAMES H. DUFF GOVERNOR DEPT. PROPERTY & SUPPLIES C. M. WOOLWORTH SECRETARY HARRISBURG, PENNSYLVANIA	10
SCALE AS NOTED		

3-6-3