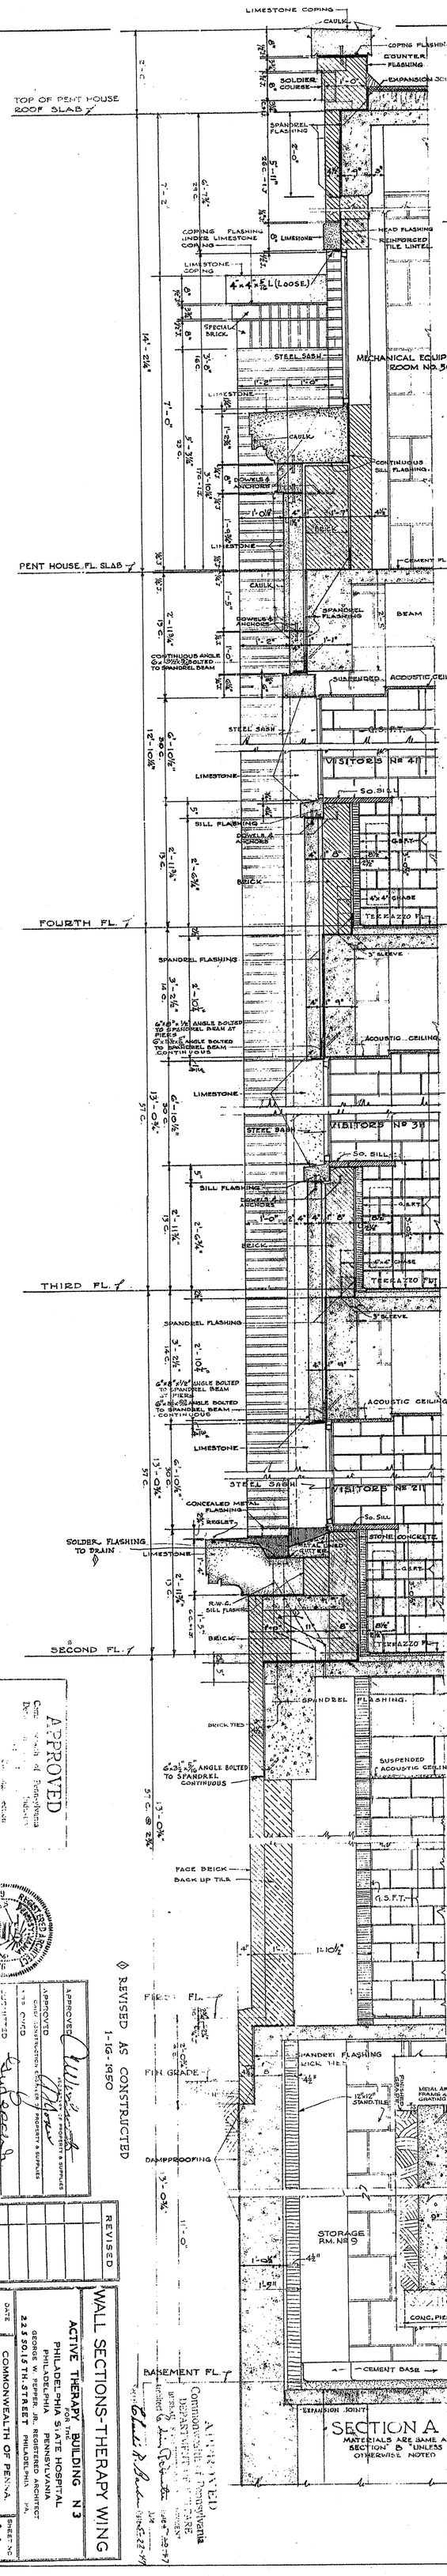

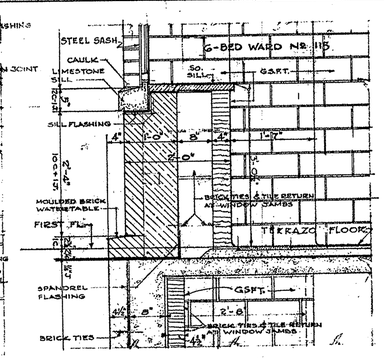

SECTION C

MATERIALS ARE SAME AS SECTION D UNLESS OTHERWISE NOTED

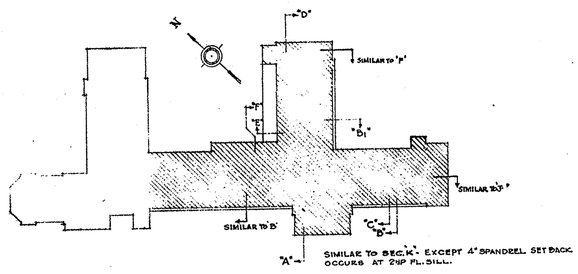

KEY PLAN SHOWING SECTION LINE LOCATIONS
THERAPY WING
SCALE: 1" = 80'-0"

GENERAL NOTES.

THE RETURNS AT WINDOW JAMBS AND RADIATOR RECESSES SHALL BE BUILT AGAINST EXTERIOR MASONRY FROM SLAB TO SLAB.

THE BACKS OF ALL EXPOSED PARAPETS SHALL BE FACE BRICK.

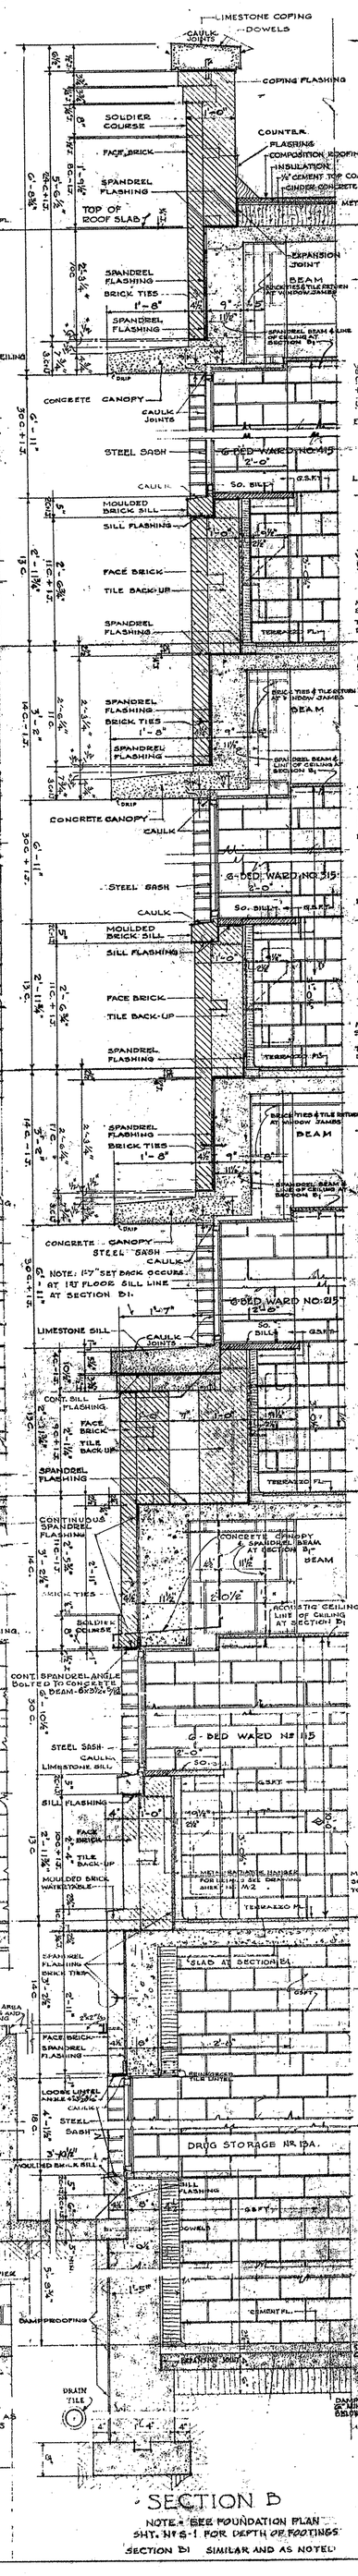

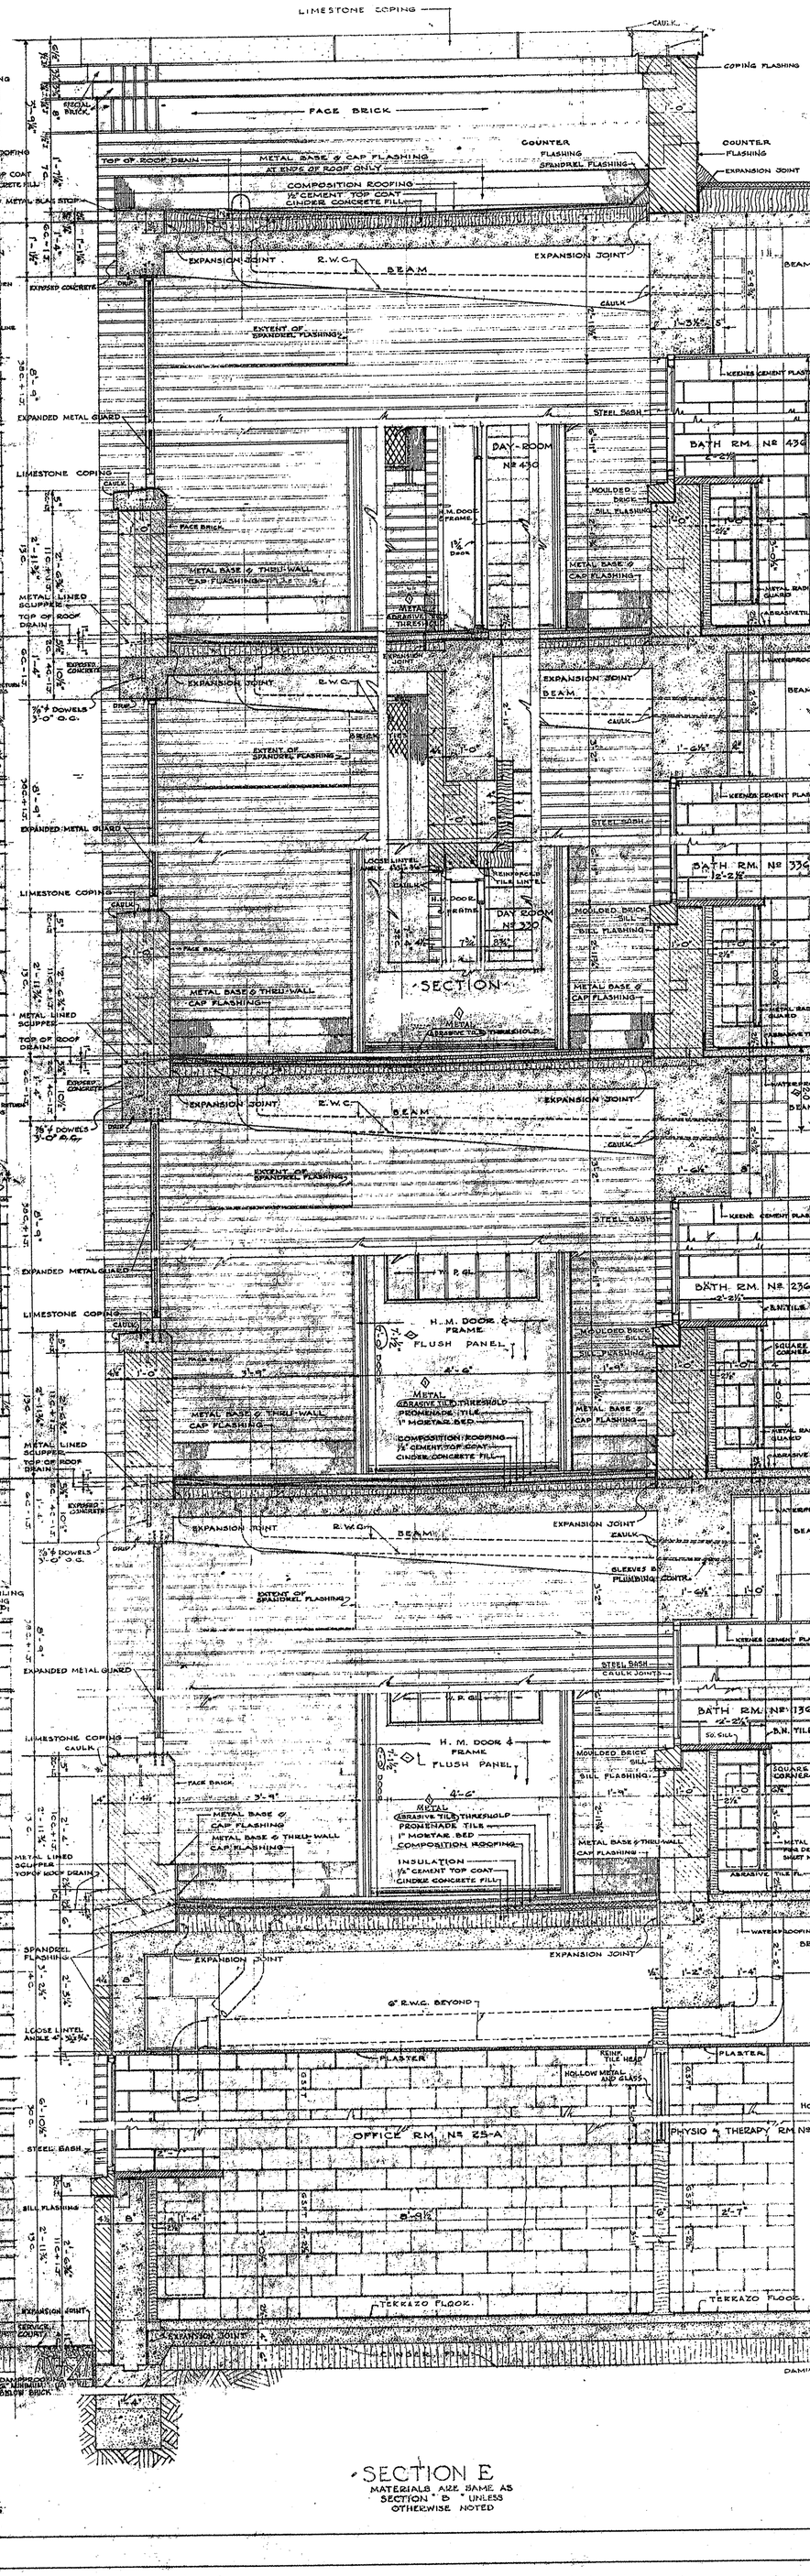

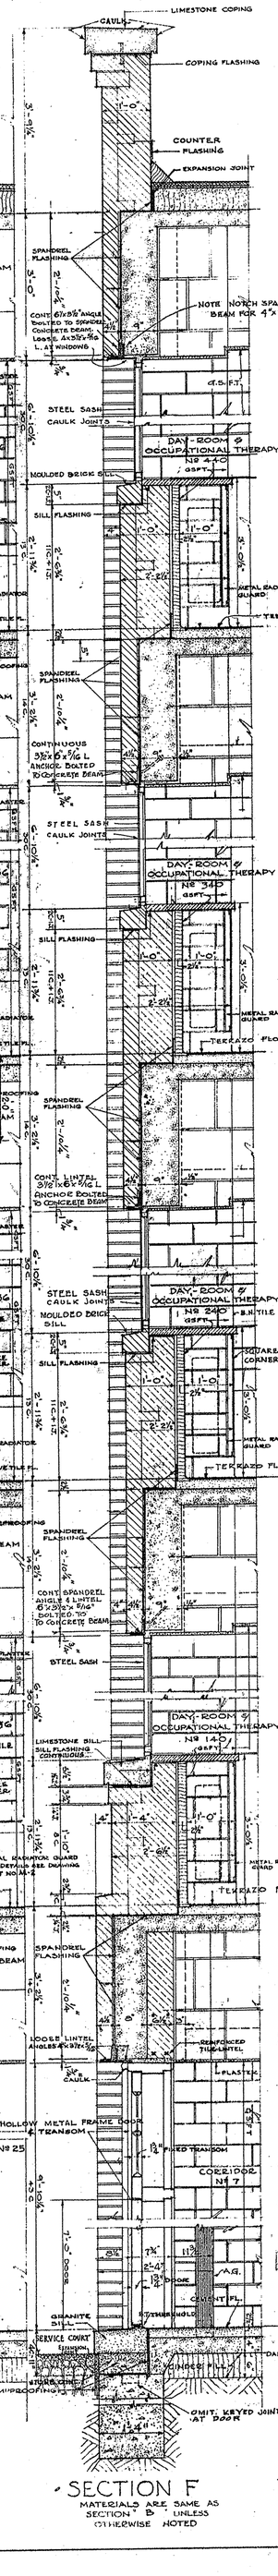

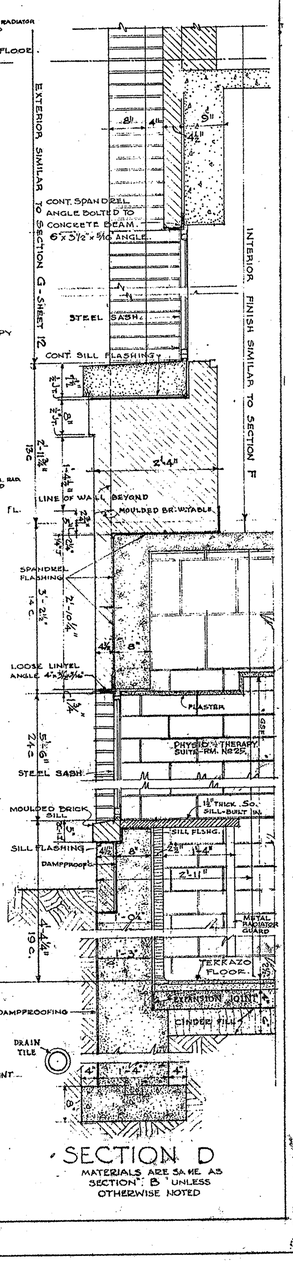

SECTION D

MATERIALS ARE SAME AS SECTION "B" UNLESS OTHERWISE NOTED

REVISED AS CONSTRUCTED 1-16-1950

APPROVED

Commonwealth of Pennsylvania
Department of Property and Supplies

Checked by
Approved by
Approval Date
Chief

APPROVED
CONT. CONSTRUCTION DIVISION
PROPERTY & SUPPLIES
ARCHITECT
CONTRACTOR

REVISED

WALL SECTIONS-THERAPY WING

ACTIVE THERAPY BUILDING No. 3
PHILADELPHIA STATE HOSPITAL
PHILADELPHIA PENNSYLVANIA

GEORGE W. PEPPER, JR. REGISTERED ARCHITECT

DATE 4-1-47
SCALE 3/4"=1'-0"

COMMONWEALTH OF PENNA.

SHEET NO.

3-6-3