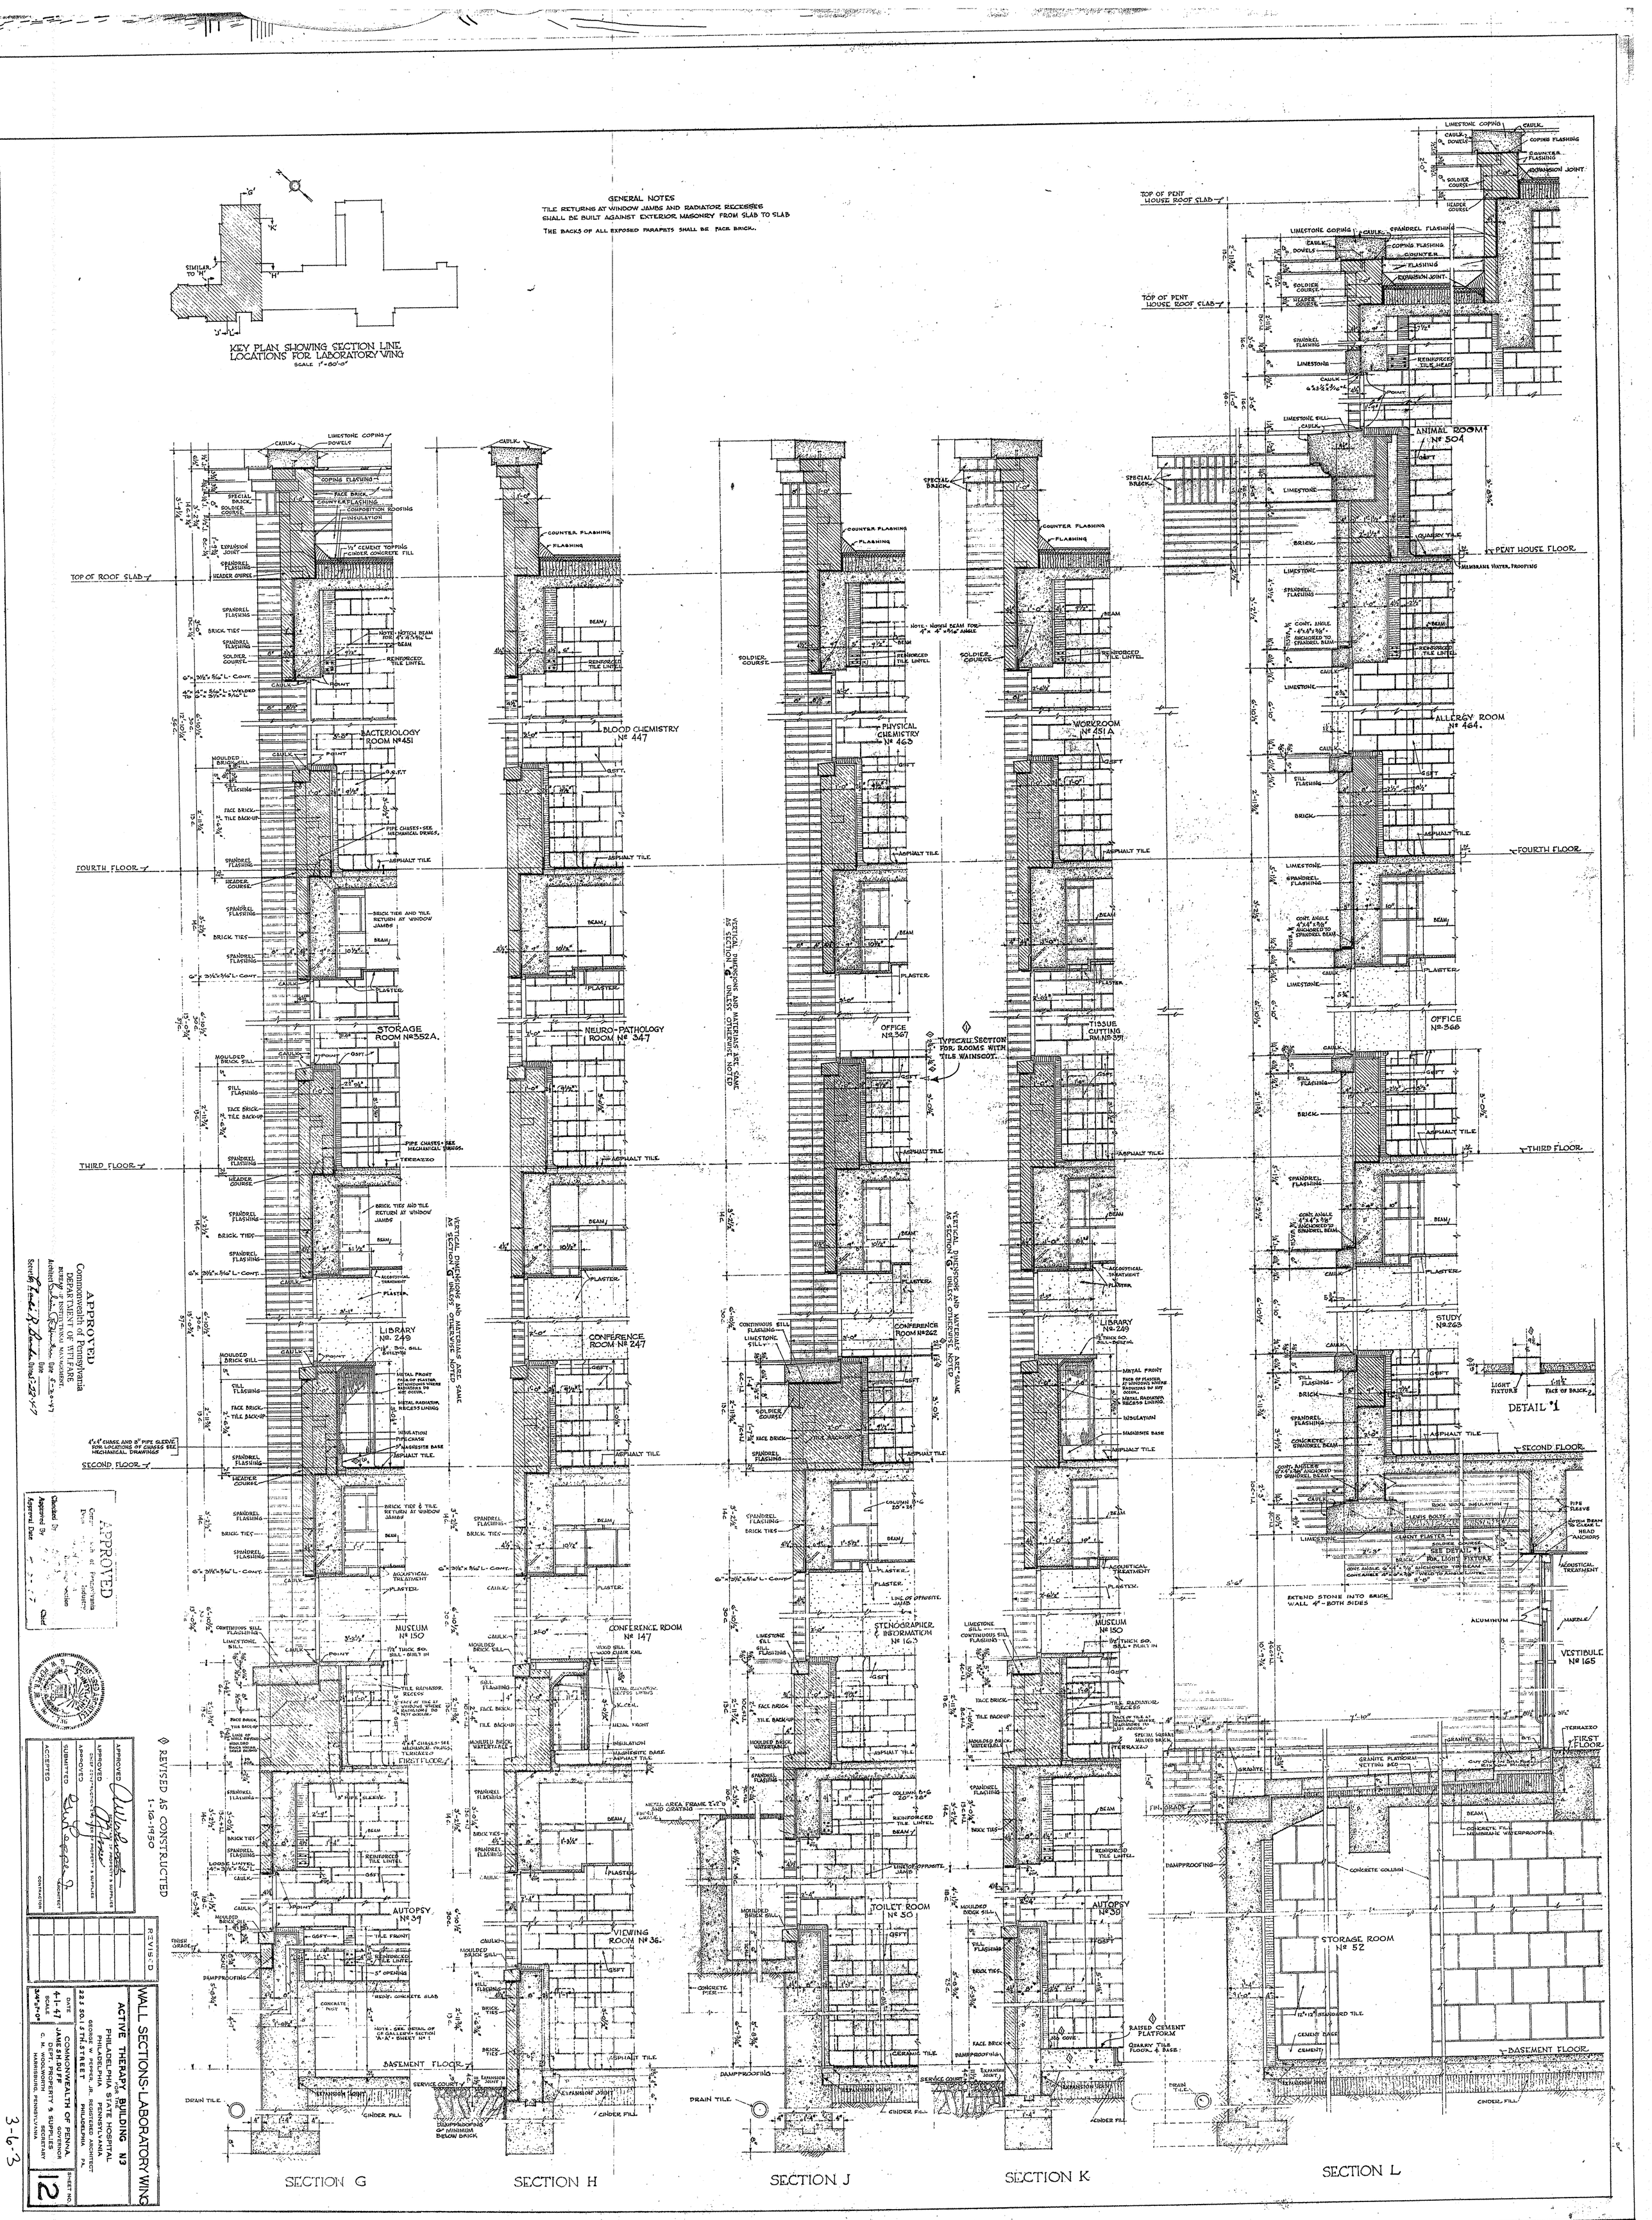
GENERAL NOTES
TILE RETURNS AT WINDOW JAMBS AND RADIATOR RECESSES SHALL BE BUILT AGAINST EXTERIOR MASONRY FROM SLAB TO SLAB
THE BACKS OF ALL EXPOSED PARAPETS SHALL BE FACE BRICK.
KEY PLAN SHOWING SECTION LINE LOCATIONS FOR LABORATORY WING
SCALE 1"=80'-0"
SECTION G
SECTION H
SECTION J
SECTION K
SECTION L
BACTERIOLOGY ROOM Nº 451
BLOOD CHEMISTRY Nº 447
PHYSICAL CHEMISTRY Nº 463
WORKROOM Nº 451A
ANIMAL ROOM Nº 504
ALLERGY ROOM Nº 464.
STORAGE ROOM Nº 352A.
NEURO-PATHOLOGY ROOM Nº 347
OFFICE Nº 367
TISSUE CUTTING RM. Nº 351
OFFICE Nº 368
LIBRARY Nº 249
CONFERENCE ROOM Nº 247
CONFERENCE ROOM Nº 262
STUDY Nº 263
MUSEUM Nº 150
CONFERENCE ROOM Nº 147
STENOGRAPHER & INFORMATION Nº 165
VESTIBULE Nº 165
AUTOPSY Nº 39
VIEWING ROOM Nº 36.
TOILET ROOM Nº 50
STORAGE ROOM Nº 52
TYPICAL SECTION FOR ROOMS WITH TILE WAINSCOT.
DETAIL #1
TOP OF ROOF SLAB
TOP OF PENT HOUSE ROOF SLAB
PENT HOUSE FLOOR
FOURTH FLOOR
THIRD FLOOR
SECOND FLOOR
FIRST FLOOR
BASEMENT FLOOR
VERTICAL DIMENSIONS AND MATERIALS ARE SAME AS SECTION "G" UNLESS OTHERWISE NOTED
REVISED AS CONSTRUCTED 1-16-1950
APPROVED Commonwealth of Pennsylvania DEPARTMENT OF WELFARE
WALL SECTIONS-LABORATORY WING
ACTIVE THERAPY FOR BUILDING N3
PHILADELPHIA STATE HOSPITAL
PHILADELPHIA PENNSYLVANIA
COMMONWEALTH OF PENNA.
JAMES H. DUFF GOVERNOR
DEPT. PROPERTY & SUPPLIES
C. M. WOOLWORTH SECRETARY
HARRISBURG, PENNSYLVANIA
4-1-47
SHEET NO. 12
3-6-3