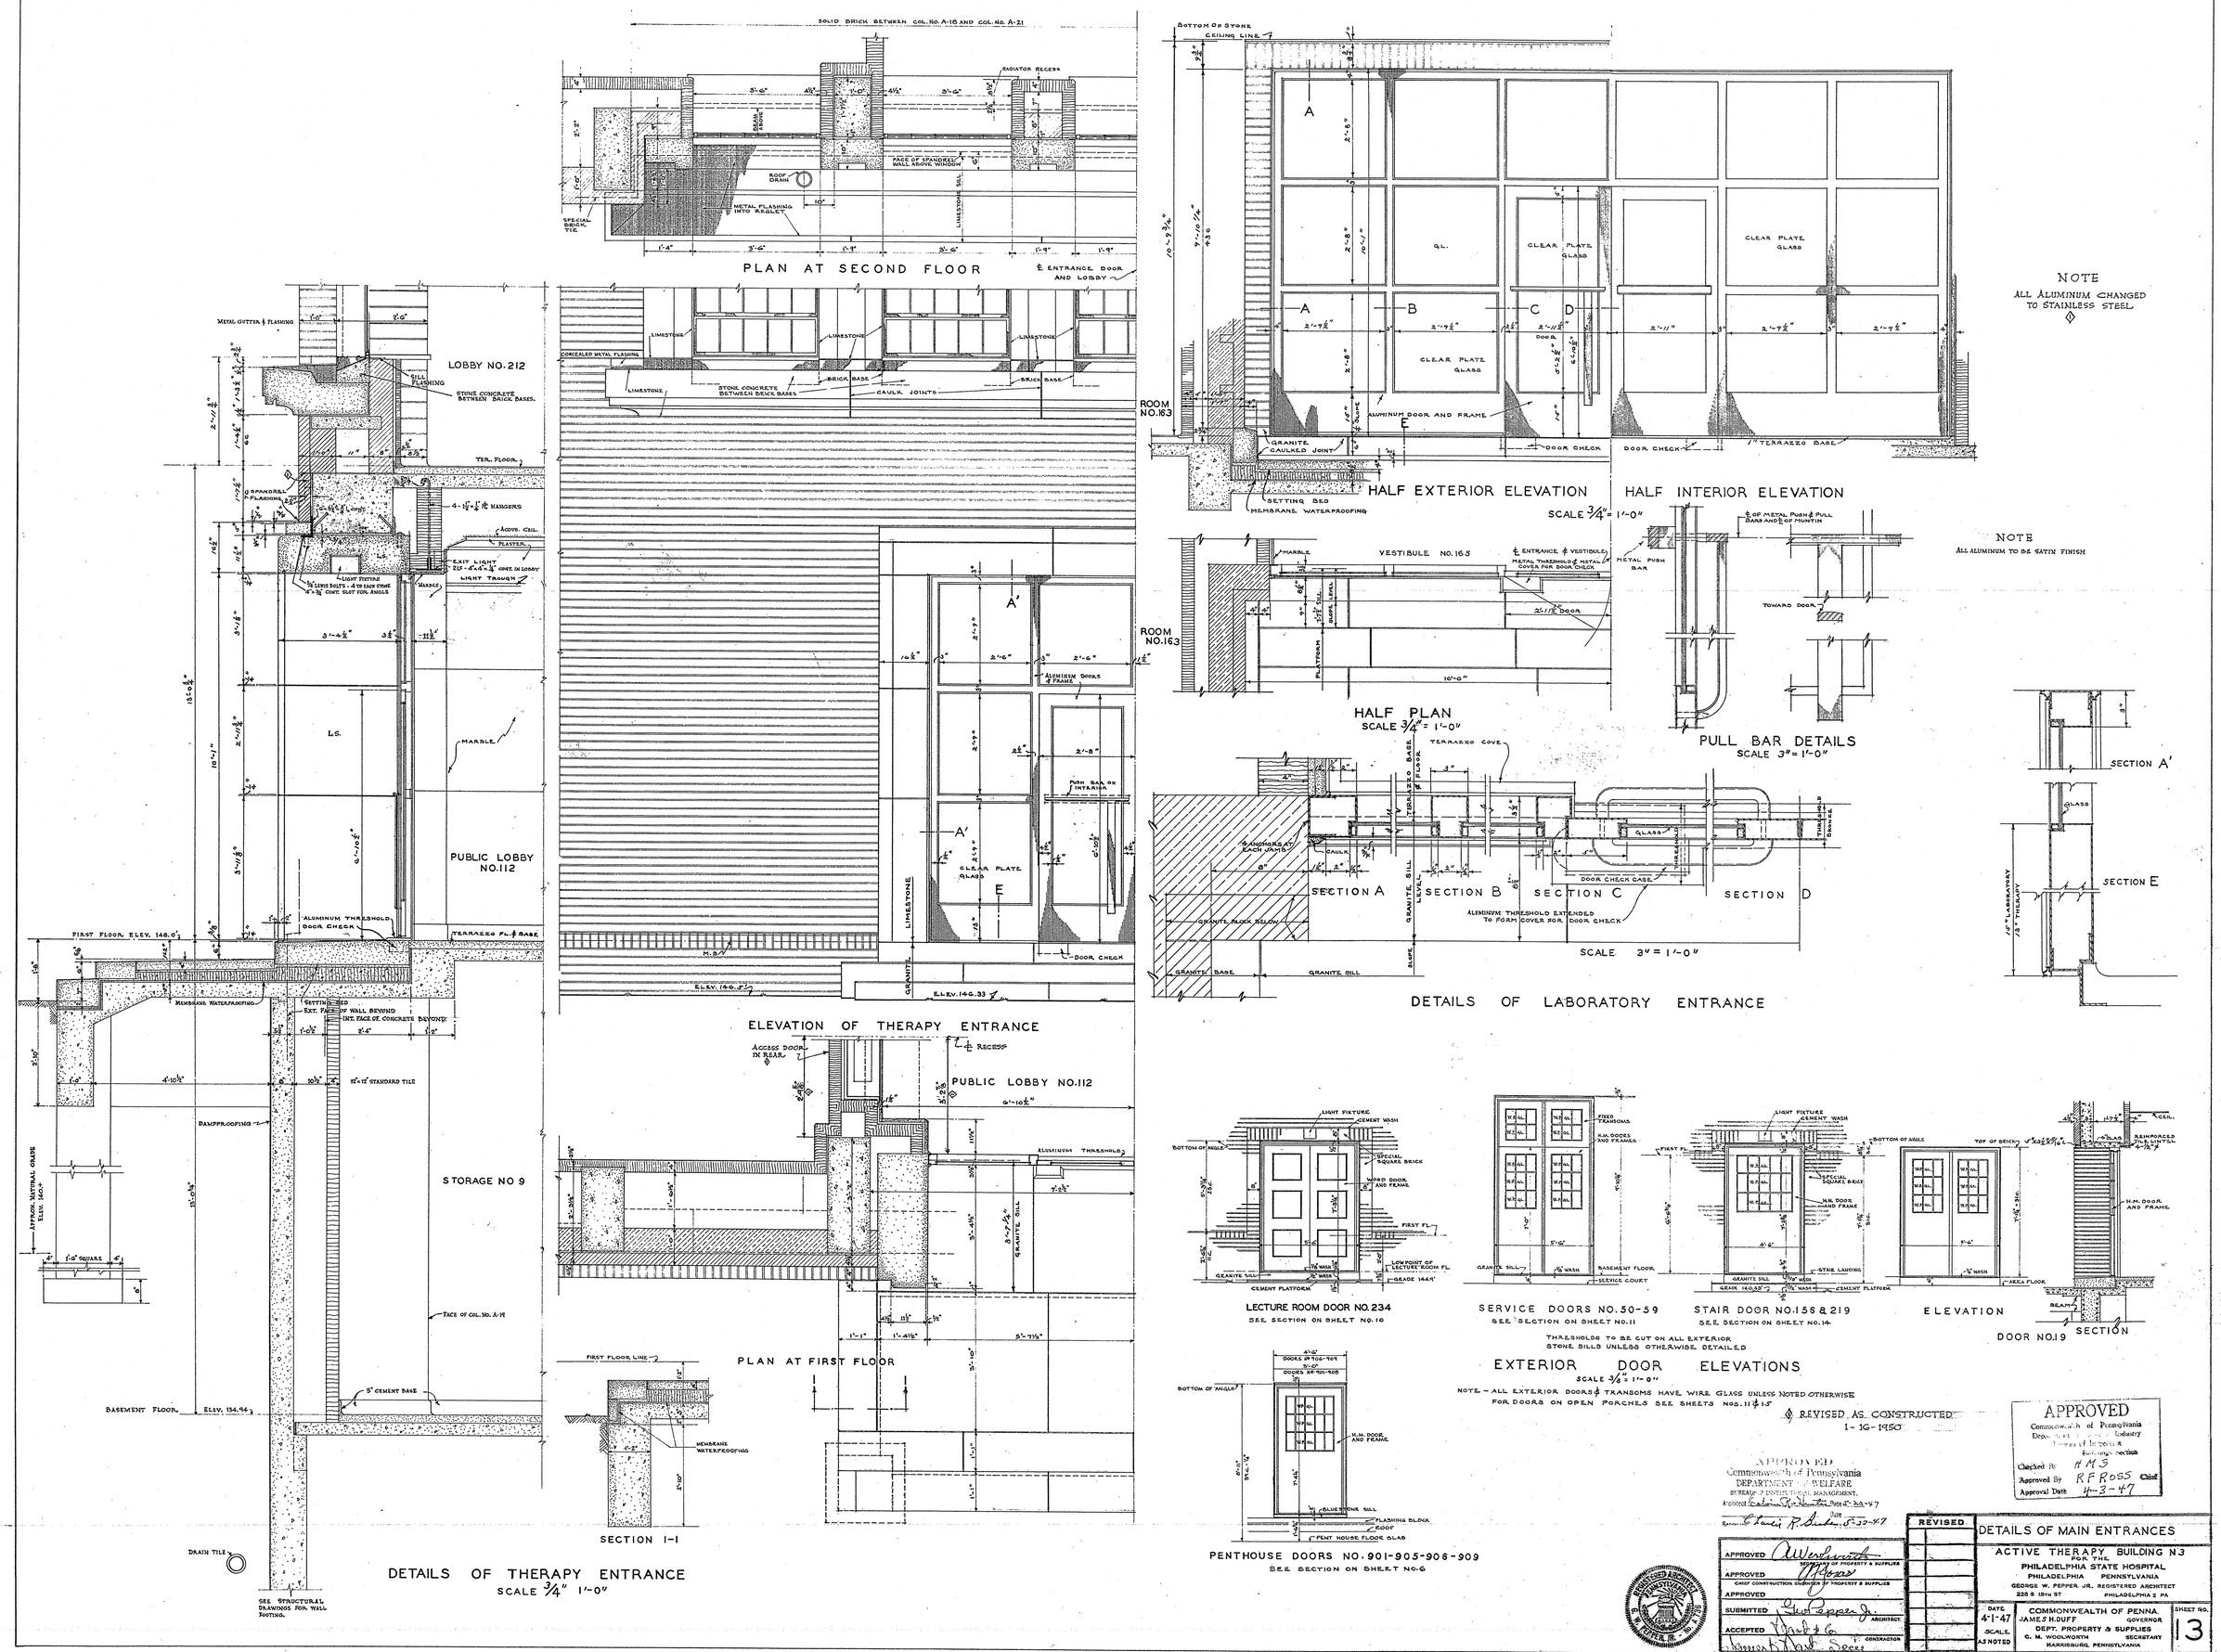
PLAN AT SECOND FLOOR
SOLID BRICK BETWEEN COL. No. A-18 AND COL. No. A-21
RADIATOR RECESS
ROOF DRAIN
METAL FLASHING INTO REGLET
SPECIAL BRICK TILE
LIMESTONE SILL
PAGE OF SPANDREL WALL ABOVE WINDOW
℄ ENTRANCE DOOR AND LOBBY
LOBBY NO. 212
METAL GUTTER & FLASHING
SILL FLASHING
STONE CONCRETE BETWEEN BRICK BASES.
TER. FLOOR
SPANDREL FLASHING
4-1/2"x1/2" ⌀ HANGERS
ACOUS. CEIL.
PLASTER
EXIT LIGHT
LIGHT TRAUGH
MARBLE
L.S.
PUBLIC LOBBY NO. 112
FIRST FLOOR ELEV. 148.0'
ALUMINUM THRESHOLD
DOOR CHECK
TERRAZZO FL. & BASE
MEMBRANE WATERPROOFING
SETTING BED
EXT. FACE OF WALL BEYOND
INT. FACE OF CONCRETE BEYOND
11"x12" STANDARD TILE
DAMPPROOFING
STORAGE NO 9
APPROX. NATURAL GRADE ELEV. 140.0
FACE OF COL. No. A-19
5" CEMENT BASE
BASEMENT FLOOR ELEV. 134.46
DRAIN TILE
SEE STRUCTURAL DRAWINGS FOR WALL FOOTING.
DETAILS OF THERAPY ENTRANCE
SCALE 3/4" 1'-0"
CONCEALED METAL FLASHING
LIMESTONE
STONE CONCRETE BETWEEN BRICK BASES
BRICK BASE
CAULK JOINTS
ROOM NO. 163
A'
ALUMINUM DOORS & FRAME
PUSH BAR ON INTARSIA
CLEAR PLATE GLASS
E
DOOR CHECK
ELEV. 146.33
ELEVATION OF THERAPY ENTRANCE
ACCESS DOOR IN REAR
℄ RECESS
PUBLIC LOBBY NO. 112
ALUMINUM THRESHOLD
GRANITE SILL
PLAN AT FIRST FLOOR
FIRST FLOOR LINE
MEMBRANE WATERPROOFING
SECTION 1-1
BOTTOM OF STONE CEILING LINE
A
B
C
D
GL.
CLEAR PLATE GLASS
DOOR
ALUMINUM DOOR AND FRAME
GRANITE
CAULKED JOINT
DOOR CHECK
TERRAZZO BASE
SETTING BED
MEMBRANE WATERPROOFING
HALF EXTERIOR ELEVATION
SCALE 3/4" = 1'-0"
HALF INTERIOR ELEVATION
℄ OF METAL PUSH & PULL BARS AND ℄ OF MUNTIN
METAL PUSH BAR
TOWARD DOOR
PULL BAR DETAILS
SCALE 3" = 1'-0"
NOTE
ALL ALUMINUM CHANGED TO STAINLESS STEEL
NOTE
ALL ALUMINUM TO BE SATIN FINISH
MARBLE
VESTIBULE NO. 16-5
℄ ENTRANCE & VESTIBULE
METAL THRESHOLD & METAL COVER FOR DOOR CHECK
25'-1/2" DOOR
PLATFORM
10'-0"
HALF PLAN
SCALE 3/4" = 1'-0"
TERRAZZO COVE
TERRAZZO BASE & FLOOR
8 ANCHORS AT EACH JAMB
CAULK
GRANITE SILL LEVEL
GRANITE BLOCK BELOW
GRANITE BASE
GRANITE SILL
SLOPE
GLASS
THRESHOLD
DOOR CHECK CASE
ALUMINUM THRESHOLD EXTENDED TO FORM COVER FOR DOOR CHECK
SECTION A
SECTION B
SECTION C
SECTION D
SCALE 3" = 1'-0"
DETAILS OF LABORATORY ENTRANCE
SECTION A'
SECTION E
LIGHT FIXTURE
CEMENT WASH
BOTTOM OF ANGLE
SPECIAL SQUARE BRICK
WOOD DOOR AND FRAME
FIRST FL.
LOW POINT OF LECTURE ROOM FL.
GRADE 144.4
GRANITE SILL
CEMENT PLATFORM
LECTURE ROOM DOOR NO. 234
SEE SECTION ON SHEET No. 10
FIXED TRANSOMS
H.M. DOORS AND FRAMES
BASEMENT FLOOR
SERVICE COURT
SERVICE DOORS NO. 50-59
SEE SECTION ON SHEET No. 11
H.M. DOOR AND FRAME
STAIR LANDING
GRADE 140.83
STAIR DOOR NO. 156 & 219
SEE SECTION ON SHEET No. 14
TOP OF BRICK
REINFORCED CONCRETE LINTEL
AREA FLOOR
BEAM
ELEVATION
SECTION
DOOR NO. 19
THRESHOLDS TO BE CUT ON ALL EXTERIOR STONE SILLS UNLESS OTHERWISE DETAILED
EXTERIOR DOOR ELEVATIONS
SCALE 3/8" = 1'-0"
NOTE - ALL EXTERIOR DOORS & TRANSOMS HAVE WIRE GLASS UNLESS NOTED OTHERWISE
FOR DOORS ON OPEN PORCHES SEE SHEETS Nos. 11 & 13
DOORS AT 906-909
DOORS AT 901-905
BLUESTONE SILL
FLASHING BLOCK
ROOF
PENT HOUSE FLOOR SLAB
PENTHOUSE DOORS NO. 901-905-906-909
SEE SECTION ON SHEET No. 6
REVISED AS CONSTRUCTED
1-16-1950
APPROVED
Commonwealth of Pennsylvania
Department of Industry
Bureau of Inspection
Building Section
Checked By HMS
Approved By R F ROSS Chief
Approval Date 4-3-47
APPROVED
Commonwealth of Pennsylvania
DEPARTMENT OF WELFARE
BUREAU OF INSTITUTIONAL MANAGEMENT
Architect
Date
APPROVED
SUBMITTED
ACCEPTED
ARCHITECT
CONTRACTOR
REVISED
DETAILS OF MAIN ENTRANCES
ACTIVE THERAPY BUILDING N3
FOR THE
PHILADELPHIA STATE HOSPITAL
PHILADELPHIA PENNSYLVANIA
GEORGE W. PEPPER JR. REGISTERED ARCHITECT
225 S 15TH ST PHILADELPHIA 2 PA
DATE 4-1-47
SCALE AS NOTED
COMMONWEALTH OF PENNA.
JAMES H. DUFF GOVERNOR
DEPT. PROPERTY & SUPPLIES
C. M. WOOLWORTH SECRETARY
HARRISBURG, PENNSYLVANIA
SHEET No. 13
3-6-3