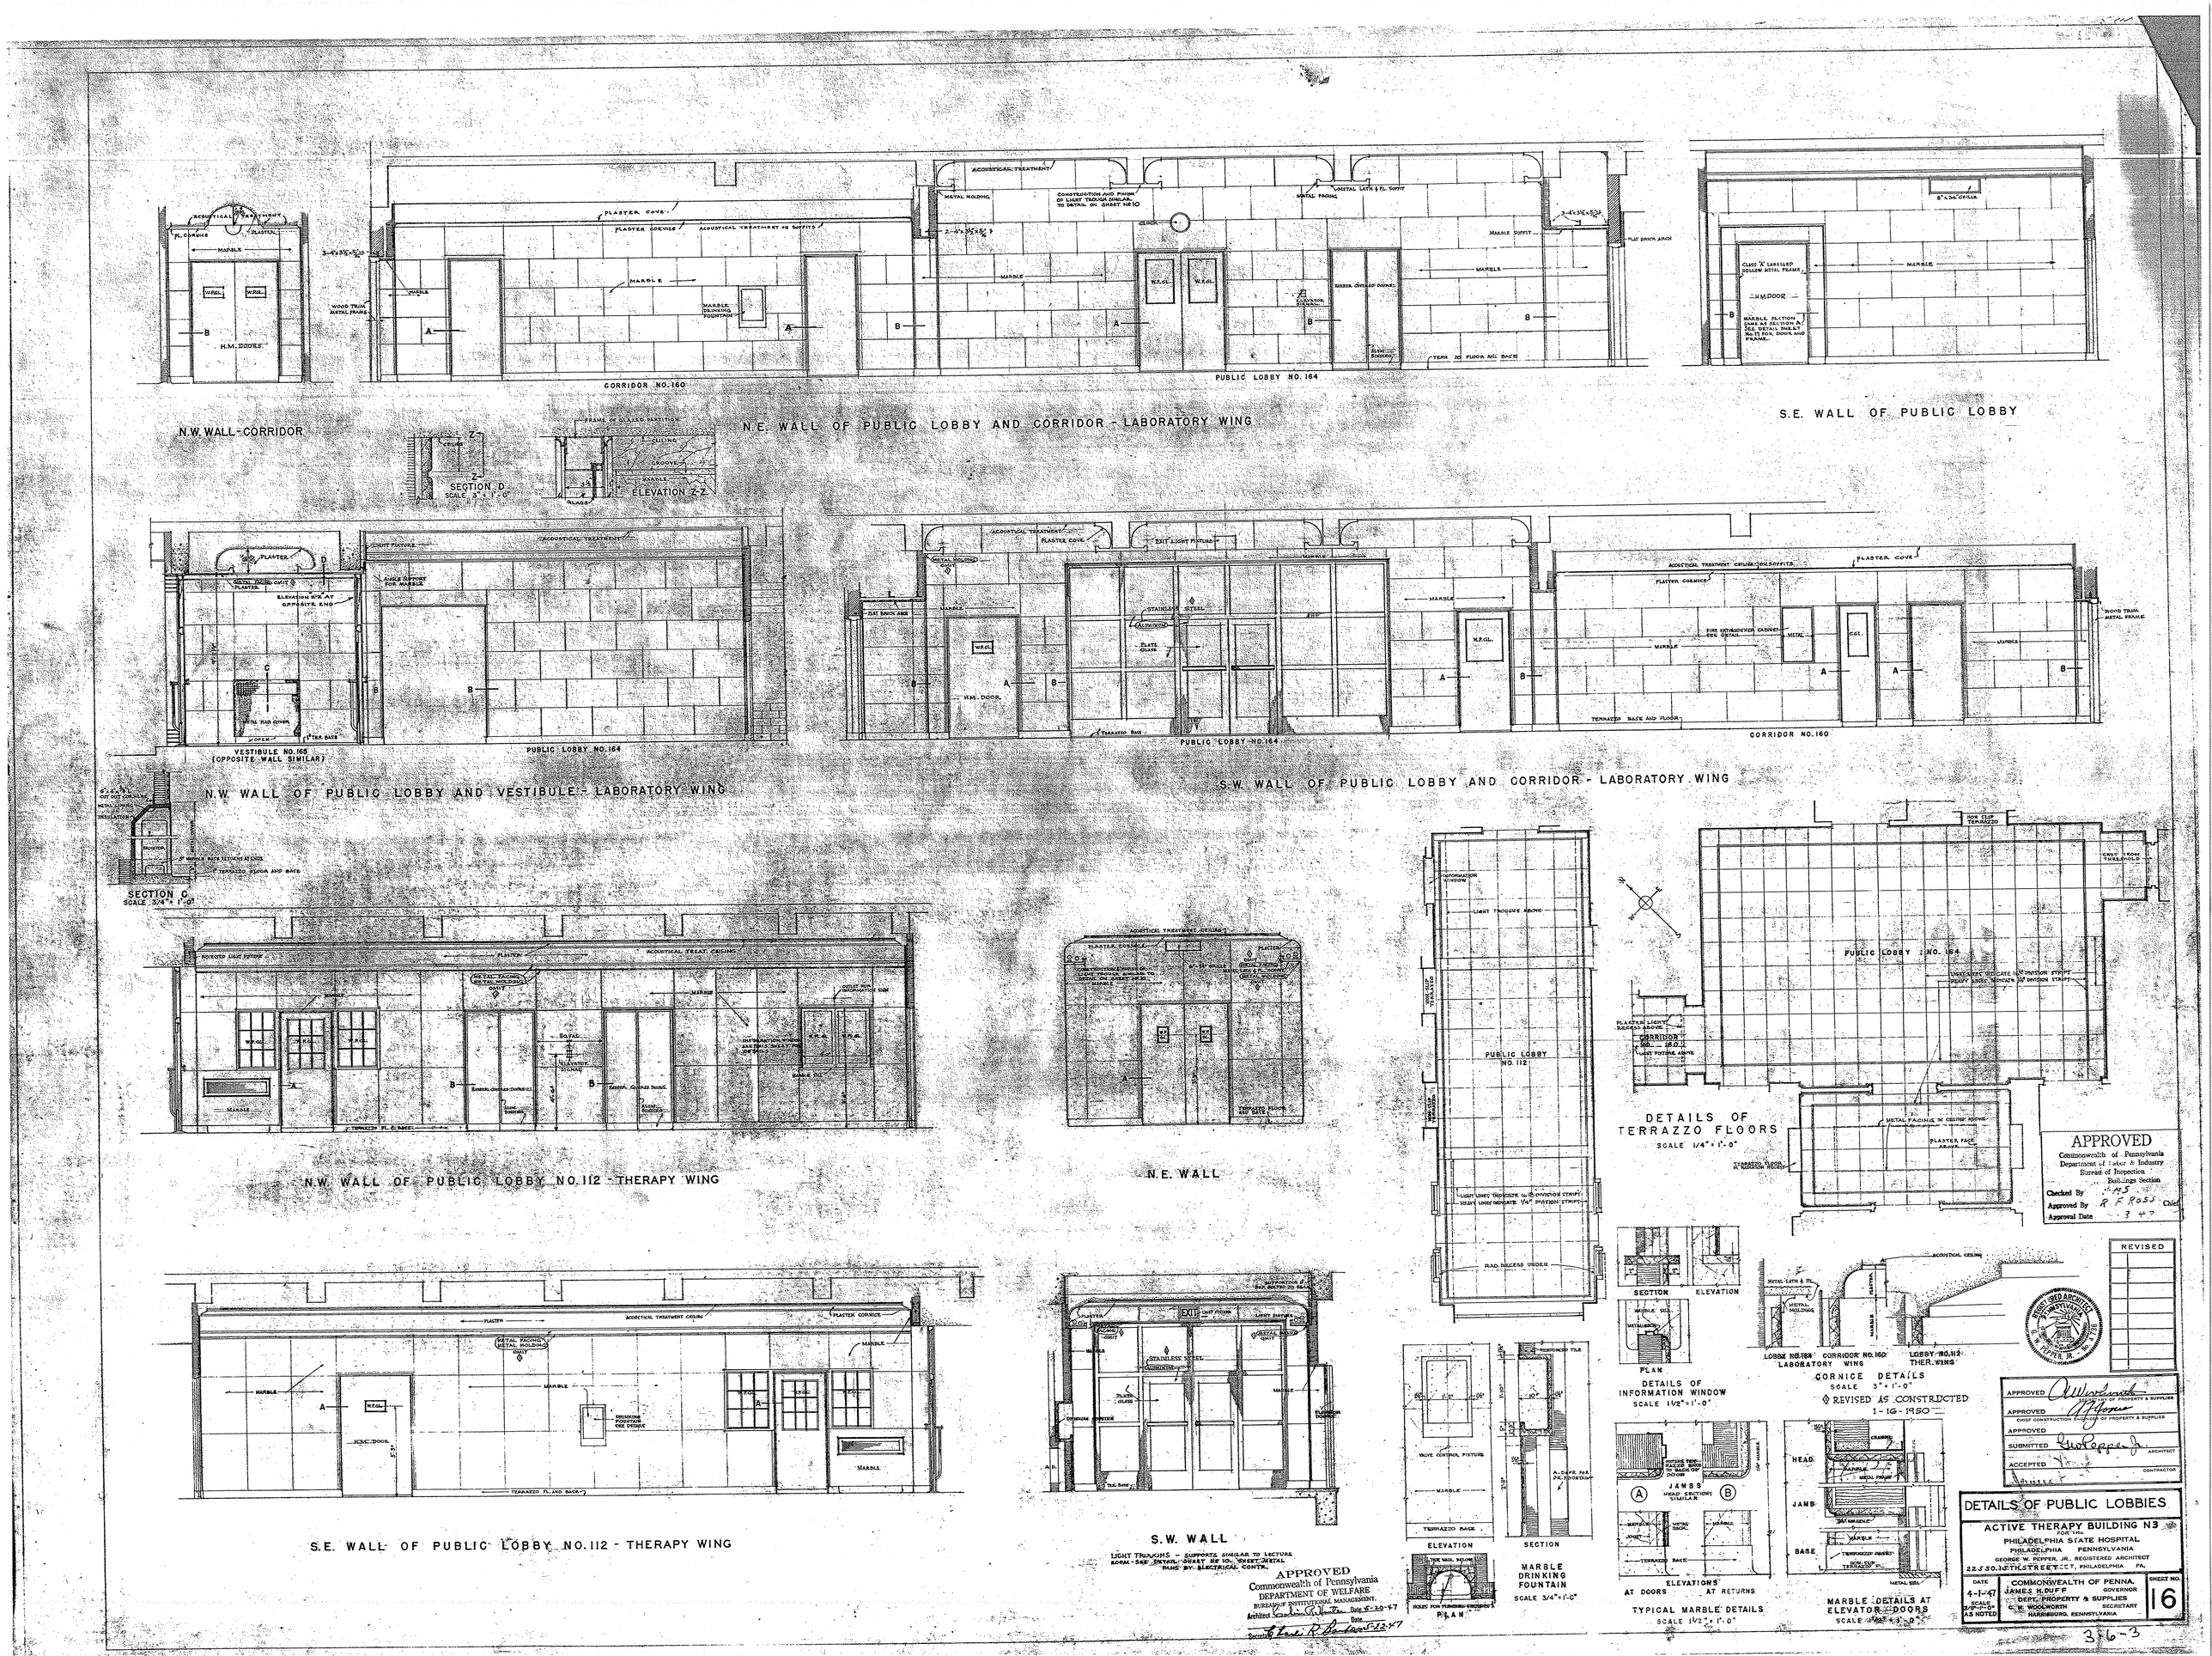
N.W. WALL - CORRIDOR
CORRIDOR NO. 160
PUBLIC LOBBY NO. 164
N.E. WALL OF PUBLIC LOBBY AND CORRIDOR - LABORATORY WING
S.E. WALL OF PUBLIC LOBBY
SECTION D
SCALE 3" = 1'-0"
ELEVATION Z-Z
VESTIBULE NO. 165
(OPPOSITE WALL SIMILAR)
PUBLIC LOBBY NO. 164
N.W. WALL OF PUBLIC LOBBY AND VESTIBULE - LABORATORY WING
CORRIDOR NO. 160
S.W. WALL OF PUBLIC LOBBY AND CORRIDOR - LABORATORY WING
SECTION C
SCALE 3/4" = 1'-0"
N.W. WALL OF PUBLIC LOBBY NO. 112 - THERAPY WING
N.E. WALL
S.E. WALL OF PUBLIC LOBBY NO. 112 - THERAPY WING
S.W. WALL
LIGHT TROUGHS - SUPPORTS SIMILAR TO LECTURE ROOM - SEE DETAIL SHEET NO. 10, SHEET METAL
FANS - BY ELECTRICAL CONTR.
PUBLIC LOBBY NO. 112
DETAILS OF TERRAZZO FLOORS
SCALE 1/4" = 1'-0"
PUBLIC LOBBY NO. 164
CORRIDOR NO. 160
ELEVATION
SECTION
PLAN
DETAILS OF INFORMATION WINDOW
SCALE 1 1/2" = 1'-0"
LOBBY NO. 164 LABORATORY WING
CORRIDOR NO. 160
LOBBY NO. 112 THER. WING
CORNICE DETAILS
SCALE 3" = 1'-0"
REVISED AS CONSTRUCTED
1-16-1950
ELEVATION
SECTION
MARBLE DRINKING FOUNTAIN
SCALE 3/4" = 1'-0"
PLAN
JAMBS
HEAD SECTIONS SIMILAR
ELEVATIONS
AT DOORS
AT RETURNS
TYPICAL MARBLE DETAILS
SCALE 1 1/2" = 1'-0"
HEAD
JAMB
BASE
MARBLE DETAILS AT ELEVATOR DOORS
SCALE 1 1/2" = 1'-0"
APPROVED
Commonwealth of Pennsylvania
Department of Labor & Industry
Bureau of Inspection
Buildings Section
Checked By
Approved By R. F. Ross Chief
Approval Date 3-47
REVISED
APPROVED
CHIEF OF PROPERTY & SUPPLIES
APPROVED
CHIEF CONSTRUCTION ENGINEER OF PROPERTY & SUPPLIES
APPROVED
SUBMITTED
ARCHITECT
ACCEPTED
CONTRACTOR
DETAILS OF PUBLIC LOBBIES
ACTIVE THERAPY BUILDING N3
FOR THE
PHILADELPHIA STATE HOSPITAL
PHILADELPHIA PENNSYLVANIA
GEORGE W. PEPPER, JR. REGISTERED ARCHITECT
22 S. 30TH STREET, PHILADELPHIA PA.
DATE 4-1-47
SCALE 3/4"=1'-0" & AS NOTED
COMMONWEALTH OF PENNA.
JAMES H. DUFF GOVERNOR
C. M. WOOLWORTH SECRETARY
DEPT. PROPERTY & SUPPLIES
HARRISBURG, PENNSYLVANIA
SHEET NO. 16
3-6-3