#8283
STATE ART COMMISSION
APR 3 1947
RECEIVED
STATE ART COMMISSION
4-3-47

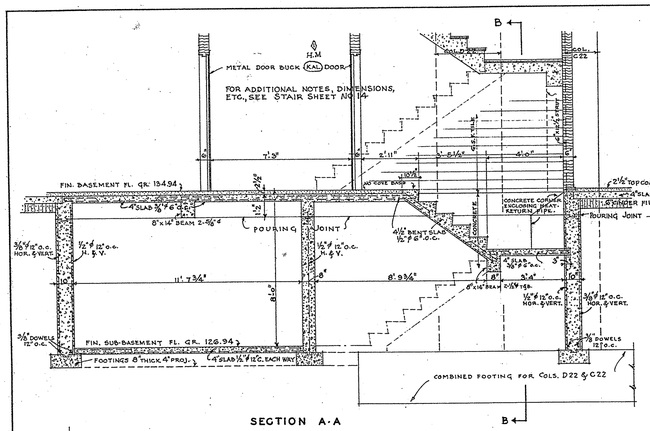

SECTION A-A

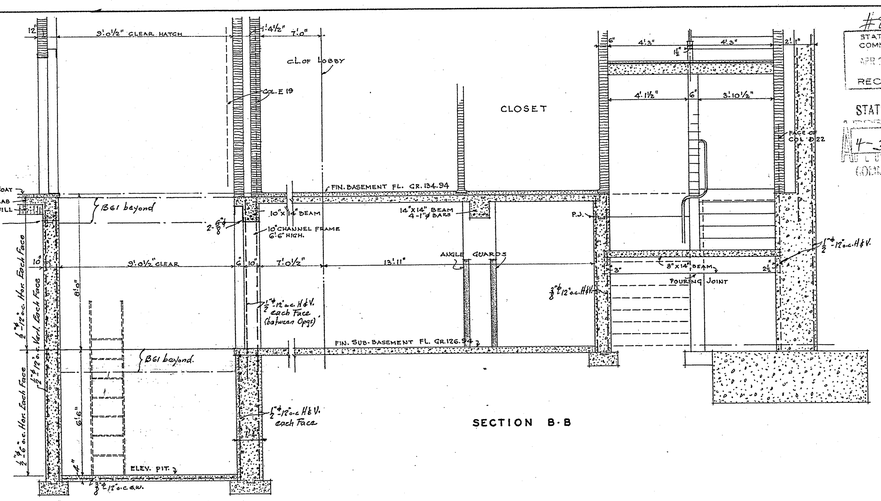

SECTION B-B

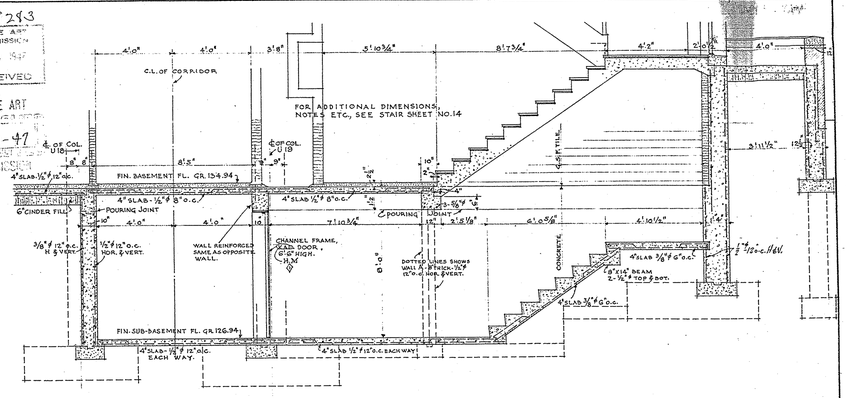

SECTION C-C

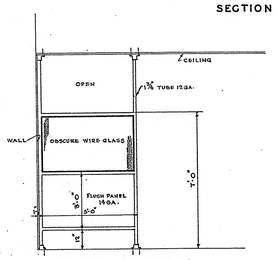

DETAIL OF METAL CUBICLES VISITORS ROOMS SCALE-3/8"=1'-0"

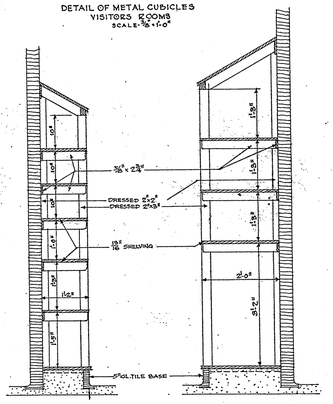

SECTION THRU 14" WALL SHELVING
FREE STANDING SHELVING SHALL HAVE SAME SHELF SPACING. SEE SH. NO. 15 FOR PLAN & ELEVATION

SECTION THRU 2'-0" WALL SHELVING

DETAILS OF DRUG STORAGE SHELVING
3/4"=1'-0"

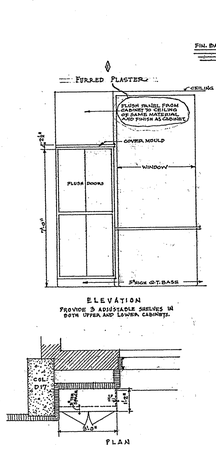

DETAIL OF BUILT-IN CABINET IN SERVING KITCHEN NO. 107
3/8"-1'-0"
FOR CONSTRUCTION DETAILS SEE "DETAILS OF HANGING CABINETS"-SH. NO. 15

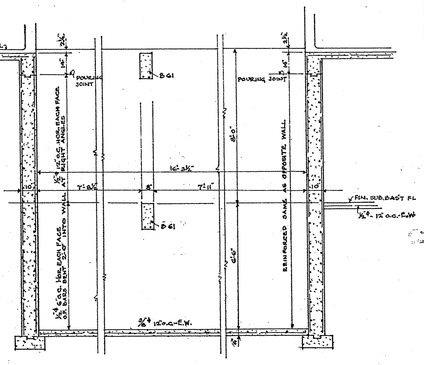

SECTION D-D

DETAILS OF STAIRWAY NO. 1
SCALE 3/8 IN. = 1'-0"
NOTE - SEE SHEET NO. 14 FOR ADDITIONAL NOTES, DIMENSIONS & DETAILS.

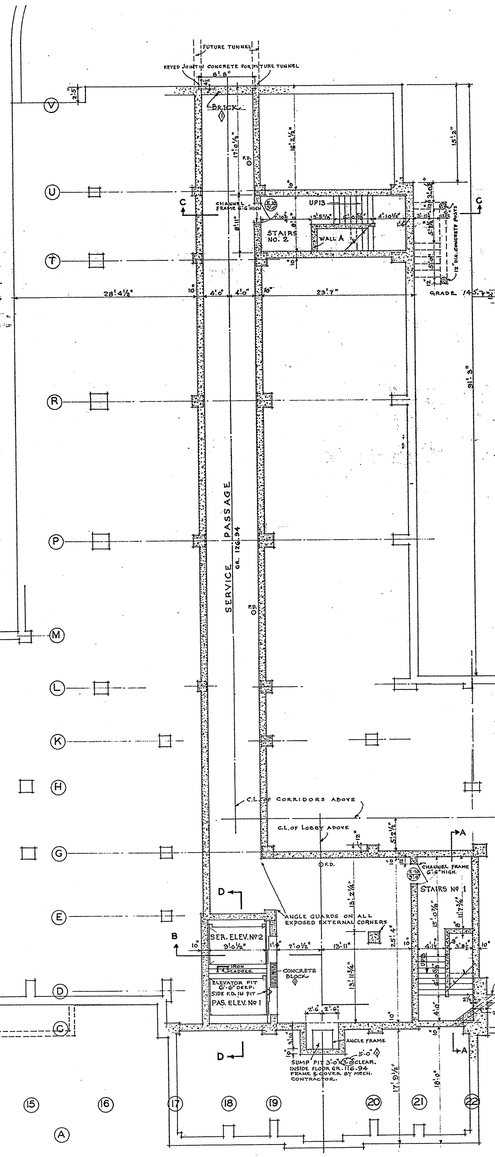

THERAPY WING
SEE SHEET NO. 1 & STRUCTURAL DRAWINGS FOR ADDITIONAL DETAILS, DIMENSIONS & NOTES.

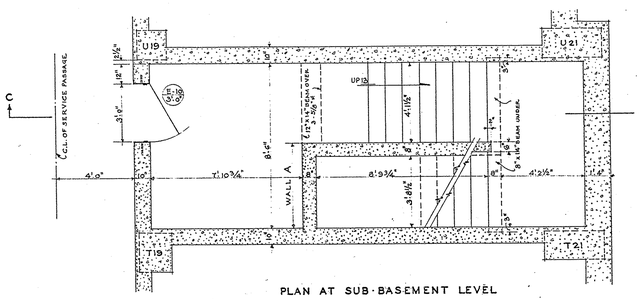

PLAN AT SUB-BASEMENT LEVEL

DETAILS OF STAIRWAY NO. 2
SCALE 3/8 IN. = 1'-0"
NOTE - SEE SHEET NO. 14 FOR ADDITIONAL NOTES, DIMENSIONS & DETAILS.

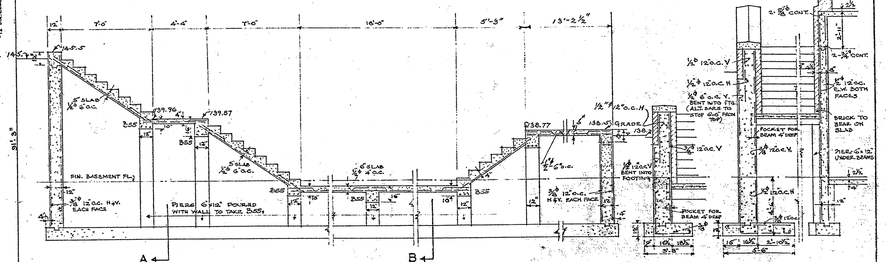

SECTION B SECTION A

DETAILS OF EXTERIOR STAIRS AT SOUTHEAST END OF THE BUILDING
1/4"=1'-0"

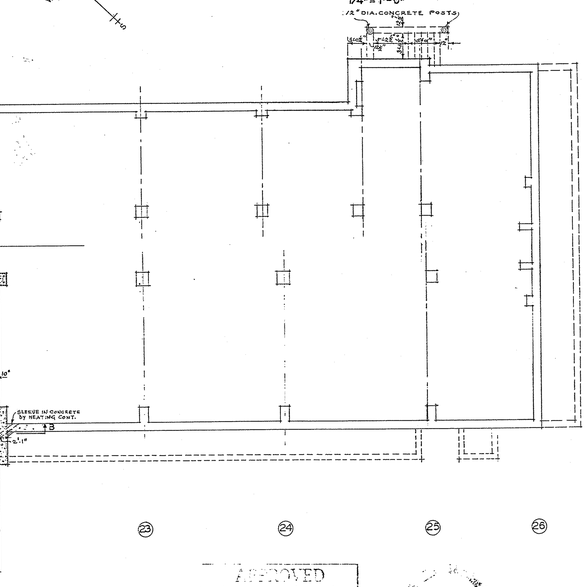

REVISED AS CONSTRUCTED
1-16-50

REVISED

APPROVED [illegible]
APPROVED [illegible]
APPROVED
SUBMITTED [illegible]
ACCEPTED [illegible]

SUB BASEMENT PLAN AND MISCELLANEOUS DETAILS
ACTIVE THERAPY BUILDING

GE 225 30.15
DATE 4-1-47
SCALE 1/8"=1'-0"

APPROVED [illegible] 5-20-47
[illegible] 5-22-47

APPROVED
Chief [illegible] Section
Approved [illegible] Chief
Approved Date [illegible]

4-3-47

3-6-3