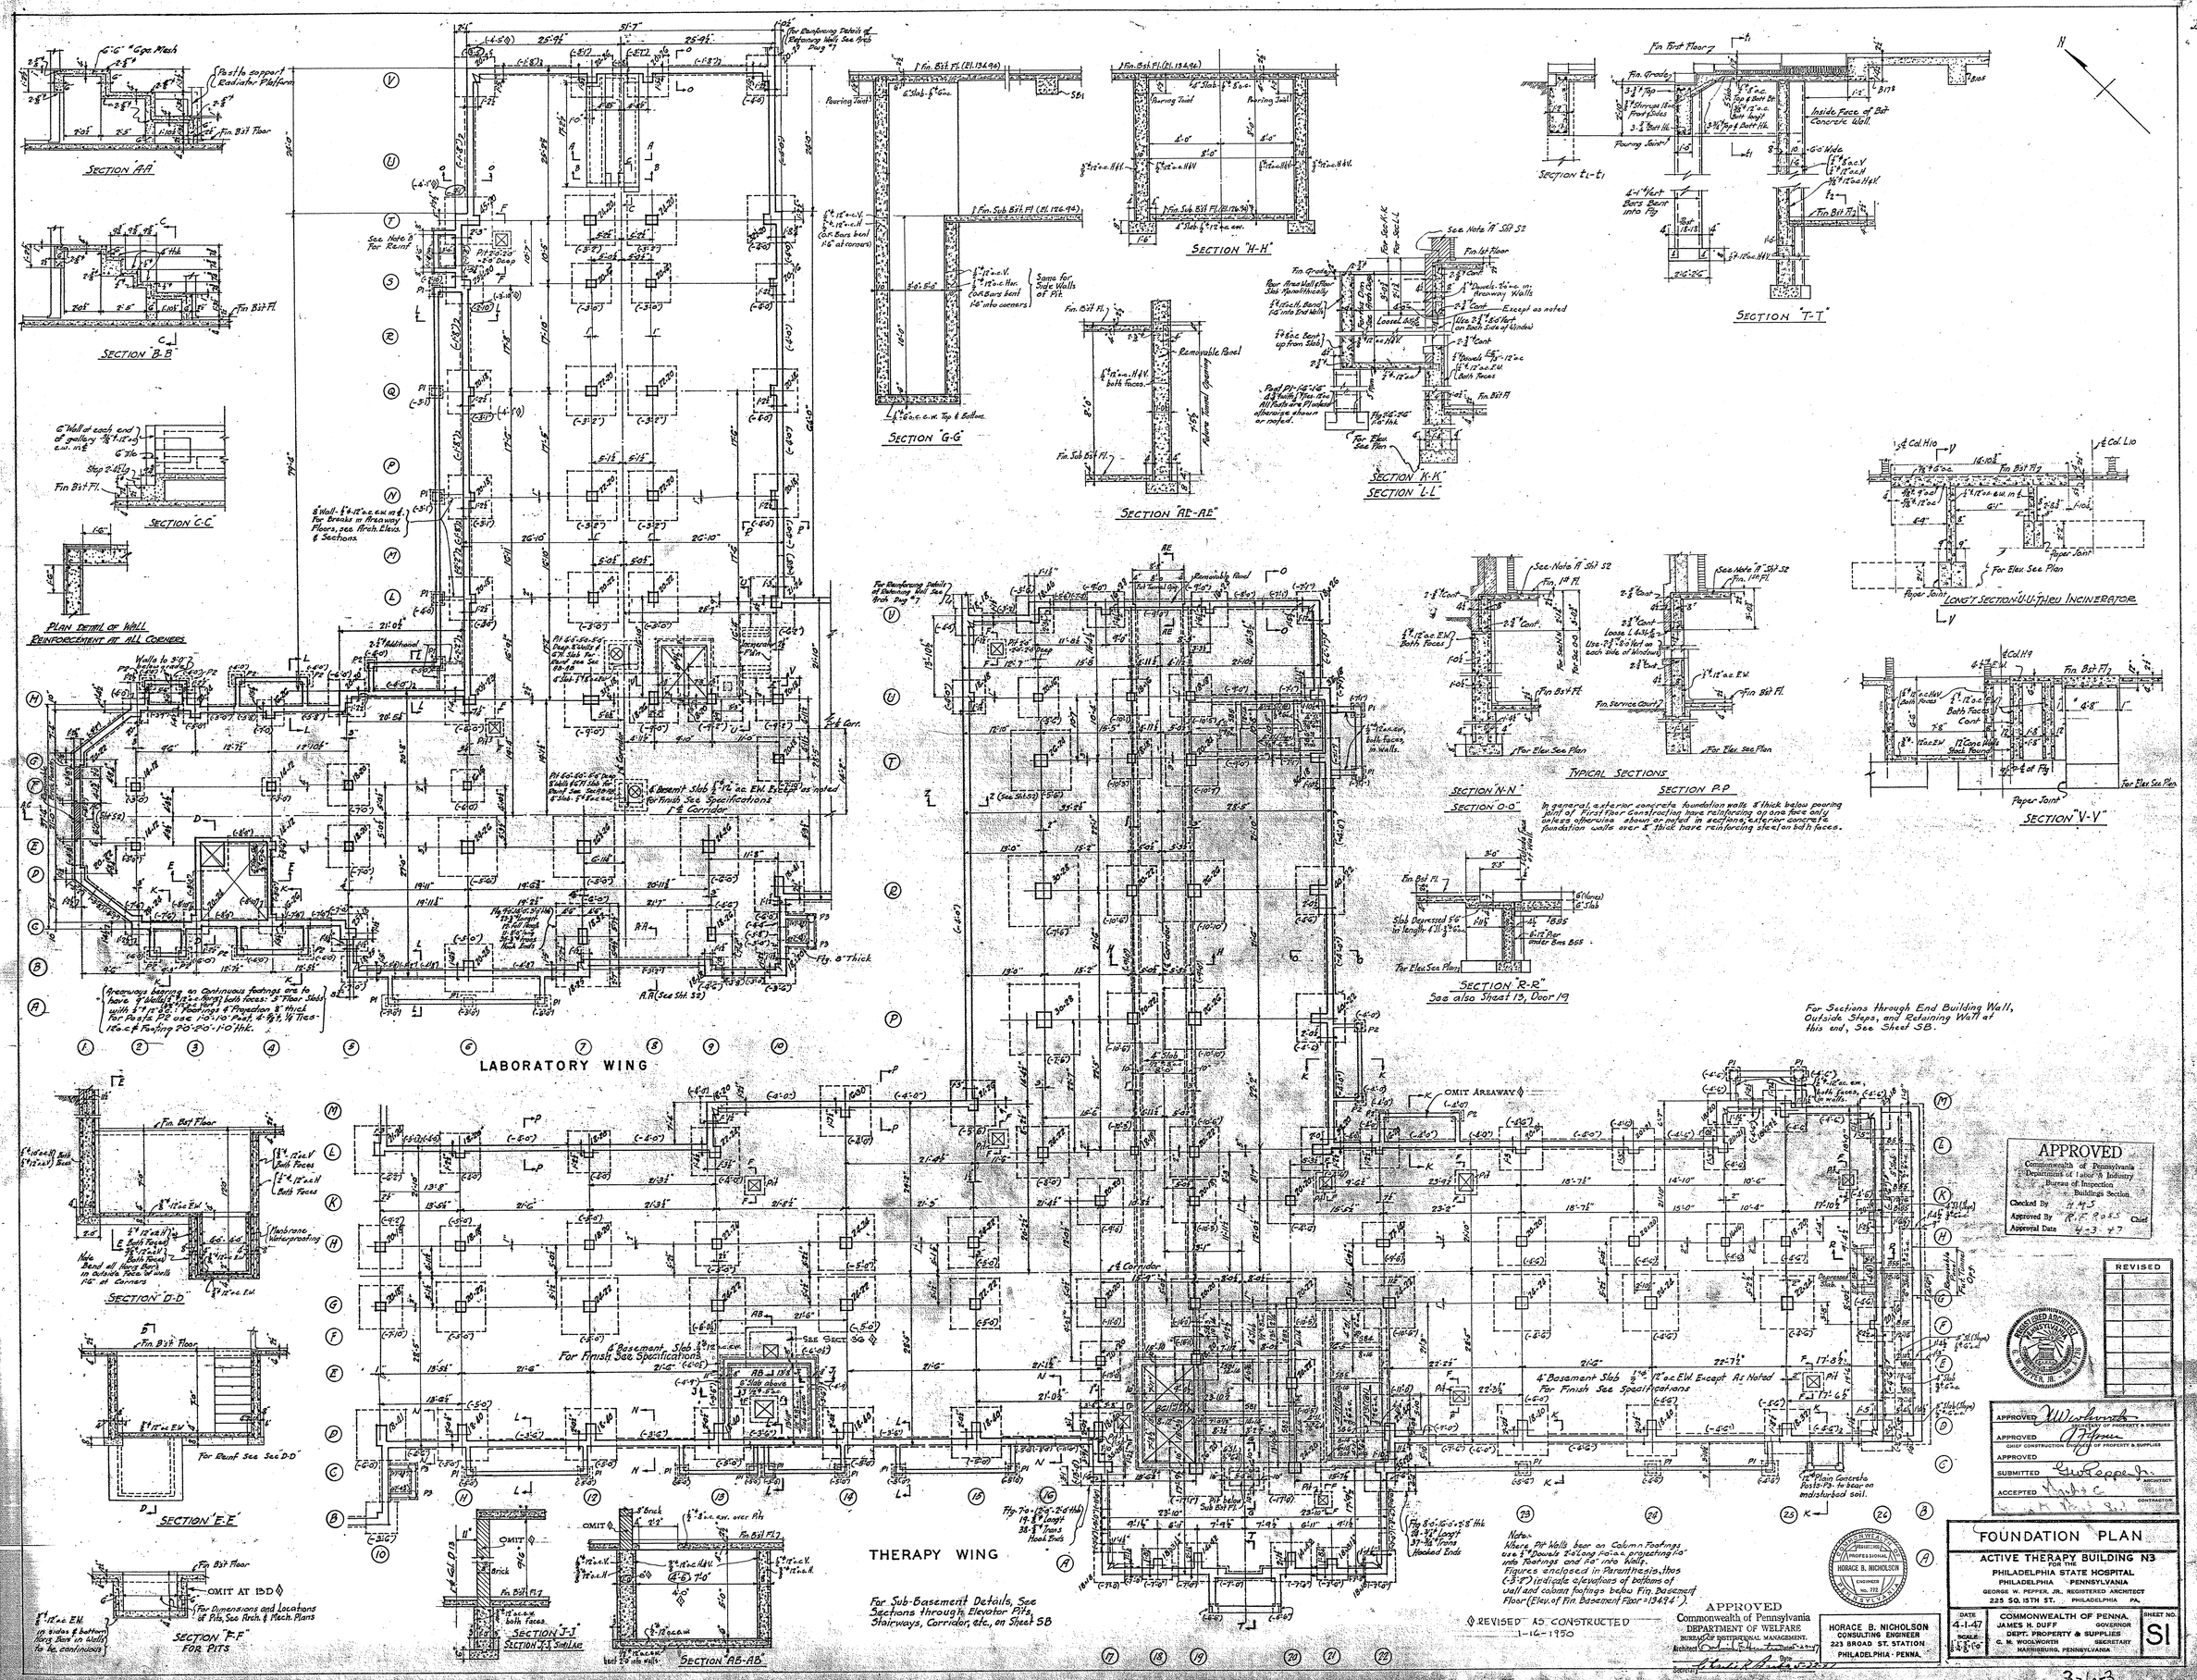
SECTION "A-A"
SECTION "B-B"
SECTION C-C
PLAN DETAIL OF WALL REINFORCEMENT AT ALL CORNERS
SECTION "G-G"
SECTION "H-H"
SECTION "AE-AE"
SECTION "K-K"
SECTION L-L
SECTION "T-T"
SECTION t1-t1
SECTION "N-N"
SECTION O-O
SECTION P-P
TYPICAL SECTIONS
SECTION "R-R"
See also Sheet 13, Door 19
SECTION "V-V"
LONGT SECTION U-U-T-T-EU INCINERATOR
LABORATORY WING
THERAPY WING
SECTION "D-D"
SECTION "E-E"
SECTION "F-F" FOR PITS
SECTION J-J
SECTION "AB-AB"
For Sections through End Building Wall, Outside Steps, and Retaining Wall at this end, See Sheet 5B.
For Sub-Basement Details, See Sections through Elevator Pit, Stairways, Corridor, etc., on Sheet 5B
In general, exterior concrete foundation walls 8" thick below pouring joint of first floor. Constructing have reinforcing as one face only unless otherwise shown or noted in sections, exterior concrete foundation walls over 8" thick have reinforcing steel on both faces.
Note: Where Pit Walls bear on Column Footings use 5/8" Dowels 2'-6" long placed projecting 1'-0" into Footings and 1'-0" into Walls.
Figures enclosed in Parenthesis thus (-3'-8") indicate elevations of bottoms of wall and column footings below Fin. Basement Floor (Elev. of Fin. Basement Floor = 194.94').
REVISED AS CONSTRUCTED 1-16-1950
APPROVED
Commonwealth of Pennsylvania
DEPARTMENT OF WELFARE
BUREAU OF INSTITUTIONAL MANAGEMENT
Architect
Date
Engineer
HORACE B. NICHOLSON
CONSULTING ENGINEER
223 BROAD ST. STATION
PHILADELPHIA - PENNA.
APPROVED
Commonwealth of Pennsylvania
Department of Labor & Industry
Bureau of Inspection
Buildings Section
Checked By
Approved By
Chief
Approval Date 4-3-47
REVISED
APPROVED
SECRETARY OF PROPERTY & SUPPLIES
APPROVED
CHIEF CONSTRUCTION ENGINEER OF PROPERTY & SUPPLIES
APPROVED
SUBMITTED
ARCHITECT
ACCEPTED
CONTRACTOR
FOUNDATION PLAN
ACTIVE THERAPY BUILDING N3
FOR THE
PHILADELPHIA STATE HOSPITAL
PHILADELPHIA - PENNSYLVANIA
GEORGE W. PEPPER, JR., REGISTERED ARCHITECT
225 SO. 15TH ST. PHILADELPHIA PA.
DATE 4-1-47
SCALE 1/8"=1'-0"
COMMONWEALTH OF PENNA.
JAMES H. DUFF GOVERNOR
DEPT. PROPERTY & SUPPLIES
G. M. WOOLWORTH SECRETARY
HARRISBURG, PENNSYLVANIA
SHEET NO. S1
3-6-3