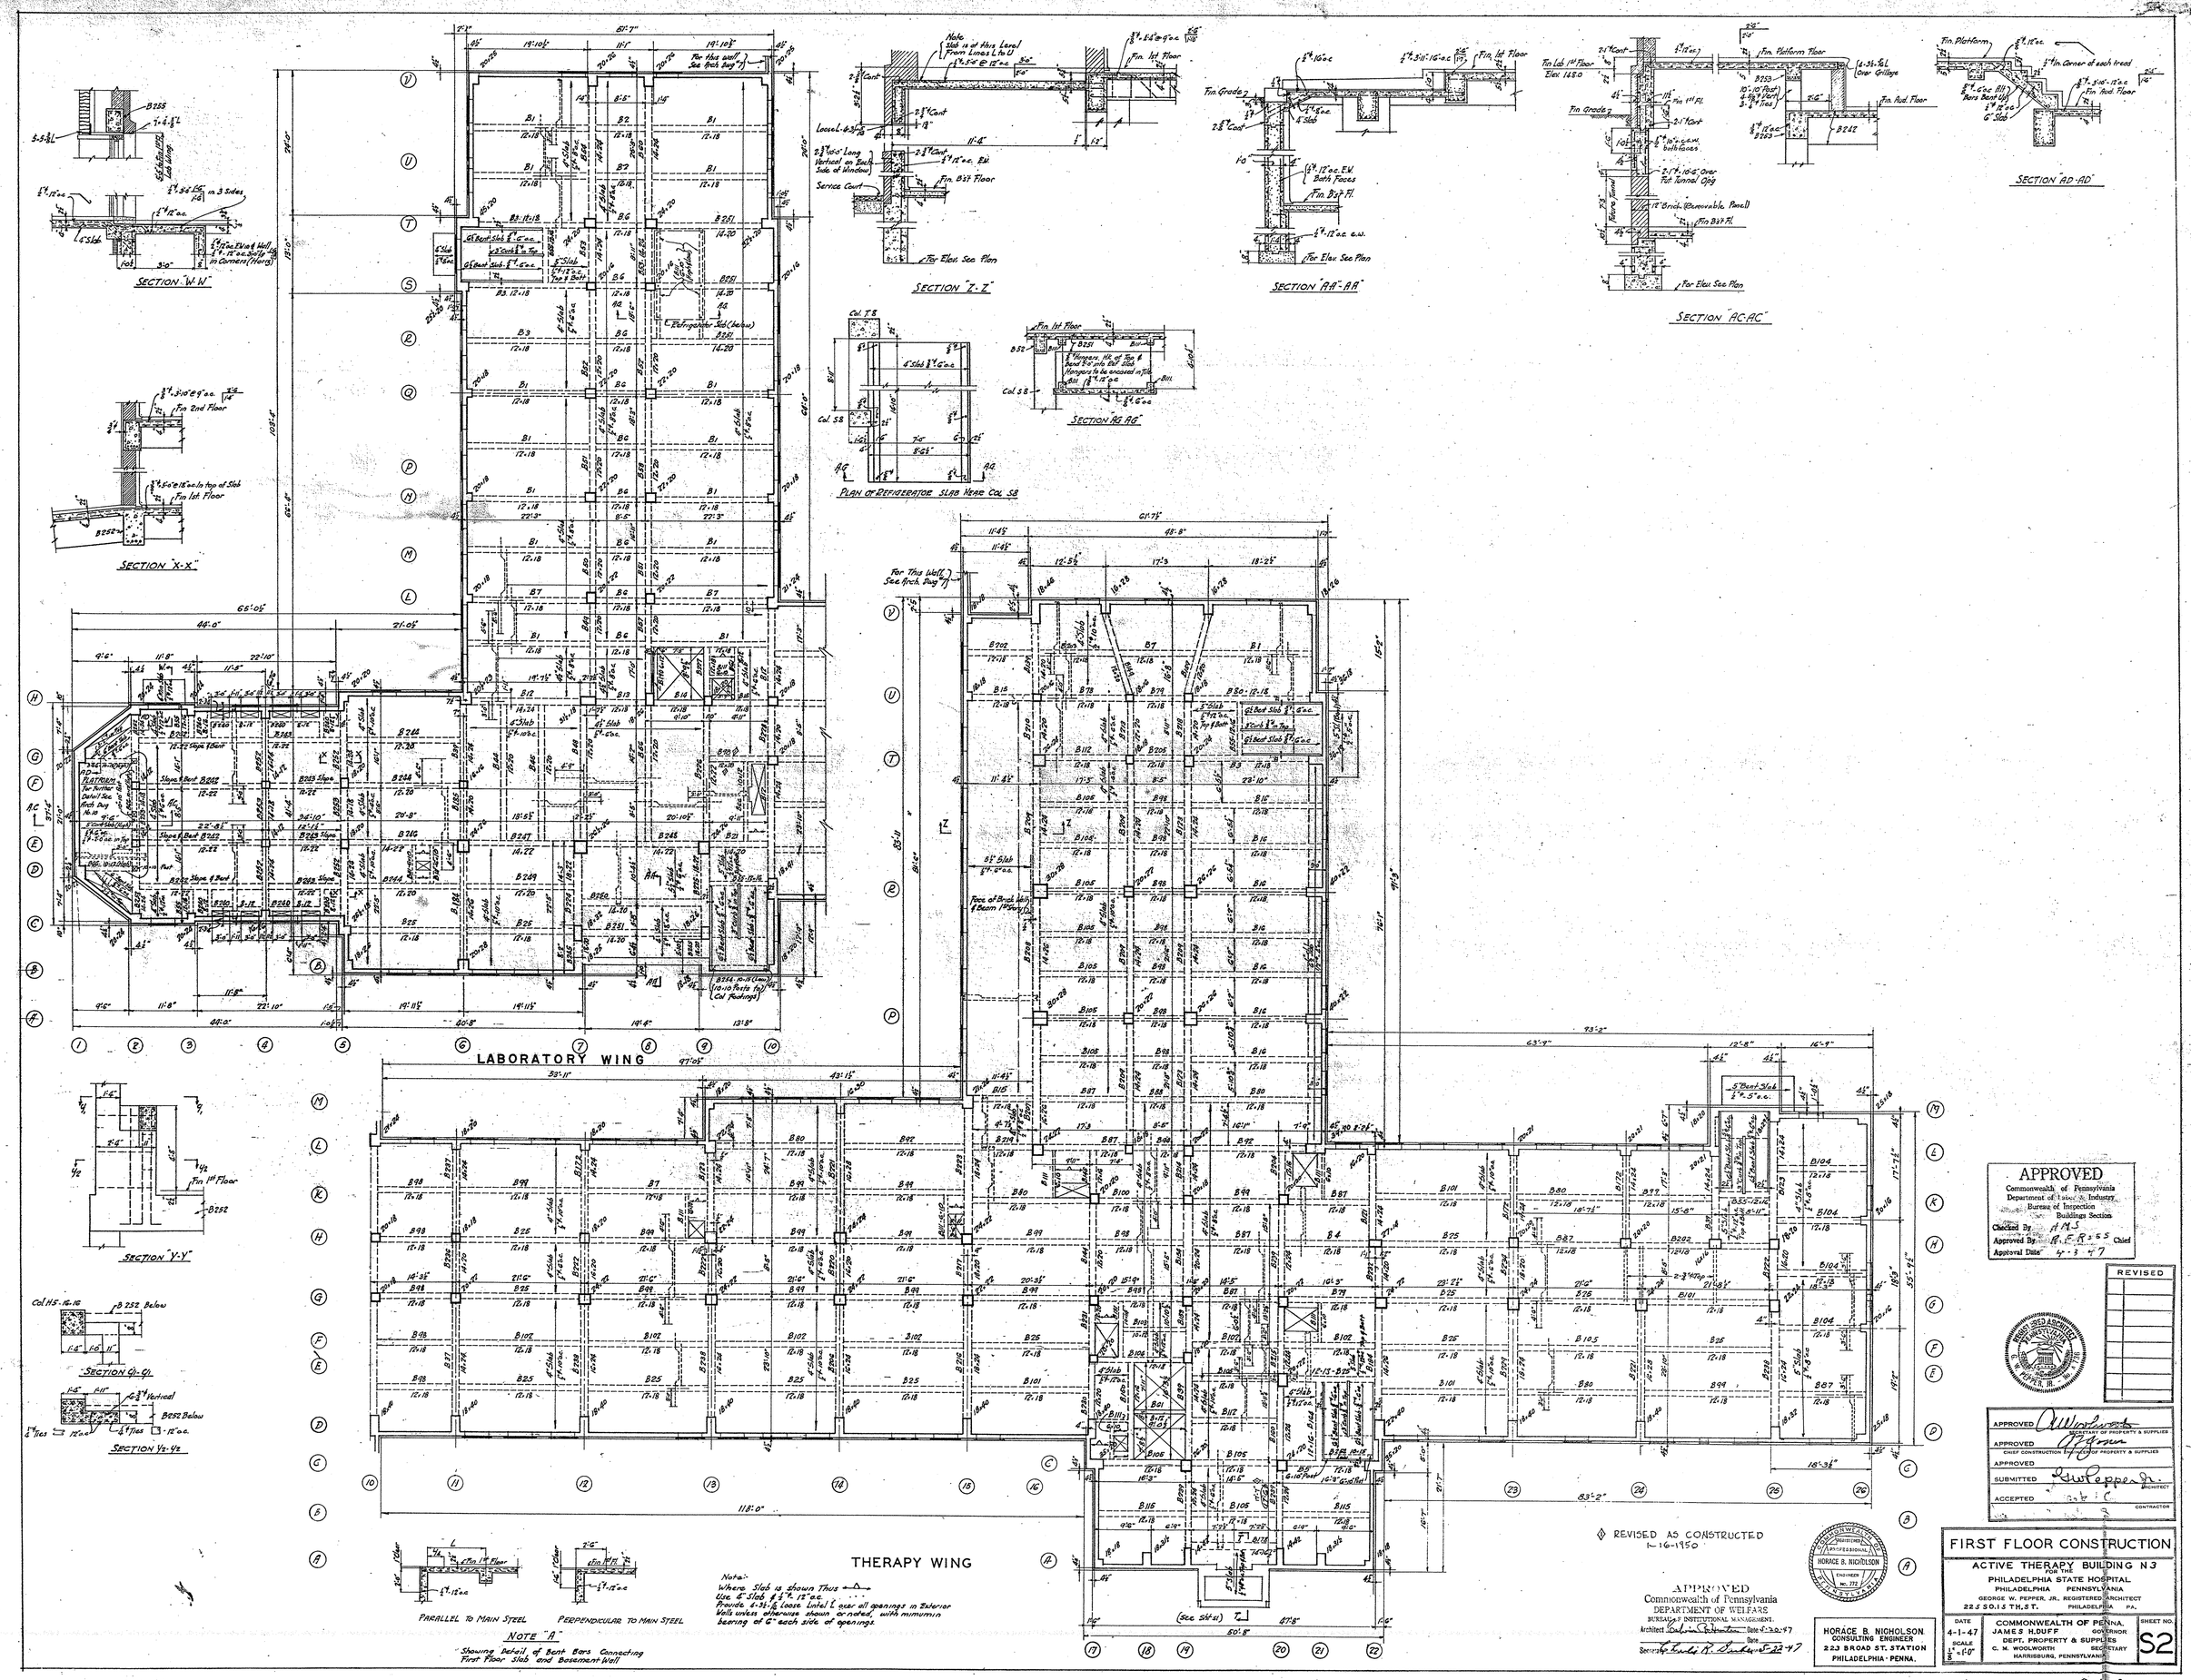
SECTION "W-W"
SECTION "X-X"
SECTION "Z-Z"
SECTION "AA-AA"
SECTION "AC-AC"
SECTION "AD-AD"
SECTION "AB-AB"
PLAN OF REFRIGERATOR SLAB NEAR COL S8
SECTION "Y-Y"
SECTION "G-G"
SECTION "Y2-Y2"
LABORATORY WING
THERAPY WING
PARALLEL TO MAIN STEEL
PERPENDICULAR TO MAIN STEEL
NOTE "A"
Showing Detail of Bent Bars Connecting First Floor Slab and Basement Wall
Note:-
Where Slab is shown Thus
Use 6" Slab & 3/8" ⊕ 12" o.c.
Provide 4-3/8" ⊕ Loose Lateral ℄ over all openings in Exterior Walls unless otherwise shown or noted, with minimum bearing of 6" each side of openings.
REVISED AS CONSTRUCTED 1-16-1950
APPROVED
Commonwealth of Pennsylvania
DEPARTMENT OF WELFARE
BUREAU of INSTITUTIONAL MANAGEMENT
HORACE B. NICHOLSON
CONSULTING ENGINEER
223 BROAD ST. STATION
PHILADELPHIA · PENNA.
APPROVED
Commonwealth of Pennsylvania
Department of Labor & Industry
Bureau of Inspection
Buildings Section
Approval Date 4-3-47
REVISED
APPROVED
SECRETARY OF PROPERTY & SUPPLIES
APPROVED
CHIEF CONSTRUCTION & MAINT. OF PROPERTY & SUPPLIES
APPROVED
SUBMITTED
ARCHITECT
ACCEPTED
CONTRACTOR
FIRST FLOOR CONSTRUCTION
ACTIVE THERAPY BUILDING N3
FOR THE
PHILADELPHIA STATE HOSPITAL
PHILADELPHIA PENNSYLVANIA
GEORGE W. PEPPER, JR., REGISTERED ARCHITECT
225 SOUTH 15TH ST. PHILADELPHIA PA.
DATE 4-1-47
SCALE 1/8" = 1'-0"
COMMONWEALTH OF PENNA.
JAMES H. DUFF GOVERNOR
DEPT. PROPERTY & SUPPLIES
C. M. WOOLWORTH SECRETARY
HARRISBURG, PENNSYLVANIA
SHEET NO. S2