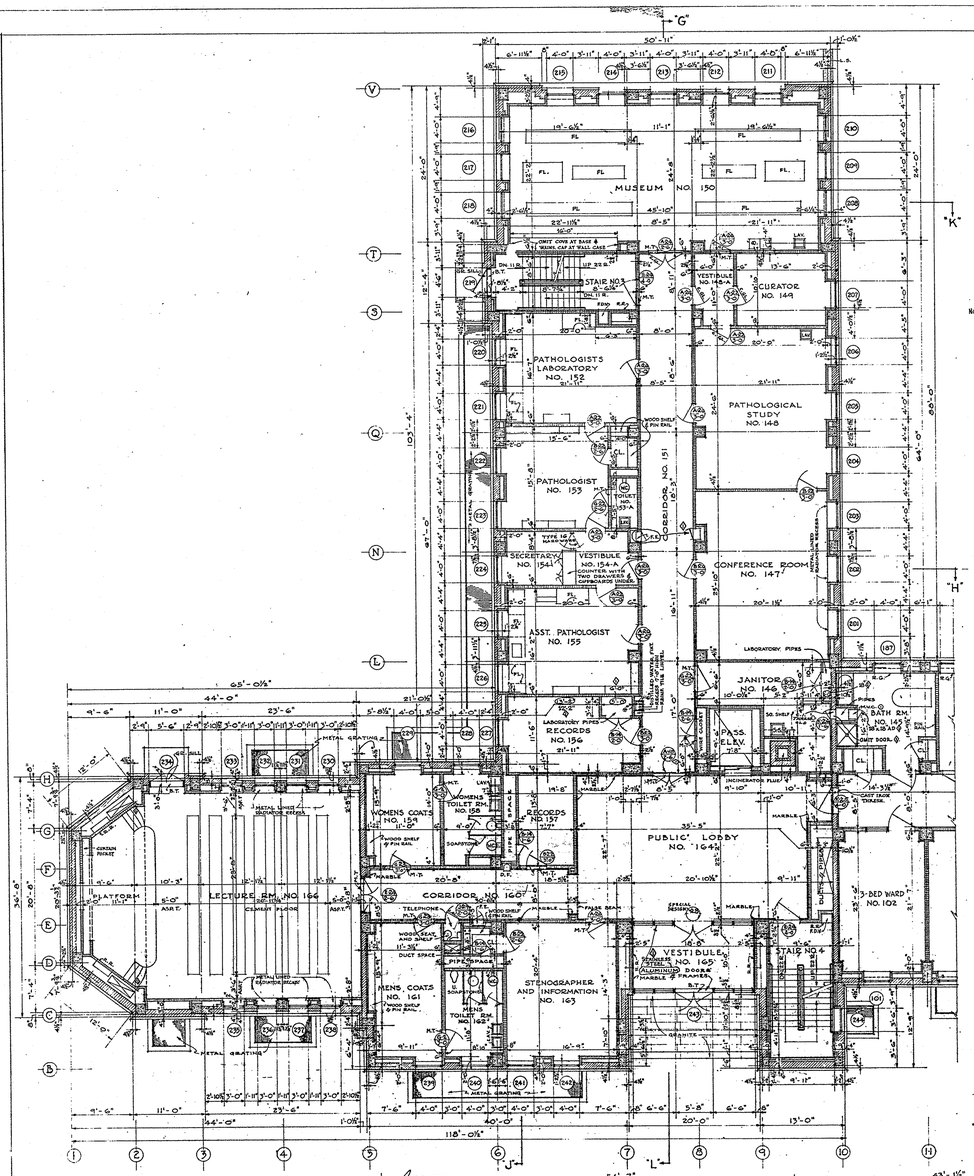

NOTE:- FLOORING STOPS AT LABORATORY EQUIPMENT EXCEPT WHERE MARKED "FL." WHERE IT WILL CARRY UNDER EQUIPMENT.

◊ CEILING HEIGHTS
FOR FLOORS ABOVE BASEMENT
UNLESS NOTED OTHERWISE
CORRIDORS - 9'-0"
ROOMS - 10'-0"
TEL. BOOTHS } 8'-0"
SMALL CLOSETS }

◊ NOTE
ALL 5" C.G. CHANGED TO 2½"

#8283
STATE ART COMMISSION
APR 3 1947
RECEIVED

STATE ART COMMISSION
4-3-47

SCHEDULE OF ROOM FINISHES · LABORATORY WING							
· ROOM ·	NO.	FLOOR	BASE	WAINS. HEIGHT	WAINS. CAP	WALL	CEILING	· REMARKS ·
CLOSETS		SAME FINISH AS ADJOINING ROOM EXCEPT WALLS ARE CERAMIC TILE TO CEIL.						WOOD SHELF & PIN RAIL
JANITOR	146	TER.	GSFT	—	—	GSFT	FUR. PL.	SQ. SHELF W.P. FLOOR
CONFERENCE RM.	147	ASR.T.	MAGNESITE	K.C. 3'-0½"	—	PL.	FUR. PL.	WOOD SILLS & CHAIR RAIL
PATHOLOGICAL STUDY	148	ASR.T.	GSFT	GSFT 3'-0½"	GSFT ~~5'-0"~~	PL.	FUR. PL.	4'-4½" GSFT WAINS. & CAP 3'-2" WIDE AT LAV.
VESTIBULE	148-A	ASR.T.	GSFT	GSFT 3'-0½"	GSFT ~~5'-0"~~	PL.	FUR. PL.	
CURATOR	149	ASR.T.	GSFT	GSFT 3'-0½"	GSFT ~~5'-0"~~	PL.	FUR. PL.	SH. ~~5'-0"~~ SILL
MUSEUM	150	TER.	GSFT	GSFT 3'-0½"	GSFT ~~5'-0"~~	PL.	FUR. ACOUS.	SQ. SILLS 4'-4½" GSFT WAINS. & CAP 2'-0" WIDE AT LAV.
CORRIDOR	151	ASR.T.	GSFT	—	—	GSFT	FUR. ACOUS.	
PATHOLOGISTS LABORATORY	152	ASR.T.	GSFT	—	—	GSFT	FUR. ACOUS.	
PATHOLOGIST	153	ASR.T.	GSFT	GSFT 3'-0½"	GSFT ~~5'-0"~~	PL.	FUR. PL.	B.N. ~~5'-0"~~ SILLS
TOILET ROOM	153-A	CER.T.	GSFT	GSFT 3'-0½"	GSFT ~~5'-0"~~	K.C.	FUR. K.C.	METAL ◊
SECRETARY	154	ASR.T.	GSFT	GSFT 3'-0½"	GSFT ~~5'-0"~~	PL.	FUR. PL.	WOOD COUNTER. WOOD GATE & JAMBS
VESTIBULE	154-A	ASR.T.	GSFT	GSFT 3'-0½"	GSFT ~~5'-0"~~	PL.	FUR. PL.	B.N. ◊
ASSISTANT PATHOLOGIST	155	ASR.T.	GSFT	—	—	GSFT	FUR. PL.	
RECORDS	156 157	ASR.T.	GSFT	—	—	GSFT	FUR. PL.	
WOMENS TOILET ROOM	158	CER.T.	GSFT	—	—	GSFT	FUR. K.C.	SQ. TOILET PARTITIONS H.M. CUBICLE DOORS
WOMENS COATS	159	ASR.T.	GSFT	—	—	GSFT	FUR. PL.	WOOD SHELF & PIN RAIL
CORRIDOR	160	TER.	TER.	—	—	MARBLE	FUR. ACOUS.	SEE SHEET N°16 FOR DETAILS
MENS COATS	161	ASR.T.	GSFT	—	—	GSFT	FUR. PL.	WOOD SHELF & PIN RAIL
MENS TOILET ROOM	162	CER.T.	GSFT	—	—	GSFT	FUR. K.C.	SQ. TOILET PARTITIONS H.M. CUBICLE DOORS
STENOGRAPHER AND INFORMATION	163	ASR.T.	GSFT	GSFT 3'-0½"	GSFT ~~5'-0"~~	PL.	FUR. PL.	B.N. ~~5'-0"~~ SILLS
PUBLIC LOBBY	164	TER.	TER.	—	—	MARBLE	FUR. ACOUS.	SEE SHEET N°16 FOR DETAILS
VESTIBULE	165	TER.	TER.	—	—	MARBLE	FUR. PL.	SEE SHEET N°16 FOR DETAILS
LECTURE ROOM [UNDER SEATS]	166	CEM.	WOOD	K.C. VARIES	WOOD	PL. ON 1-WALL ACOUS. 3-WALL	FUR. PL.	WOOD DADO RAIL AND SILLS SEE SHEET N°10 F.26 DETAILS
[AISLES]		ASP.T.						
[PLATFORM]		LINOLEUM	WOOD	—	—	K.C.	FUR. PL.	
TELEPHONE	—	TER.	TER.	—	—	K.C.	FUR. K.C.	WOOD SEAT AND SHELF
STAIRS	3-4	SO.	GSFT WOOD	—	—	GSFT	EXP. CONC.	
WIRE CLOSET	—	CEM.	UNFINISHED PAINT WALLS, TRIM & CONDUITS				EXP. CONC.	
LABORATORY PIPES	—	CEM.	UNFINISHED PAINT WALLS, TRIM & PIPES				EXP. CONC.	FLOOR RAISED 5" ABOVE FIN. FL.

ALL INTERIOR SILLS TO BE BULL NOSE TILE UNLESS OTHERWISE NOTED
RADIATOR RECESSES ARE DESIGNATED BY DOTTED LINE
GSF TILE RECESSES IN BACK OF LAB. EQUIPMENT INDICATED THUS

SCHEDULE OF ROOM FINISHES · THERAPY WING							
· ROOM ·	· NUMBER ·	FLOOR	BASE	WAINS. HEIGHT	WAINS. CAP	WALL	CEILING	· REMARKS ·
CLOSETS		SAME FINISH AS ADJOINING ROOM EXCEPT WALLS ARE CERAMIC TILE TO CEIL.						WOOD SHELVING
WARD CORRIDORS	101 118 151	TER.	GSFT	—	—	GSFT	FUR. ACOUS.	
3, 4 & 6 BED WARDS	102 103 104 105 115 116 119 127 128 129 133	TER.	GSFT	—	—	GSFT	FUR. PL.	
DINING ROOM	106	Q.T.	Q.T.	—	—	GSFT	FUR. ACOUS.	WATERPROOF FLOOR
SERVING KITCHEN	107	Q.T.	Q.T.	—	—	GSFT	FUR. ACOUS.	BUILT-IN CABINET WATERPROOF FLOOR
JANITORS' CLOSET	108	Q.T.	Q.T.	—	—	GSFT	FUR. PL.	WATERPROOF FLOOR SQ. SHELF
SERVICE CORRIDOR	109	TER.	GSFT	—	—	GSFT	FUR. ACOUS.	
NURSES STATION	110	TER.	GSFT	—	—	GSFT	FUR. ACOUS.	SEE DETAIL SH.N°15
VISITORS	111	TER.	GSFT	—	—	GSFT	FUR. ACOUS	METAL CUBICLES
PUBLIC LOBBY	112	TER.	TER.	—	—	MARBLE	FUR. ACOUS.	SEE DETAIL SH.N°16
SUPERVISOR	113	TER.	GSFT	GSFT 3'-0½"	GSFT ~~5'-0"~~	PL.	FUR. PL.	
TOILET ROOMS (NON-PATIENT)	113-A 114-A 125 137	CER.T.	GSFT	GSFT 7'-2½"	GSFT 2¼"	K.C.	FUR. K.C.	9'-0" CEILING IN ROOM 129 ◊
STENOGRAPHER DOCTORS OFFICES	114 114-B 114-C	TER.	GSFT	GSFT 7'-2½"	GSFT 2¼"	PL.	FUR. PL.	
RECORDS	114-D	TER.	GSFT	GSFT 7'-2½"	GSFT 2¼"	PL.	FUR. PL.	
DAY-ROOMS	117 130	TER.	GSFT	—	—	GSFT	FUR. PL.	
SINGLE BED RMS	132	TER.	GSFT	—	—	GSFT	FUR. PL	
SINK ROOMS	121 134 143	CER.T.	GSFT	—	—	GSFT	FUR. ACOUS.	SEE DETAILS SH.N°15 WATER-PROOF FLOOR
TOILET ROOMS (PATIENT)	122 135 144	CER.T.	GSFT	—	—	GSFT	FUR. K.C.	SEE DETAILS SH.N°15 WATERPROOF FLOOR
BATH ROOMS	123 136 145	ABR.T.	GSFT	—	—	GSFT	FUR. K.C.	SEE DETAILS SH.N°15 WATERPROOF FLOOR
LINENS	124	TER.	GSFT	—	—	GSFT	FUR. PL.	
LITTERS	126	TER.	GSFT	—	—	GSFT	FUR. PL	
UTILITY ROOM	138	CER.T.	GSFT	—	—	GSFT	FUR. ACOUS	SEE DETAIL SH.N°15
JANITORS ROOM	139	TER.	GSFT	—	—	GSFT	FUR. PL.	SEE DETAIL SH.N°15
DAY-ROOM & OCCUPATIONAL THERAPY	140	TER.	GSFT	—	—	GSFT	FUR. PL.	HANGING CABINET
EXAMINATION RM.	141	TER.	GSFT	—	—	GSFT	FUR. PL.	
DOCTORS ROOM	142	TER.	GSFT	—	—	GSFT	FUR. PL.	
STAIRS	1 - 2 - 3	SO.	GSFT NO COVE	—	—	GSFT	EXP. CONC.	FUR. PL. CEIL. IN STAIR SEE DETAIL · SHEET 14
WIRE CLOSET	—	CEM.	UNFINISHED PAINT WALLS, TRIM & CONDUITS				EXP. CONC.	

ALL INTERIOR SILLS TO BE SOAPSTONE UNLESS OTHERWISE NOTED
ALL BATH ROOM PIPE SPACES TO HAVE CEMENT FLOOR RAISED 5" ABOVE FIN. FL.
RADIATOR RECESSES ARE DESIGNATED BY DOTTED LINE

◊ 4'-7" CEILING
◊ 9'-0" CEILING IN ROOM 129
◊ 10' CEILING

GENERAL NOTES

SEE SHEET N°1 FOR ABBREVIATIONS AND MATERIAL INDICATIONS
ALL PIERS 2'-1" OR LESS IN WIDTH BETWEEN OPENINGS TO BE SOLID BRICK
SEE DETAIL AT COLUMN D-13 ON SHEET N°3 FOR SOLID BRICK
REINFORCED TILE OR STEEL ANGLE LINTEL OVER ALL DUCT AND GRILLE OPENINGS IN PARTITIONS.
LOCATION OF ALL BEDS TO BE AS DIRECTED

HARDWARE FOR EXTERIOR DOORS
DOOR N°S 118-243 HAVE HARDWARE TYPE N°27
DOOR N°S 138-156-166-173-176 HAVE HARDWARE TYPE N°1
DOOR N° 234 TO HAVE HARDWARE TYPE N°19
DOOR N° 219 TO HAVE HARDWARE TYPE N° 1

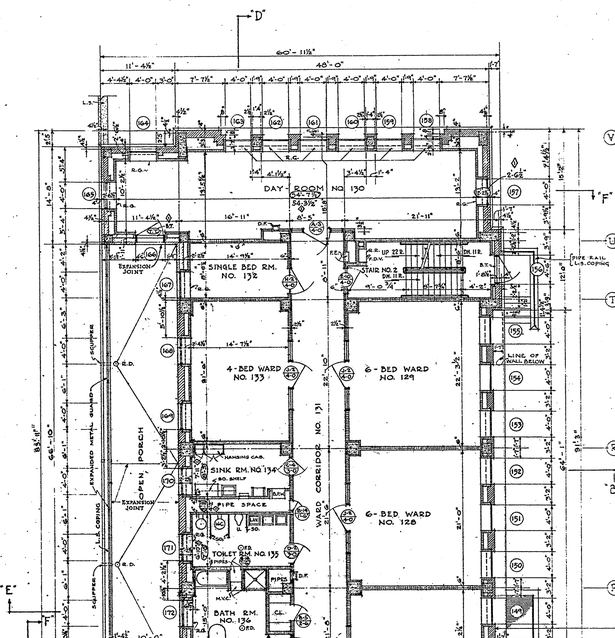

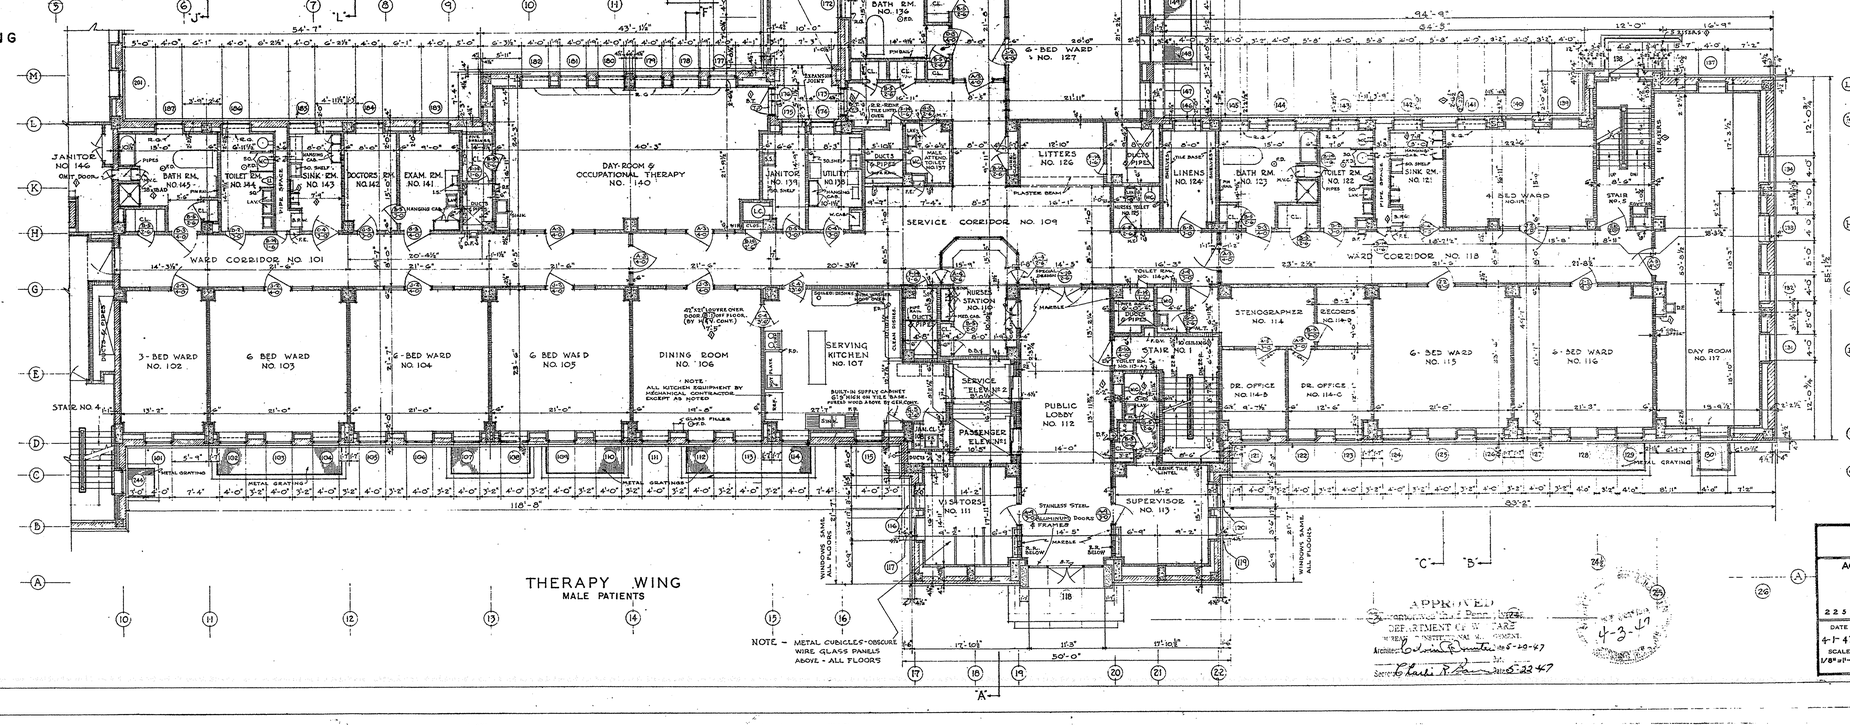

NOTE - METAL CUBICLES-OBSCURE WIRE GLASS PANELS ABOVE - ALL FLOORS

APPROVED
Commonwealth of Pennsylvania
Department of Property & Supplies
Bureau of Engineering
Buildings Section
Checked by
Approved By R. E. Ross Chief
Approval Date 4-3-47

◊ REVISED AS CONSTRUCTED 1-16-50

REVISED

APPROVED — CHIEF CONSTRUCTION ENGINEER OF PROPERTY & SUPPLIES
APPROVED — CHIEF CONSTRUCTION ENGINEER OF PROPERTY & SUPPLIES
SUBMITTED — ARCHITECT
ACCEPTED — CONTRACTOR

APPROVED
Commonwealth of Pennsylvania
DEPARTMENT OF WELFARE
BUREAU OF INSTITUTIONAL ENGINEERING
Architect 4-22-47
Sec'y 4-22-47

4-3-47

FIRST FLOOR PLAN

ACTIVE THERAPY BUILDING N°3
FOR THE
PHILADELPHIA STATE HOSPITAL
PHILADELPHIA PENNSYLVANIA
GEORGE W. PEPPER, JR. REGISTERED ARCHITECT
225 SOUTH 15TH. STREET PHILADELPHIA 3, PA.

DATE	COMMONWEALTH OF PENNA.	SHEET NO
4-1-47	GOVERNOR JAMES H. DUFF	2
SCALE 1/8"=1'-0"	DEPT. PROPERTY & SUPPLIES SECRETARY C.M. WOOLWORTH HARRISBURG, PENNSYLVANIA	

3-6-3