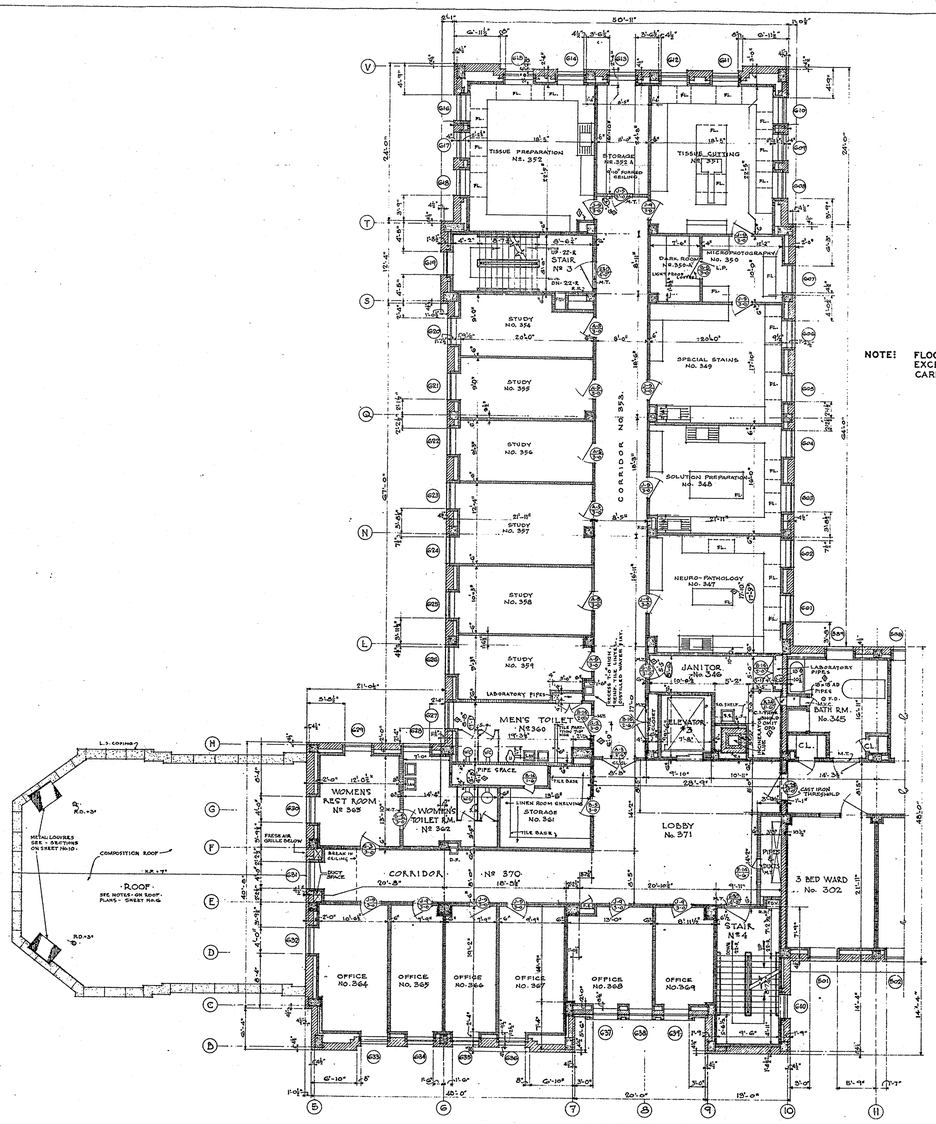

LABORATORY WING

NOTE: FLOORING STOPS AT LABORATORY EQUIPMENT EXCEPT WHERE MARKED "FL" WHERE IT WILL CARRY UNDER EQUIPMENT.

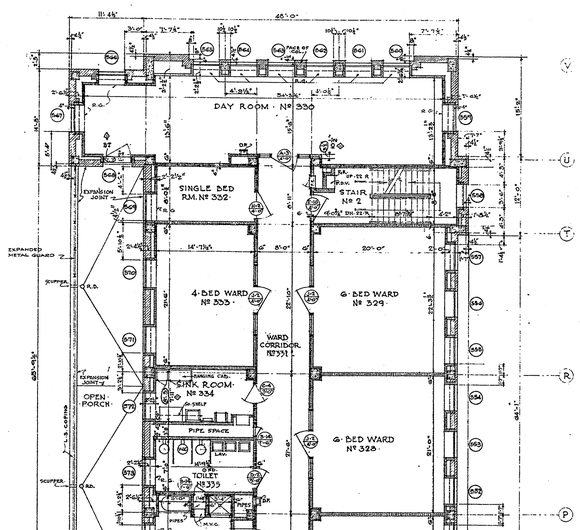

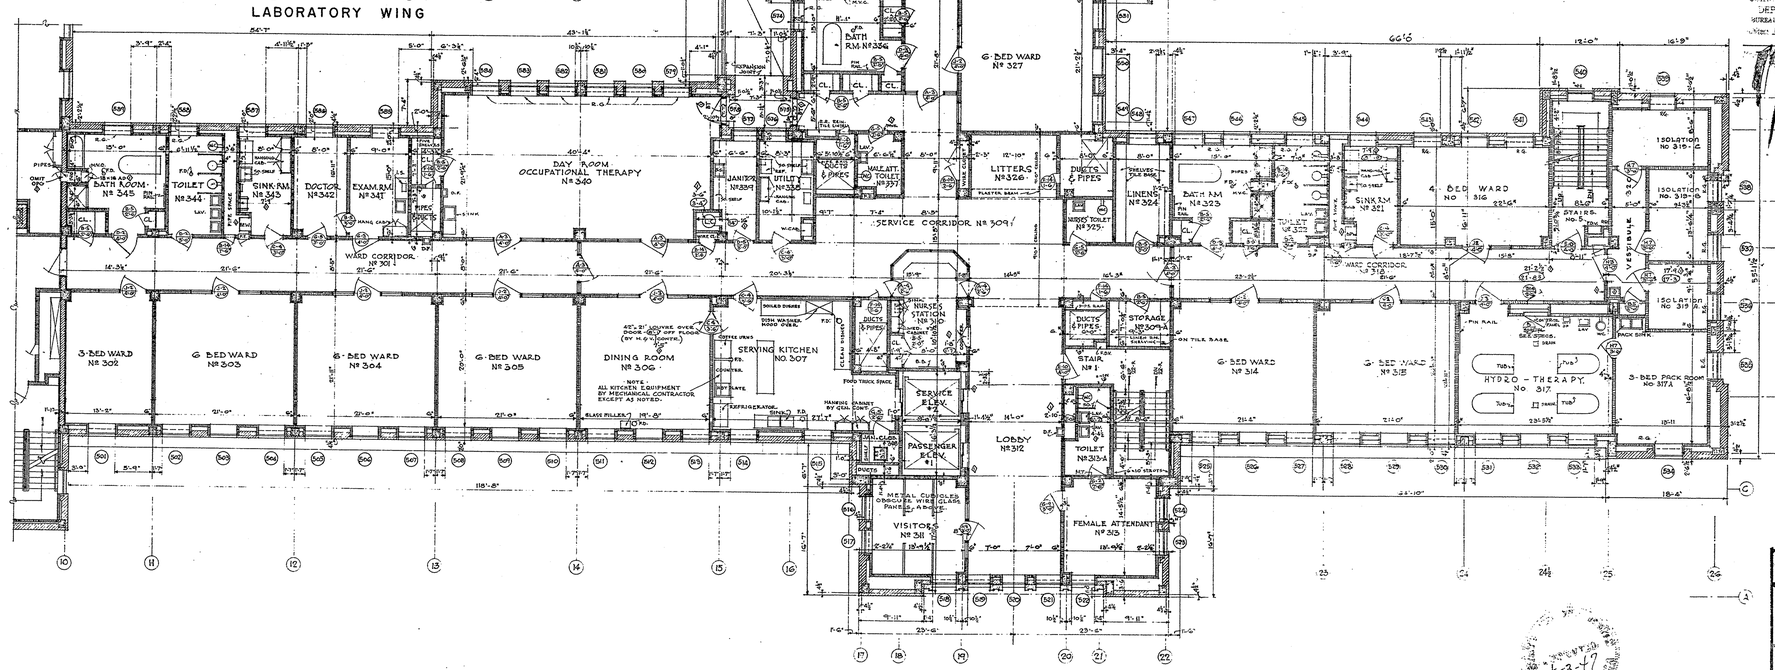

THERAPY WING
FEMALE PATIENTS

SCHEDULE OF ROOM FINISHES · LABORATORY WING								
ROOM	NO.	FLOOR	BASE	WAINS HEIGHT	WAINS CAP	WALL	CEILING	REMARKS
JANITOR	346	TER.	G.S.F.T.	—	—	G.S.F.T.	FUR. PL.	
NEURO-PATHOLOGY	347	ASP.T.	G.S.F.T.	—	—	G.S.F.T.	FUR. PL.	
SOLUTION PREPERATION	348	ASP.T.	G.S.F.T.	—	—	G.S.F.T.	FUR. PL.	
SPECIAL STAINS	349	ASP.T.	G.S.F.T.	—	—	G.S.F.T.	FUR. PL.	
MICROPHOTOGRAPHY	350	ASP.T.	G.S.F.T.	—	—	G.S.F.T.	FUR. PL.	
DARK ROOM	350A	ASP.T.	G.S.F.T.	—	—	G.S.F.T.	FUR. PL.	LIGHT PROOF DOOR WITH L.P. LOUVRES.
TISSUE CUTTING	351	ASP.T.	G.S.F.T.	—	—	G.S.F.T.	FUR. PL.	
TISSUE PREPARATION	352	ASP.T.	G.S.F.T.	—	—	G.S.F.T.	FUR. PL.	
STORAGE	352A	TER.	G.S.F.T.	—	—	G.S.F.T.	FUR. PL.	
CORRIDOR	353	ASP.T.	G.S.F.T.	—	—	G.S.F.T.	FUR. ACOUS.	
STUDY ROOMS	354 355 356 357 358 359	ASP.T.	G.S.F.T.	—	—	G.S.F.T.	FUR. PL.	
MENS' TOILET	360	CER.T.	G.S.F.T.	—	—	G.S.F.T.	FUR. K.C.	S.O. TOILET PARTITIONS H.M. CUBICLE DOORS
STORAGE	361	ASP.T.	G.S.F.T.	—	—	G.S.F.T.	FUR. PL.	WOOD SHELVING WITH SHIT BASE
WOMENS TOILET	362	CER.T.	G.S.F.T.	—	—	G.S.F.T.	FUR. K.C.	S.O. TOILET PARTITIONS H.M. CUBICLE DOORS
WOMENS REST ROOM	363	ASP.T.	G.S.F.T.	G.S.F.T. 3'-0½"	G.S.F.T. 3'-0½"	PL.	FUR. PL.	CAP STRETCHER SILL
OFFICES.	364 365 366 367 368 369	ASP.T.	G.S.F.T.	G.S.F.T. 3'-0½"	G.S.F.T. 3'-0½" ◊	PL.	FUR. PL.	6"-8" SILL B.N. ◊
CORRIDOR	370	ASP.T.	G.S.F.T.	—	—	G.S.F.T.	FUR. ACOUS.	
LOBBY	371	ASP.T.	G.S.F.T.	—	—	G.S.F.T.	FUR. ACOUS.	
STAIRS	3&4	S.O.	G.S.F.T. NO COVE	—	—	G.S.F.T.	EXP. CONC.	
WIRE CLOSET.	—	CEM.	UNFINISHED. PAINT WALLS, TRIM & CONDUITS				EXP. CONC.	
LABORATORY PIPES	—	CEM.	UNFINISHED. PAINT WALLS, TRIM & PIPES				EXP. CONC.	FLOOR RAISED 5" ABOVE FIN. FLOOR

INTERIOR SILLS TO BE BULL-NOSE TILE UNLESS OTHERWISE NOTED.
G.S.F. TILE RECESSES IN BACK OF LAB. EQUIPMENT ARE INDICATED THUS

SCHEDULE OF ROOM FINISHES · THERAPY WING								
ROOM	NUMBER	FLOOR	BASE	WAINS HEIGHT	WAINS CAP	WALL	CEILING	REMARKS
CLOSETS		FINISH SAME AS ADJOINING ROOM EXCEPT WALLS ARE G.S.F.T. TO CEILING						WOOD SHELVING
WARD CORRIDORS	301 · 318 · 351 ·	TER	G.S.F.T.	—	—	G.S.F.T.	FUR. ACOUS.	
3-4-5-6 BED WARDS	302 · 303 · 304 305 · 314 · 315 327 · 328 · 329 333 · 316	TER.	G.S.F.T.	—	—	G.S.F.T.	FUR. PL.	
DINING ROOM	306	Q.T.	Q.T.	—	—	G.S.F.T.	FUR. ACOUS.	WATERPROOF FLOOR
SERVING KITCHEN	307	Q.T.	Q.T.	—	—	G.S.F.T.	FUR. ACOUS.	HANGING CABINET W/ WATERPROOF FLOOR
JANITORS' CLOS	308	Q.T.	Q.T.	—	—	G.S.F.T.	FUR. PL.	WATERPROOF FLOOR, SO. SHELF
SERVICE CORRIDOR	309	TER.	G.S.F.T.	—	—	G.S.F.T.	FUR. ACOUS.	
STORAGE ROOM	309-A	TER.	G.S.F.T.	—	—	G.S.F.T.	FUR. PL.	METAL SHELVING WITH SHIT BASE
NURSES STATION	310	TER.	G.S.F.T.	—	—	G.S.F.T.	FUR. ACOUS.	SEE DETAIL SH.#15
VISITORS	311	TER.	G.S.F.T.	—	—	G.S.F.T.	FUR. ACOUS.	METAL CUBICLES.
LOBBY	312	TER.	G.S.F.T.	—	—	G.S.F.T.	FUR. ACOUS.	11'0" CEILING ◊
FEMALE ATTENDANTS	313	TER.	G.S.F.T.	G.S.F.T. 3'-0½"	G.S.F.T. 3'-0½"	FL.	FUR. PL.	
TOILET ROOMS (NON-PATIENT)	313-A · 323 · 337	CER.T.	G.S.F.T.	G.S.F.T. 7'-0½"	G.S.F.T. 3'-0½"	K.C.	FUR. K.C.	RM. 313-A. TO HAVE SO. PART. & H.M. DOORS
ISOLATION	319-A · 319-B · 319-C	TER.	G.S.F.T.	—	—	G.S.F.T.	FUR. ACOUS.	9'-0" CEILING ◊
VESTIBULE	320	TER.	G.S.F.T.	—	—	G.S.F.T.	FUR. ACOUS.	8'-9" CEILING ◊
DAY ROOMS	330	TER.	G.S.F.T.	—	—	G.S.F.T.	FUR. PL.	
SINGLE BED ROOM	332	TER.	G.S.F.T.	—	—	G.S.F.T.	FUR. PL.	
SINK ROOM	321 · 334 · 343	CER.T.	G.S.F.T.	—	—	G.S.F.T.	FUR. ACOUS.	SEE DETAIL SH.#15 WATERPROOF FLOORS
TOILET ROOM (PATIENT)	322 · 335 · 344	CER.T.	G.S.F.T.	—	—	G.S.F.T.	FUR. K.C.	SEE DETAIL SH.#15 WATERPROOF FLOORS
BATH ROOM	323 · 336 · 345	ABR.T.	G.S.F.T.	—	—	G.S.F.T.	FUR. K.C.	SEE DETAIL SH.#15 WATERPROOF FLOORS
LINENS	324	TER.	G.S.F.T.	—	—	G.S.F.T.	FUR. PL.	6"-8" SHIT BASE SEE DETAIL SH.#15
LITTERS	326	TER.	G.S.F.T.	—	—	G.S.F.T.	FUR. PL.	
UTILITY	338	CER.T.	G.S.F.T.	—	—	G.S.F.T.	FUR. ACOUS.	SEE DETAIL SH.#15
JANITOR	339	TER.	G.S.F.T.	—	—	G.S.F.T.	FUR. PL.	SEE DETAIL SH.#15
DAY ROOM OCCUPATIONAL THERAPY	340	TER.	G.S.F.T.	—	—	G.S.F.T.	FUR. PL.	
EXAM. ROOM	341	TER.	G.S.F.T.	—	—	G.S.F.T.	FUR. PL.	HANGING CABINET
DOCTOR	342	TER.	G.S.F.T.	—	—	G.S.F.T.	FUR. PL.	
STAIR	1 · 2 · 5	S.O.	G.S.F.T. NO COVE	—	—	G.S.F.T.	EXP. CONC.	SEE DETAIL SH.#14
WIRE CLOSET	——	CEM.	UNFINISHED · PAINT WALLS, TRIM & CONDUITS				EXP. CONC.	
HYDRO-THERAPY & PACK ROOM	317 · 317 A.	ABR.T.	G.S.F.T.	-	-	G.S.F.T.	FUR. K.C.	WATERPROOF FLOORS PIN RAIL.

INTERIOR SILLS TO BE SOAPSTONE UNLESS OTHERWISE NOTED
ALL BATH RM. PIPE SPACES TO HAVE CEMENT FL. RAISED 5" ABOVE FIN. FL.
RADIATOR RECESSES ARE DESIGNATED BY DOTTED LINE THUS

GENERAL NOTES

SEE SHEET Nº 1 FOR ABBREVIATIONS AND MATERIAL INDICATIONS
ALL PIERS 2'-0" OR LESS IN WIDTH BETWEEN OPENINGS TO BE SOLID BRICK
SEE DETAIL AT COLUMN D-13 SHEET Nº 3 FOR SOLID BRICK WALL
REINFORCED TILE OR STEEL ANGLE LINTELS OVER ALL DUCT & GRILLE OPENINGS IN PARTITIONS.
SEE SHEET NO 2 FOR COMPLETE DIMENSIONS
LOCATION OF ALL BEDS TO BE AS DIRECTED

HARDWARE FOR EXTERIOR DOORS
DOOR Nº 568-575-578 HAVE HARDWARE TYPE Nº1
SPECIAL DOOR TO CONTROL PANEL IN ROOM Nº 317 IS 3'-5" WIDE, 5'-1" HIGH, SET 3'-4" ABOVE FIN. FLOOR, WITH METAL FRAME ON FOUR SIDES - SEE SPECS. FOR HARDWARE.

#2283
STATE WORKS COMMISSION
Apr. 3, 1947
RECEIVED

APPROVED
Commonwealth of Pennsylvania
DEPARTMENT OF WELFARE
BUREAU OF BUILDING CONSTRUCTION
4-3-47

STATE WORKS COMMISSION

APPROVED
Commonwealth of Pennsylvania
Department of Labor & Industry
Bureau of Inspection
Buildings Section
Checked By
Approved By
Approval Date

◊ REVISED AS CONSTRUCTED 1-16-1950

REVISED

REGISTERED ARCHITECT PENNSYLVANIA

APPROVED	SECRETARY OF PROPERTY & SUPPLIES
APPROVED	CHIEF CONSTRUCTION ENGINEER OF PROPERTY & SUPPLIES
APPROVED	
SUBMITTED	ARCHITECT
ACCEPTED	CONTRACTOR

THIRD FLOOR PLAN

ACTIVE THERAPY BUILDING N 3
FOR THE
PHILADELPHIA STATE HOSPITAL
PHILADELPHIA PENNSYLVANIA
GEORGE W. PEPPER, JR. REGISTERED ARCHITECT
2225 S. 15TH. STREET PHILADELPHIA 3, PA.

DATE	COMMONWEALTH OF PENNA.	SHEET NO.
4-1-47	JAMES H. DUFF GOVERNOR	4
SCALE 1/8" = 1'-0"	DEPT. PROPERTY & SUPPLIES C.M. WOOLWORTH SECRETARY HARRISBURG, PENNSYLVANIA	

4-3-47

3-6-3