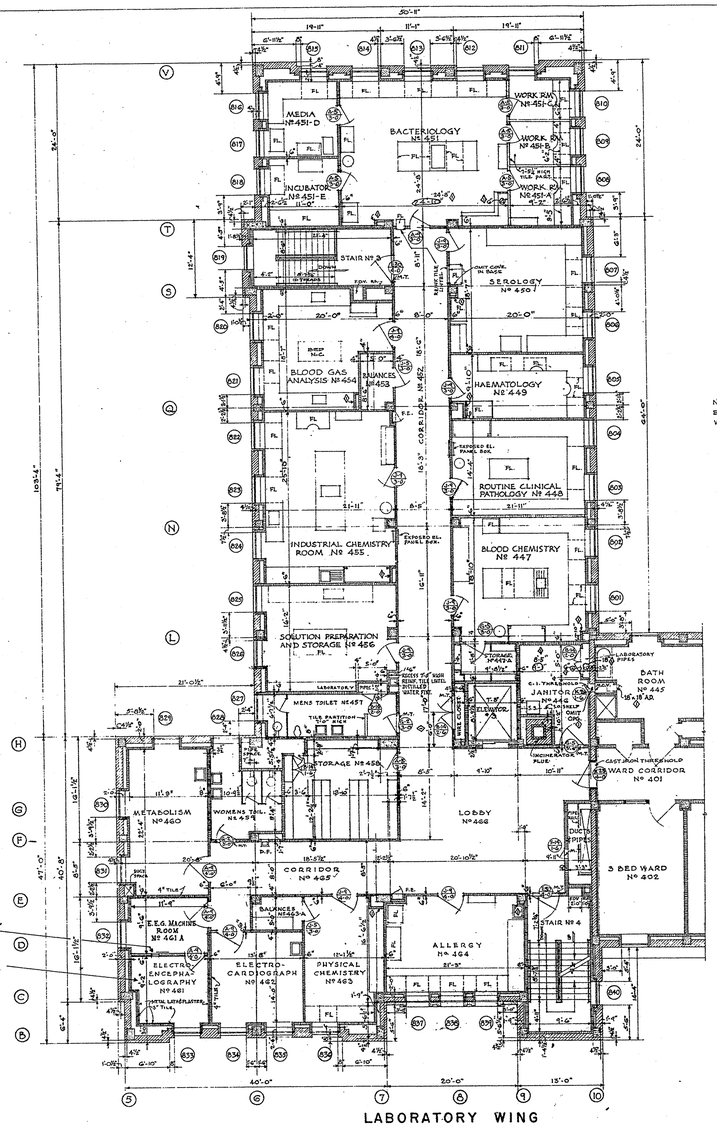

LABORATORY WING

NOTE - FLOORING STOPS AT LABORATORY EQUIPMENT, EXCEPT WHERE MARKED "FL" WHERE IT WILL CARRY UNDER EQUIPMENT

NOTE
1'-2" OBSERVATION WINDOW - FIXED CLEAR GLASS - WOOD FRAME WITH SLIDING WOOD PANEL.

WIRE MESH IN CONCRETE FLOOR, METAL LATH IN WALLS & CEILING, AND H.M. DOOR TO BE GROUNDED.

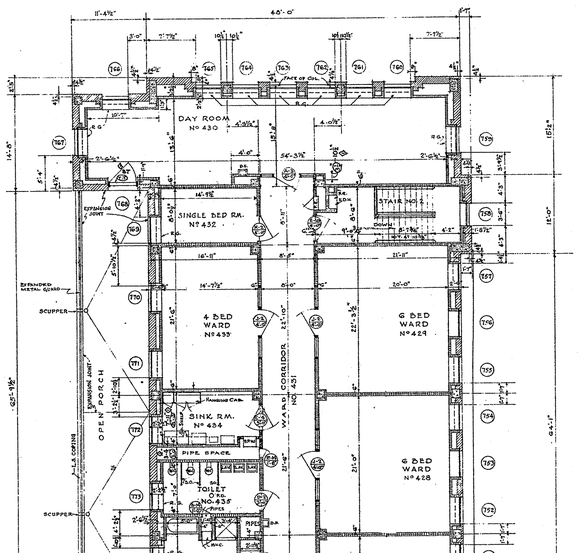

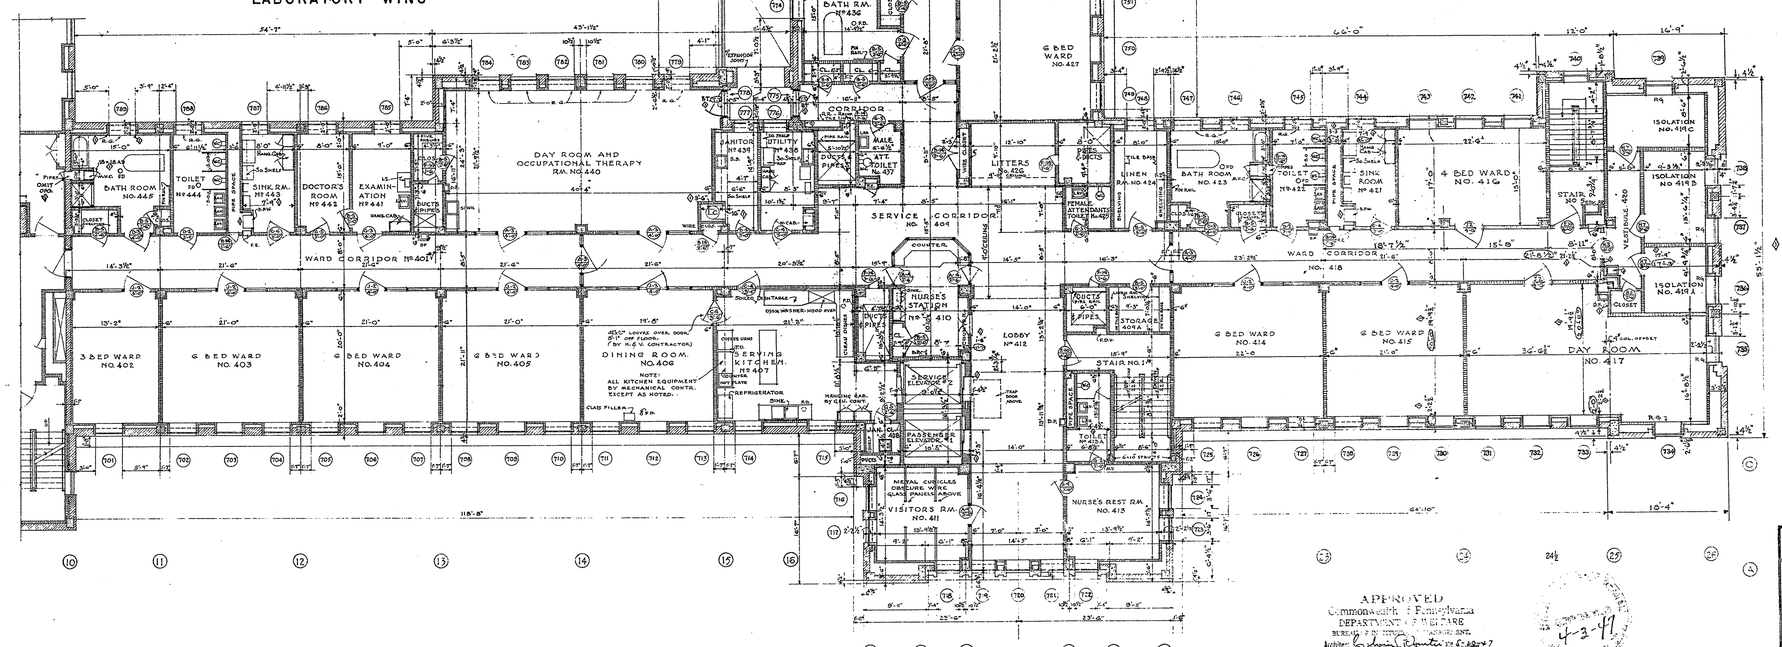

THERAPY WING
FEMALE PATIENTS

SCHEDULE OF ROOM FINISHES · LABORATORY WING

ROOM	NO.	FLOOR	BASE	WAINS. HEIGHT	WAINS. CAP	WALL	CEILING	REMARKS
JANITOR	446	TER.	G.S.F.T.	—	—	G.S.F.T.	EXP. CONC.	SO. SHELF
BLOOD CHEMISTRY	447	ASP.T.	ASP.T.	—	—	G.S.F.T.	EXP. CONC.	WATERPROOF FLOOR.
STORAGE	447-A	ASP.T.	G.S.F.T.	—	—	G.S.F.T.	EXP. CONC.	
ROUTINE CLINICAL PATHOLOGY	448	ASP.T.	G.S.F.T.	—	—	G.S.F.T.	EXP. CONC.	
HAEMATOLOGY	449	ASP.T.	G.S.F.T.	—	—	G.S.F.T.	EXP. CONC.	
SEROLOGY	450	ASP.T.	G.S.F.T.	—	—	G.S.F.T.	EXP. CONC.	
BACTERIOLOGY	451	ASP.T.	G.S.F.T.	—	—	G.S.F.T.	EXP. CONC.	
WORK ROOMS	451-A 451-B 451-C	ASP.T.	G.S.F.T.	—	—	G.S.F.T.	OPEN	TILE PARTITIONS 7'-5¾" HIGH
MEDIA	451-D	ASP.T.	G.S.F.T.	—	—	G.S.F.T.	EXP. CONC.	
INCUBATOR	451-E	ASP.T.	G.S.F.T.	—	—	G.S.F.T.	EXP. CONC.	
CORRIDOR	452	ASP.T.	G.S.F.T.	—	—	G.S.F.T.	FUR. PL.	
BALANCES	453 463-A	ASP.T.	G.S.F.T.	—	—	G.S.F.T.	FUR. PL.	9" CEILING ◊
BLOOD GAS ANALYSIS	454	ASP.T.	G.S.F.T.	—	—	G.S.F.T.	EXP. CONC.	
INDUSTRIAL CHEMISTRY	455	ASP.T.	G.S.F.T.	—	—	G.S.F.T.	EXP. CONC.	WATERPROOF FLOOR
SOLUTION PREPARATION & STORAGE	456	ASP.T.	G.S.F.T.	—	—	G.S.F.T.	EXP. CONC.	
MEN'S TOILET	457	CER.T.	G.S.F.T.	—	—	G.S.F.T.	FUR. K.C.	SO TOILET PARTITION H.M. CUBICLE DOOR.
STORAGE	458	ASP.T.	G.S.F.T.	—	—	G.S.F.T.	EXP. CONC.	
WOMEN'S TIOLET	459	CER.T.	G.S.F.T.	—	—	G.S.F.T.	FUR. K.C.	SO. TOILET PARTITIONS H.M. CUBICLE DOORS
METABOLISM	460	ASP.T.	G.S.F.T.	—	—	G.S.F.T.	EXP. CONC.	
ELECTRO-ENCEPHALOGRAPH	461 461A	ASP.T.	MARBLE	—	—	METAL LATH & PLASTER	FUR. PL.	METAL LATH TO BE GROUNDED EXCEPT IN Nº 461A.
ELECTRO-CARDIOGRAPH	462	ASP.T.	G.S.F.T.	—	—	G.S.F.T.	EXP. CONC.	
PHYSICAL CHEMISTRY	463	ASP.T.	G.S.F.T.	—	—	G.S.F.T.	EXP. CONC.	
ALLERGY	464	ASP.T.	G.S.F.T.	—	—	G.S.F.T.	EXP. CONC.	
CORRIDOR	465	ASP.T.	G.S.F.T.	—	—	G.S.F.T.	FUR. PL.	
LOBBY	466	ASP.T.	G.S.F.T.	—	—	G.S.F.T.	FUR. PL.	
STAIRS	3-4	SO.	G.S.F.T. NO-CONC.	—	—	G.S.F.T.	EXP. CONC.	
LABORATORY PIPES		C.E.M.	UNFINISHED PAINT WALLS, TRIM & PIPES.				EXP. CONC.	FLOOR RAISED 5" ABOVE FIN. FLOOR
WIRE CLOSET		C.E.M.	UNFINISHED PAINT WALLS, TRIM & CONDUITS.				EXP. CONC.	

ALL INTERIOR SILLS TO BE B.N. TILE UNLESS OTHERWISE NOTED
G.S.F. TILE RECESSES IN BACK OF LAB. EQUIPMENT ARE INDICATED THUS

SCHEDULE OF ROOM FINISHES · THERAPY WING

ROOM	NUMBER	FLOOR	BASE	WAINS. HEIGHT	WAINS. CAP	WALL	CEIL.	REMARKS
CLOSETS		FINISH SAME AS ADJOINING ROOMS EXCEPT WALLS ARE 2'-0" TO CEILING.						WOOD SHELVING
WARD CORRIDORS	401, 418, 431	TER.	G.S.F.T.	—	—	G.S.F.T.	FUR. ACOUS	
3, 4, & 6 BED WARDS	402, 403, 404 405, 414, 415, 416 427, 428, 429, 433	TER.	G.S.F.T.	—	—	G.S.F.T.	FUR. PL.	
DINING ROOM.	406	Q.T.	Q.T.	—	—	G.S.F.T.	FUR. ACOUS	WATERPROOF FLOOR
SERVING KITCHEN	407	Q.T.	Q.T.	—	—	G.S.F.T.	FUR. ACOUS	HANGING CABINET WATERPROOF FLOOR
JANITORS' CLOS.	408	Q.T.	Q.T.	—	—	G.S.F.T.	FUR. PL.	WATERPROOF FLOOR SO. SHELF
SERVICE CORRIDOR	409	TER.	G.S.F.T.	—	—	G.S.F.T.	FUR. ACOUS	
STORAGE ROOM.	409-A	TER.	G.S.F.T.	—	—	G.S.F.T.	FUR. PL.	METAL SHELVING IN 5" G.S.F.T. BASE
NURSE'S STATION	410	TER.	G.S.F.T.	—	—	G.S.F.T.	FUR. ACOUS	SEE DETAIL SH.Nº 15
VISITORS ROOM	411	TER.	G.S.F.T.	—	—	G.S.F.T.	FUR. ACOUS	METAL CUBICLES
LOBBY	412	TER.	G.S.F.T.	—	—	G.S.F.T.	FUR. ACOUS	11'-0" CEILING ◊
NURSE'S REST RM.	413	TER.	G.S.F.T.	G.S.F.T. 3'-0"	G.S.F.T. 3'-0"	PL.	FUR. PL.	
TOILET ROOMS (NON-PATIENT)	413-A, 425, 437	CER.T.	G.S.F.T.	G.S.F.T. 7'-3½"	G.S.F.T. 3'-0"	K.C.	FUR. K.C.	RM.Nº 413-A TO HAVE SO. PART. H.M. DOOR.
VESTIBULE & ISOLATION ROOMS	419-A, 419-B 419-C, -D-420	TER.	G.S.F.T.	—	—	G.S.F.T.	FUR. ACOUS	8'-4" CEILING - RM. 420
DAY ROOM	417 - 430	TER.	G.S.F.T.	—	—	G.S.F.T.	FUR. PL.	
SINGLE BED RM.	432	TER.	G.S.F.T.	—	—	G.S.F.T.	FUR. PL.	
SINK ROOMS	421, 434, 443	CER.T.	G.S.F.T.	—	—	G.S.F.T.	FUR. ACOUS.	SEE DETAIL SH.Nº 15 WATERPROOF FLOOR
TOILET ROOMS (PATIENT)	422, 435, 444	CER.T.	G.S.F.T.	—	—	G.S.F.T.	FUR. K.C.	SEE DETAIL SH.Nº 15 WATERPROOF FLOOR.
BATH ROOMS	423, 436, 445	ABR.T.	G.S.F.T.	—	—	G.S.F.T.	FUR. K.C.	SEE DETAIL SH.Nº 15 WATERPROOF FLOOR.
LINEN	424	TER.	G.S.F.T.	—	—	G.S.F.T.	FUR. PL.	SEE DETAIL SH.Nº 15
LITTERS	426	TER.	G.S.F.T.	—	—	G.S.F.T.	FUR. PL.	
UTILITY ROOM	438	CER.T.	G.S.F.T.	—	—	G.S.F.T.	FUR. ACOUS	SEE DETAIL SH.Nº 15
JANITOR	439	TER.	G.S.F.T.	—	—	G.S.F.T.	FUR. PL.	SEE DETAIL SH.Nº 15
DAY ROOM AND OCCUPATIONAL THERAPY	440	TER.	G.S.F.T.	—	—	G.S.F.T.	FUR. PL.	
EXAM. ROOM	441	TER.	G.S.F.T.	—	—	G.S.F.T.	FUR. PL.	HANGING CABINET
DOCTOR'S ROOM	442	TER.	G.S.F.T.	—	—	G.S.F.T.	FUR. PL.	
STAIRS	NOS. 1 - 2 - 5	SO.	G.S.F.T. NO-CONC.	—	—	G.S.F.T.	EXP. CONC.	FUR. PL. - STAIR Nº 2 SEE DETAIL SH. Nº 16
WIRE CLOSET		C.E.M.	UNFINISHED PAINT WALLS, TRIM & CONDUITS.				EXP. CONC.	

ALL INTERIOR SILLS TO BE SOAPSTONE UNLESS OTHERWISE NOTED
ALL BATH RM. PIPE SPACES TO HAVE CEMENT FL. RAISED 5" ABOVE FIN. FL.
RADIATOR RECESSES ARE DESIGNATED BY DOTTED LINE THUS

GENERAL NOTES

SEE SHEET Nº 1 FOR ABBREVIATIONS AND MATERIAL INDICATIONS
ALL PIERS 2'-1" OR LESS IN WIDTH BETWEEN OPENINGS TO BE SOLID BRICK
SEE DETAIL AT COLUMN D-13 ON SHEET Nº 3 FOR SOLID BRICK
REINFORCED TILE OR STEEL ANGLE LINTELS OVER ALL DUCT & GRILLE OPENINGS IN PARTITIONS
SEE SHEET Nº 2 FOR COMPLETE DIMENSIONS
LOCATION OF ALL BEDS TO BE AS DIRECTED

HARDWARE FOR EXTERIOR DOORS
DOOR Nº 768 - 775 - 778 HAVE HARDWARE TYPE Nº 1

#8283
STATE ART COMMISSION
APR 3 1947
RECEIVED

STATE ART COMMISSION
4-3-47

APPROVED
Commonwealth of Pennsylvania
Department of Labor & Industry
Bureau of Inspection
Buildings Section
Checked By
Approved By
Approval Date
Chief

◊ REVISED AS CONSTRUCTED
1-16-1950

REVISED

APPROVED C.M. Wolfworth SECRETARY OF PROPERTY & SUPPLIES
APPROVED CHIEF CONSTRUCTION ENGINEER OF PROPERTY & SUPPLIES
APPROVED
SUBMITTED ARCHITECT
ACCEPTED CONTRACTOR

APPROVED
Commonwealth of Pennsylvania
DEPARTMENT OF PUBLIC WELFARE
Architect
Bureau

4-3-47

FOURTH FLOOR PLAN

ACTIVE THERAPY BUILDING Nº 3
FOR THE
PHILADELPHIA STATE HOSPITAL
PHILADELPHIA PENNSYLVANIA
GEORGE W. PEPPER, JR., REGISTERED ARCHITECT
225 SOUTH 15TH STREET PHILADELPHIA, PA.

DATE	COMMONWEALTH OF PENNA.	SHEET NO.
4-1-47	JAMES H. DUFF GOVERNOR	5
SCALE 1/8"=1'-0"	DEPT. PROPERTY & SUPPLIES C. M. WOOLWORTH SECRETARY HARRISBURG, PENNSYLVANIA	

3-6-3