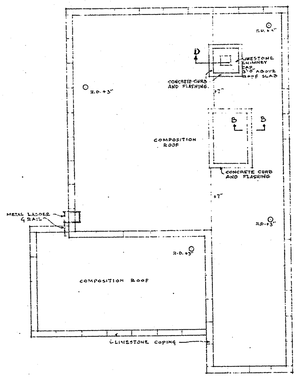

PENTHOUSE ROOF PLAN
LABORATORY WING

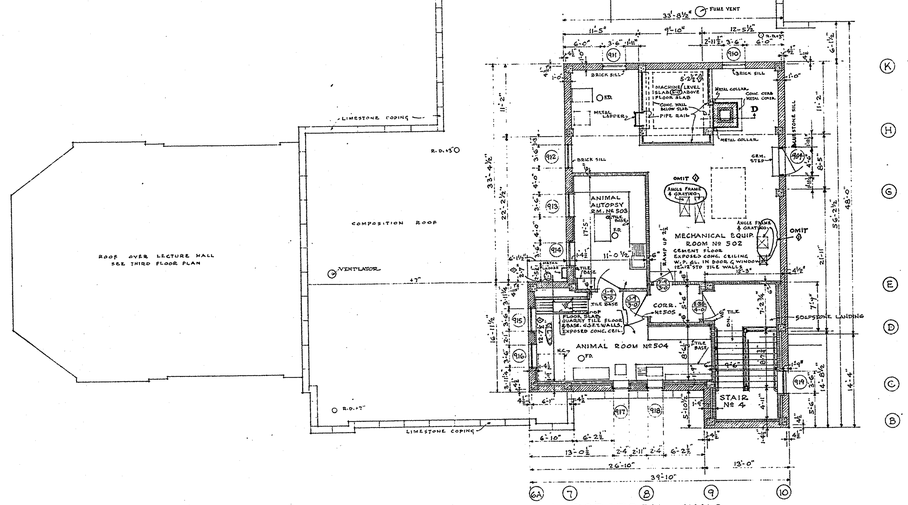

LABORATORY WING

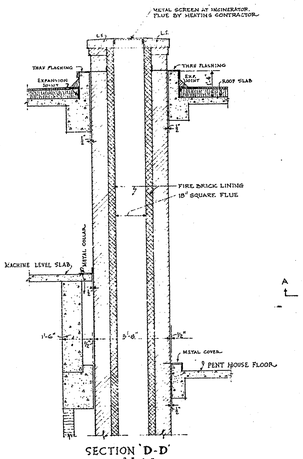

SECTION 'D-D'
SCALE 3/8" = 1'-0"

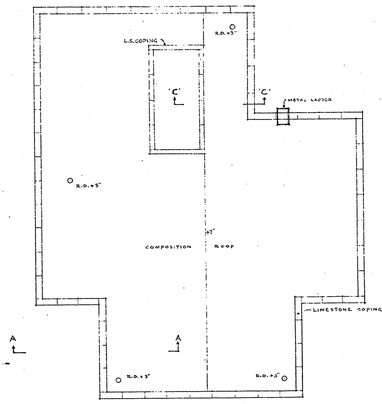

PENTHOUSE ROOF PLAN
THERAPY WING

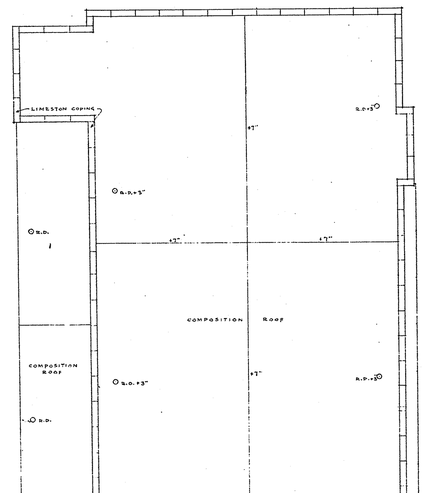

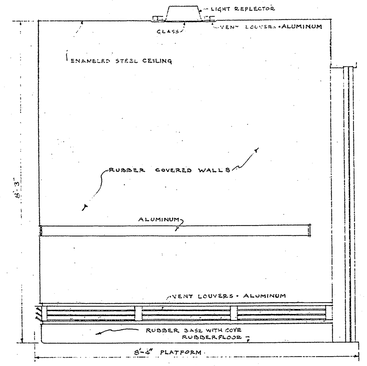

ELEVATION OF SIDE

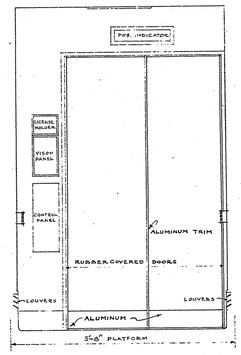

ELEV. OF FRONT

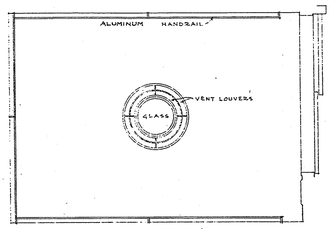

REFLECTED CEILING PLAN

PASSENGER
ELEVATOR CAB DETAILS
SCALE 3/4" = 1'-0"
NOTE: ALL ALUMINUM TO BE SATIN FINISH

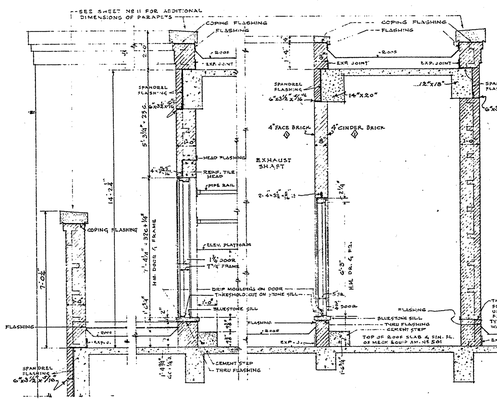

SECTION 'A-A'
SCALE 3/8" = 1'-0"

SECTION 'C-C'
SCALE 3/8" = 1'-0"

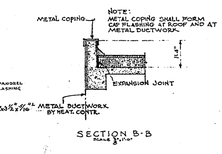

SECTION B-B
SCALE 3/8" = 1'-0"

NOTE:
METAL COPING SHALL FORM CAP FLASHING AT ROOF AND AT METAL DUCTWORK.

GENERAL NOTES
SEE SHEET No 1 FOR ABBREVIATIONS AND MATERIAL INDICATIONS
⊠ INDICATES OPENINGS IN FLOOR SLAB FOR VENT DUCTS LOCATED BY VENTILATING CONTRACTOR.

HARDWARE FOR EXTERIOR DOORS
DOOR NOS 401-405-406-409 HAVE HARDWARE TYPE No 17

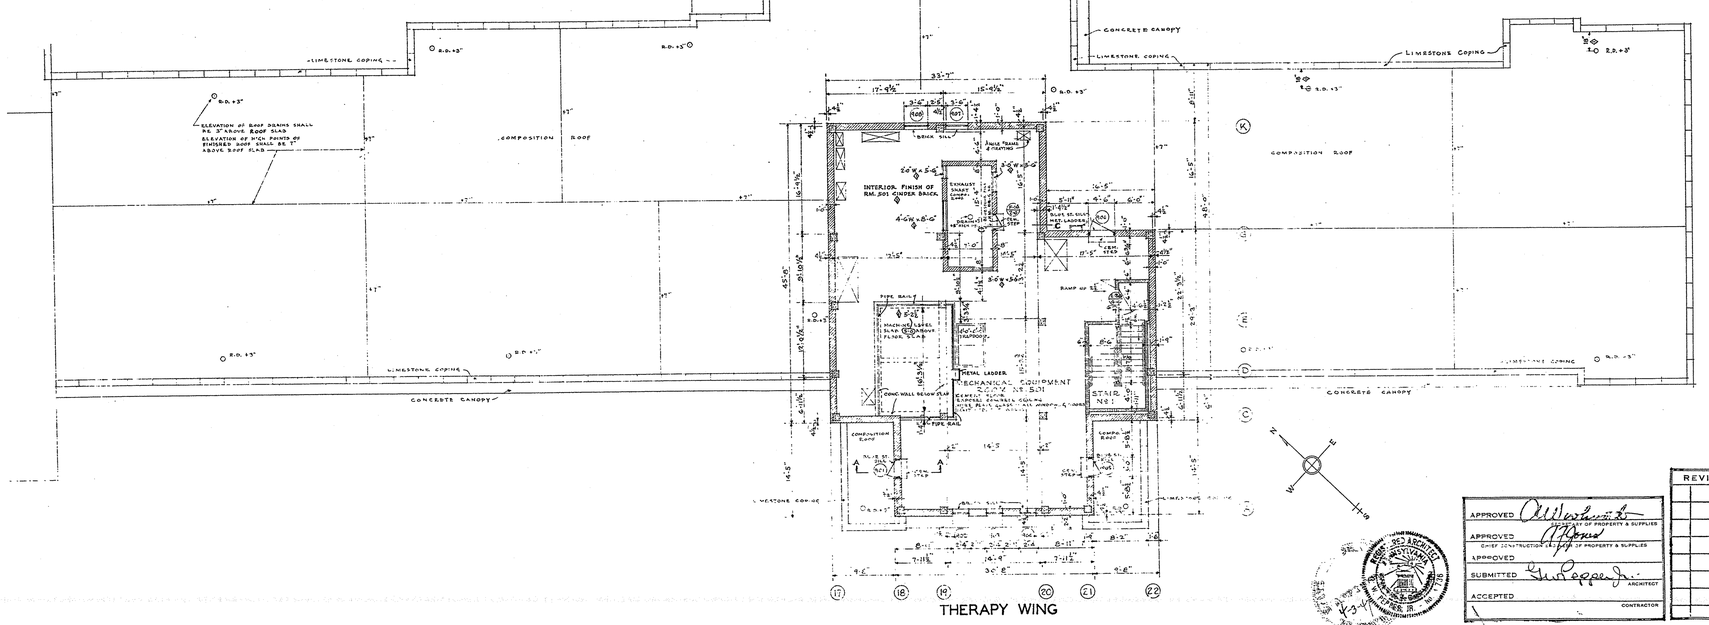

THERAPY WING

#48283
STATE ART COMMISSION
APR 3 1947
RECEIVED

STATE ARC
4-3-47

◊ REVISED AS CONSTRUCTED
1-16-50

APPROVED
Commonwealth of Pennsylvania
DEPARTMENT OF WELFARE
BUREAU OF INSTITUTIONAL MANAGEMENT.
Architect [signature] Date 4-28-47
Secretary [signature] Date 5-22-47

APPROVED
Commonwealth of Pennsylvania
Department of Labor & Industry
Bureau of Inspection
Buildings Section
Checked By
Approved By — Chief
Approval Date

APPROVED	[signature] CHIEF CONSTRUCTION ENGINEER OF PROPERTY & SUPPLIES
APPROVED	
SUBMITTED	[signature] ARCHITECT
ACCEPTED	CONTRACTOR

REVISED

PENTHOUSE & ROOF PLANS

ACTIVE THERAPY BUILDING N 3
FOR THE
PHILADELPHIA STATE HOSPITAL
PHILADELPHIA PENNSYLVANIA
GEORGE W. PEPPER JR. REGISTERED ARCHITECT
225 S. 15 TH. STREET PHILADELPHIA PA.

DATE		SHEET NO.
4-1-47	COMMONWEALTH OF PENNA. JAMES H. DUFF GOVERNOR DEPT. PROPERTY & SUPPLIES C. M. WOOLWORTH SECRETARY HARRISBURG, PENNSYLVANIA	6
SCALE 3/8" = 1'-0"		

3-6-3