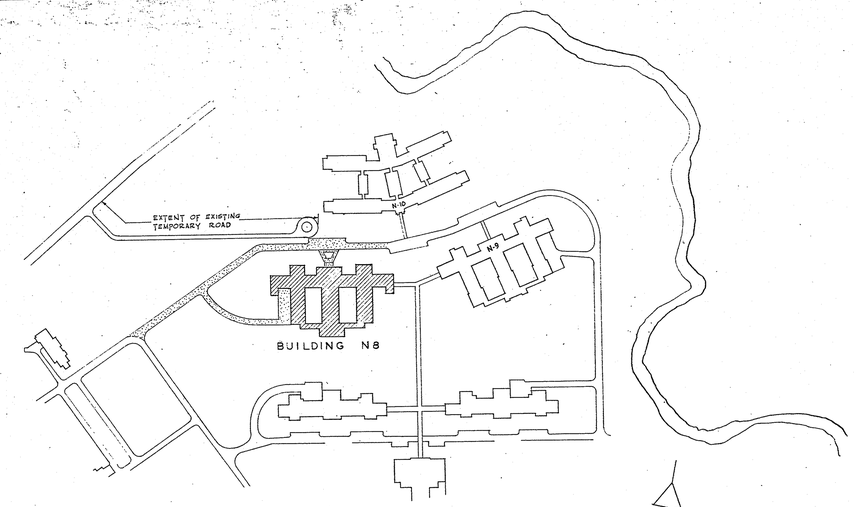

LOCATION PLAN

SCALE: 1" = 200'

GUTTER DETAIL

SCALE: 3/4" = 1'-0"

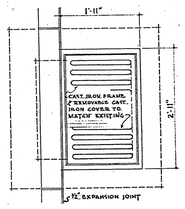

PLAN

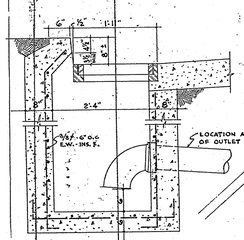

SECTION

DETAIL OF CURB DRAINS

SCALE: 3/4" = 1'-0"

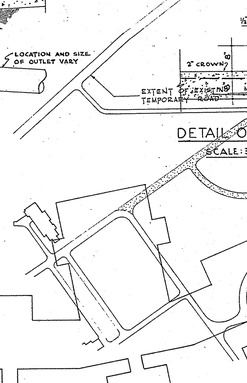

LOCATION PLAN

SCALE: 1" = 200'

DETAIL OF CURB

SCALE: 3/4" = 1'-0"

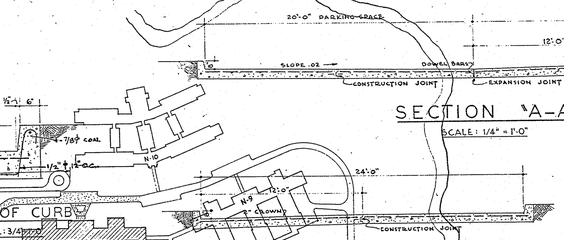

SECTION "A-A"

SCALE: 1/4" = 1'-0"

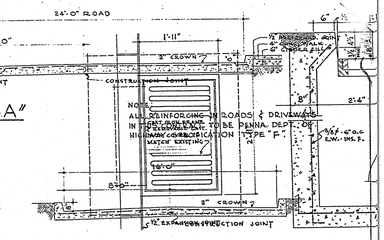

SECTION

DETAIL OF CURB DRAIN

SCALE: 3/4" = 1'-0"

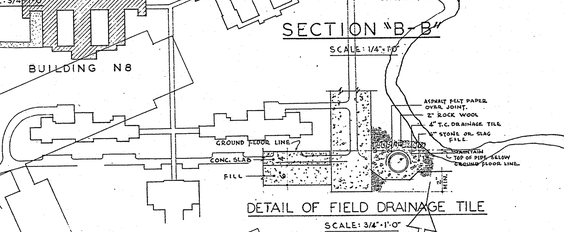

SECTION "B-B"

SCALE: 1/4" = 1'-0"

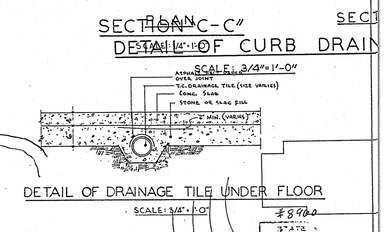

SECTION "C-C"

SCALE: 1/4" = 1'-0"

DETAIL OF DRAINAGE TILE UNDER FLOOR

SCALE: 3/4" = 1'-0"

DETAIL OF FIELD DRAINAGE TILE

SCALE: 3/4" = 1'-0"

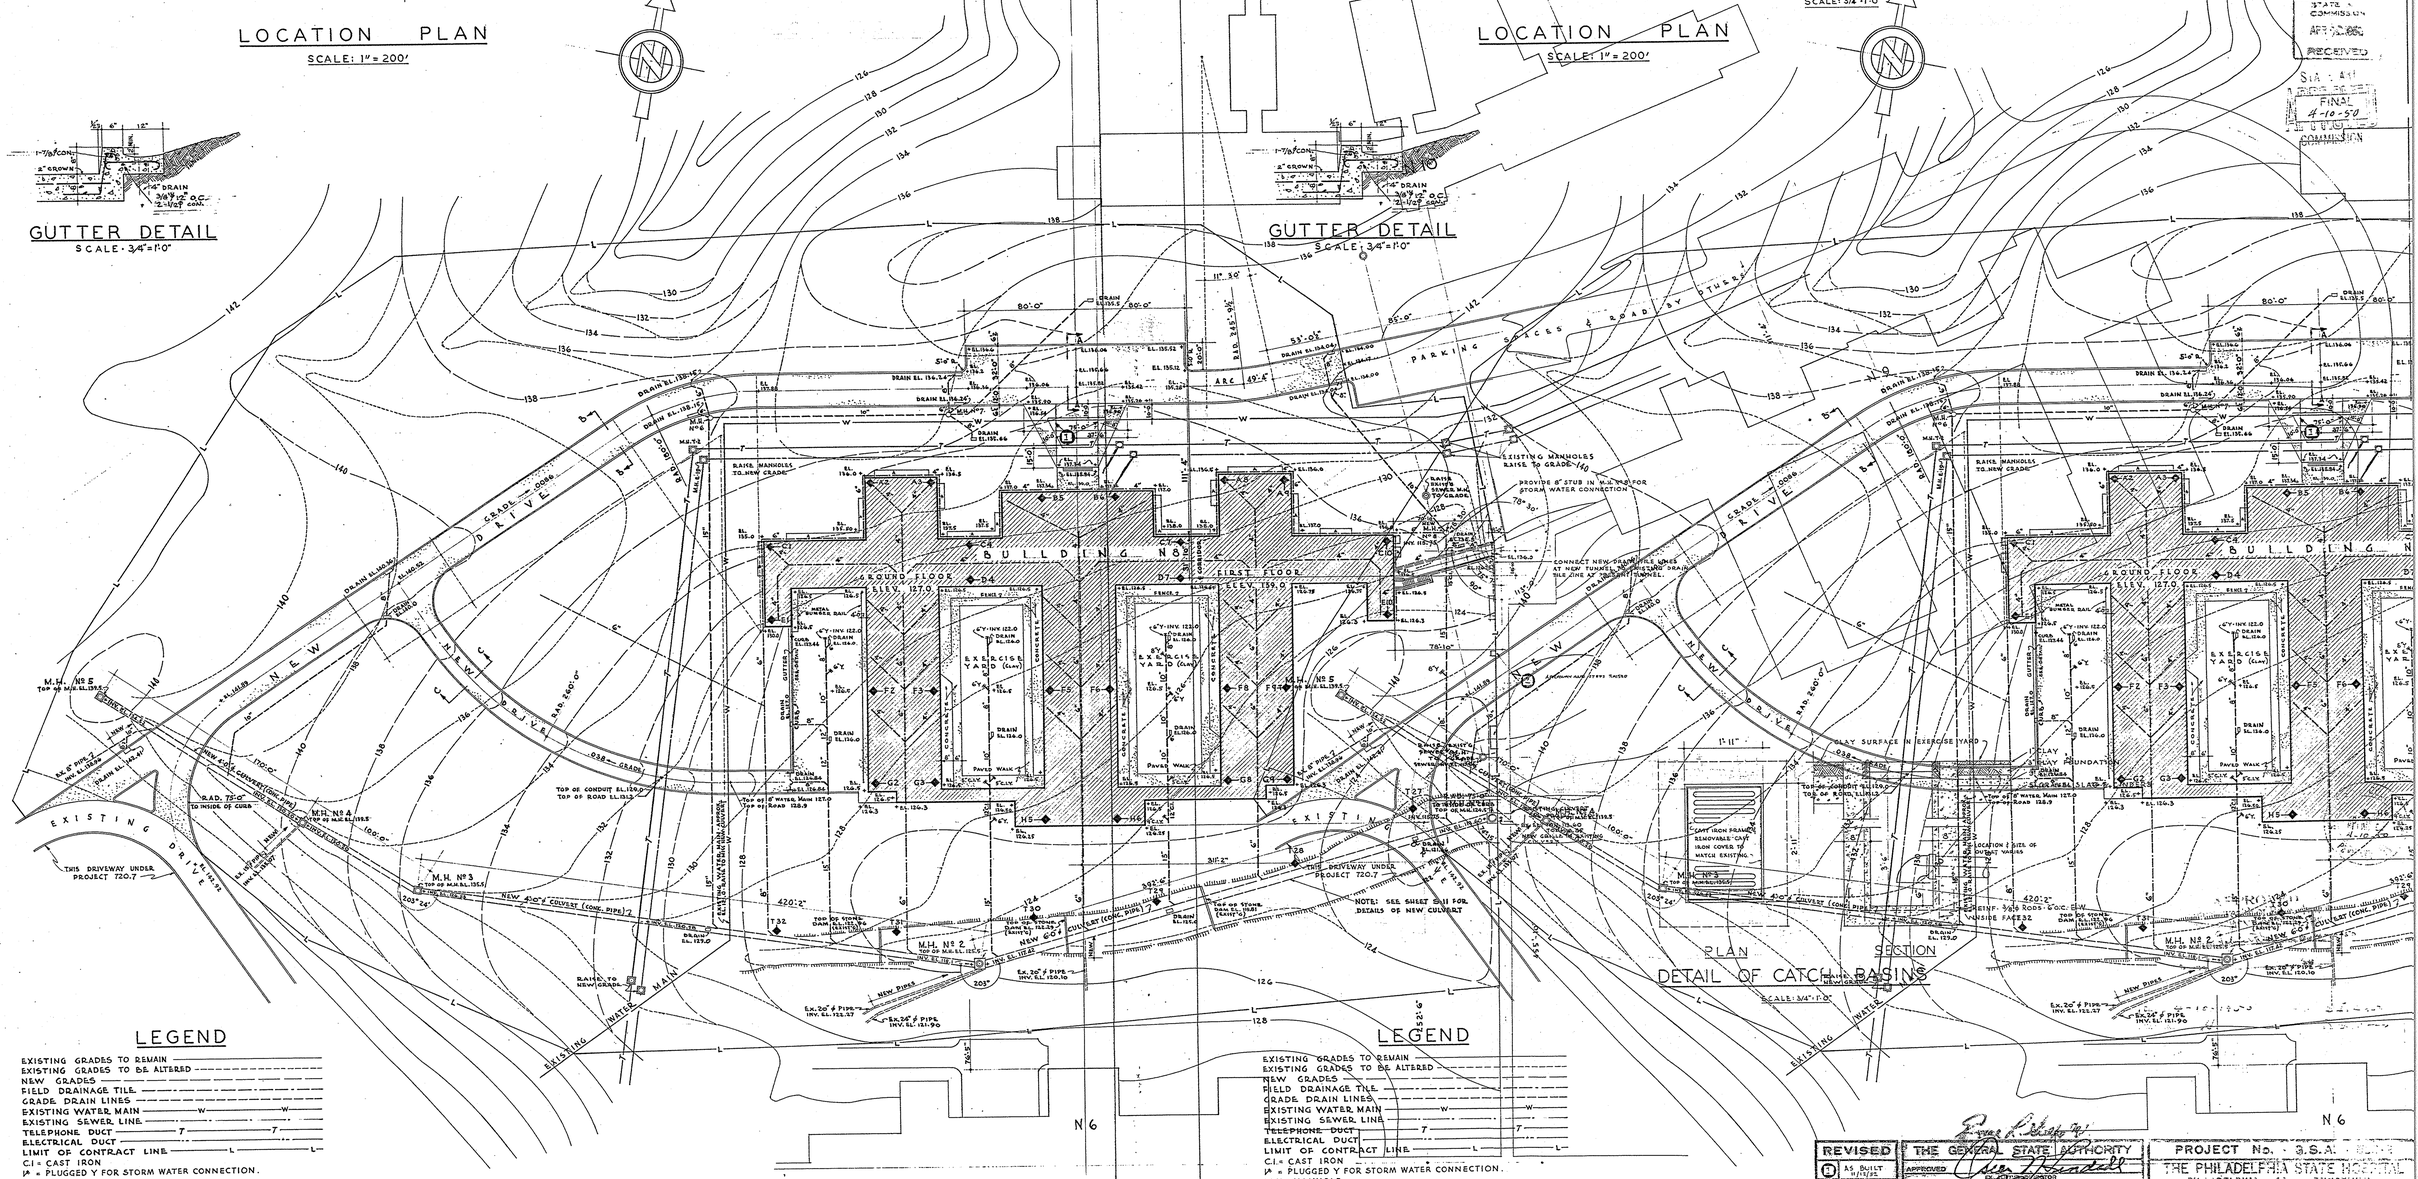

PLOT PLAN

SCALE: 1" = 40'

PLAN

SECTION

DETAIL OF CATCH BASINS

SCALE: 3/4" = 1'-0"

LEGEND

EXISTING GRADES TO REMAIN
EXISTING GRADES TO BE ALTERED
NEW GRADES
FIELD DRAINAGE TILE
GRADE DRAIN LINES
EXISTING WATER MAIN — W — W —
EXISTING SEWER LINE
TELEPHONE DUCT — T — T —
ELECTRICAL DUCT
LIMIT OF CONTRACT LINE — L — L —

C.I. = CAST IRON
ϕ = PLUGGED Y FOR STORM WATER CONNECTION.
M.H. = MANHOLE
INV. = INVERT ELEVATION
◆-C1 = INDICATES TEST BORING LOCATION

NOTE:
ALL DRAINS AND CHANGES IN GRADE CONTOURS SHOWN TO BE INCLUDED IN THIS CONTRACT.
Y FOR STORM WATER CONNECTIONS (UNDER SEPARATE CONTRACT) SHALL BE PROVIDED WHERE SHOWN. ϕ
ALL DRAINAGE LINES UNDER BUILDING SHALL BE CAST IRON AND SHALL EXTEND 10'-0" FROM WALL OF BUILDING.
ALL LINES AND Y CONNECTIONS SHALL BE VITRIFIED TILE UNLESS OTHERWISE NOTED.
FOR DETAILS OF MANHOLES & DRAINS IN CULVERT SEE DRG. S-11

ALL DIMENSIONS AND EXISTING CONDITIONS SHALL BE CHECKED AND VERIFIED BY THE CONTRACTOR AT THE SITE.

LEGEND

EXISTING GRADES TO REMAIN
EXISTING GRADES TO BE ALTERED
NEW GRADES
FIELD DRAINAGE TILE
GRADE DRAIN LINES
EXISTING WATER MAIN — W — W —
EXISTING SEWER LINE
TELEPHONE DUCT — T — T —
ELECTRICAL DUCT
LIMIT OF CONTRACT LINE — L — L —

C.I. = CAST IRON
ϕ = PLUGGED Y FOR STORM WATER CONNECTION.
M.H. = MANHOLE
INV. = INVERT ELEVATION
◆-C1 = INDICATES TEST BORING LOCATION

NOTE:
ALL DRAINS AND CHANGES IN GRADE CONTOURS SHOWN TO BE INCLUDED IN THIS CONTRACT.
Y FOR STORM WATER CONNECTIONS (UNDER SEPARATE CONTRACT) SHALL BE PROVIDED WHERE SHOWN. ϕ
ALL DRAINAGE LINES UNDER BUILDING SHALL BE CAST IRON AND SHALL EXTEND 10'-0" FROM WALL OF BUILDING.
ALL LINES AND Y CONNECTIONS SHALL BE VITRIFIED TILE UNLESS OTHERWISE NOTED.
FOR DETAILS OF MANHOLES & DRAINS IN CULVERT SEE DRG. S-11

ALL DIMENSIONS AND EXISTING CONDITIONS SHALL BE CHECKED AND VERIFIED BY THE CONTRACTOR AT THE SITE.

REVISED	
1	AS BUILT
2	"

THE GENERAL STATE AUTHORITY

APPROVED
APPROVED
APPROVED
APPROVED
APPROVED
APPROVED
ACCEPTED
ACCEPTED
ACCEPTED

PROJECT No. G.S.A.

THE PHILADELPHIA STATE HOSPITAL
PHILADELPHIA 33 PENNSYLVANIA

BUILDING N-8

PLOT PLAN & DETAILS

STORMER & LIGHTY ARCHITECTS 2133 SPRUCE ST. PHILA. 103 PENN. P 1317

19.19 PROGRAM
DATE 4-10-50
SCALE AS NOTED

SCALE: 1" = 40'

JAMES N. DUNN PRESIDENT
PROJECT DIRECTOR

A1