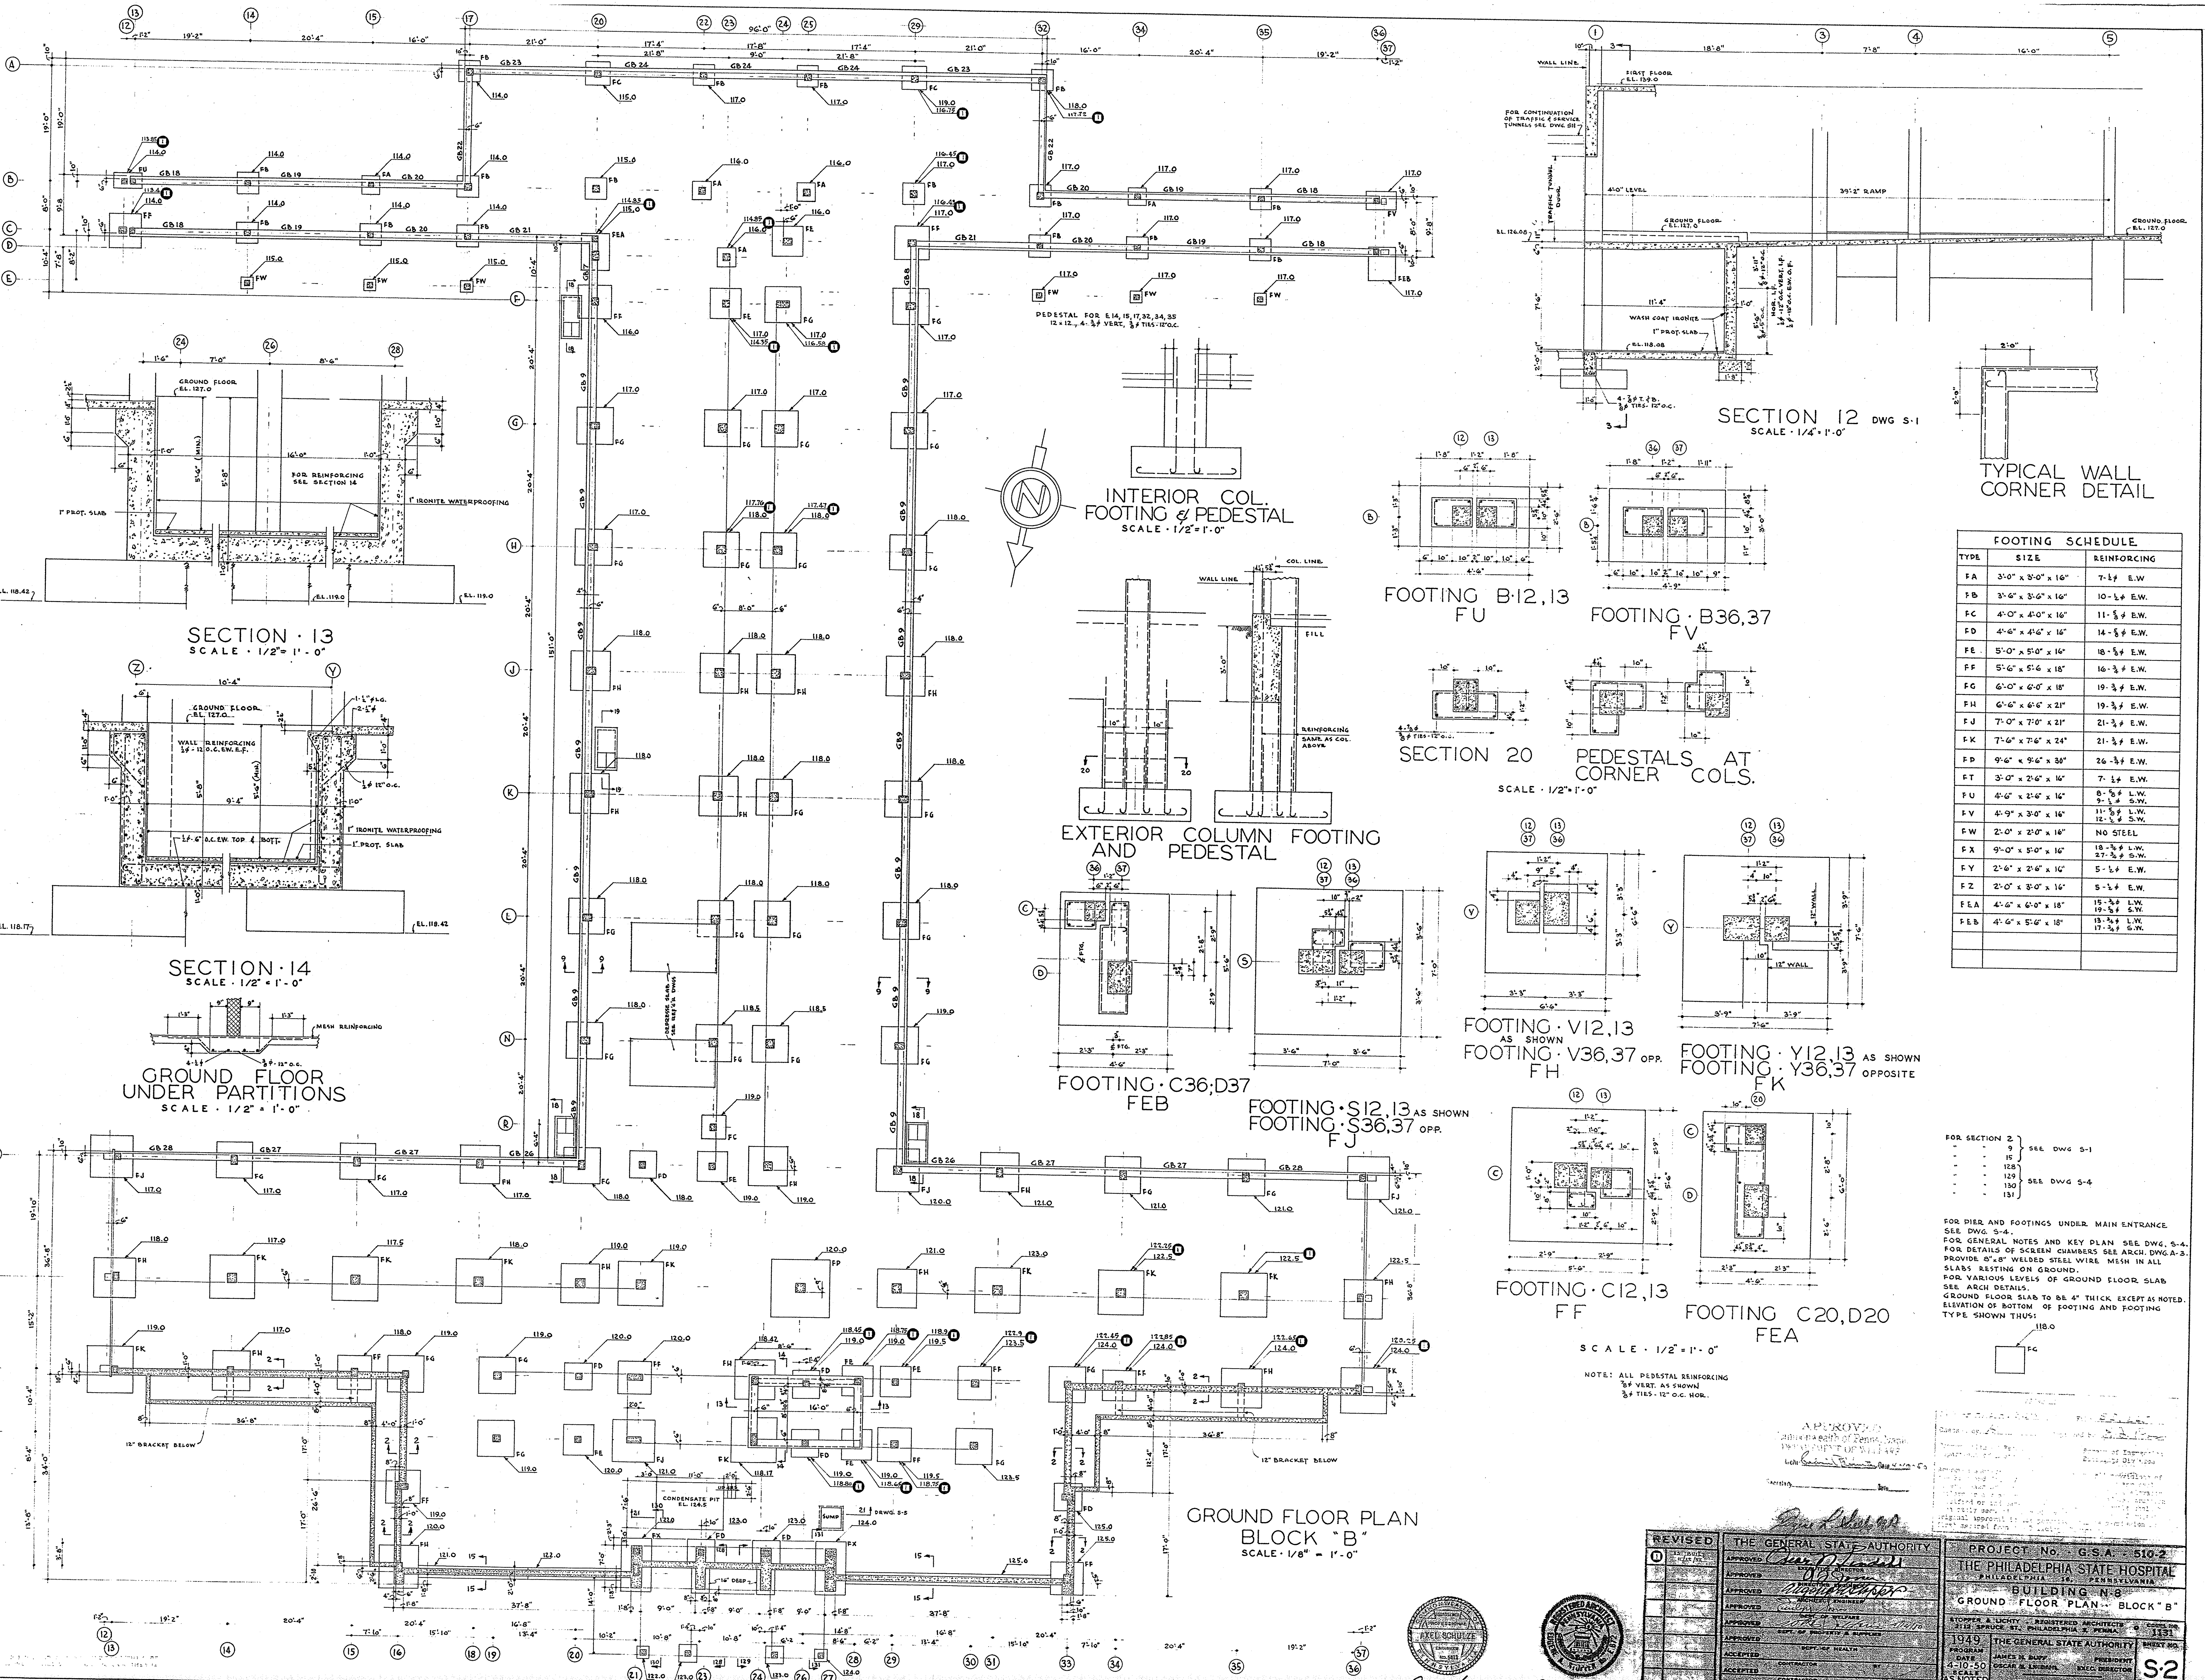
GB 23
GB 24
GB 22
GB 21
GB 20
GB 19
GB 18
GB 9
GB 8
GB 7
GB 26
GB 27
GB 28
FA
FB
FC
FD
FE
FF
FG
FH
FJ
FK
FP
FU
FV
FW
FX
FEA
FEB
PEDESTAL FOR E 14, 15, 17, 32, 34, 35 12 x 12, 4-¾ϕ VERT., ⅜ϕ TIES-12" O.C.
GROUND FLOOR EL. 127.0
FOR REINFORCING SEE SECTION 14
1" IRONITE WATERPROOFING
1" PROT. SLAB
EL. 118.42
EL. 119.0
WALL REINFORCING ½ϕ - 12 O.C. EW. E.F.
½ϕ 12" O.C.
½ϕ - 6" O.C. EW. TOP & BOTT.
EL. 118.17
MESH REINFORCING
4-½ϕ
⅜ϕ - 12" O.C.
COL. LINE
WALL LINE
FILL
REINFORCING SAME AS COL. ABOVE
FIRST FLOOR EL. 139.0
FOR CONTINUATION OF TRAFFIC & SERVICE TUNNELS SEE DWG. S11
TRAFFIC TUNNEL DOOR
4'-0" LEVEL
39'-2" RAMP
EL. 126.08
WASH COAT IRONITE
EL. 118.08
4-⅞ϕ T. & B. ⅜ϕ TIES- 12" O.C.
12" WALL
12" BRACKET BELOW
DEPRESSE SLAB SEE REF'G'R DWGS
CONDENSATE PIT EL. 124.5
SUMP
21 DWG. S-5
16" DEEP
UP 4 RS

## SECTION · 13
SCALE · 1/2" = 1' - 0"

## SECTION · 14
SCALE · 1/2" = 1' - 0"

## GROUND FLOOR UNDER PARTITIONS
SCALE · 1/2" = 1' - 0"

## INTERIOR COL. FOOTING & PEDESTAL
SCALE · 1/2" = 1' - 0"

## EXTERIOR COLUMN FOOTING AND PEDESTAL

FOOTING · C36; D37
FEB

FOOTING · S12,13 AS SHOWN
FOOTING · S36,37 OPP.
FJ

## SECTION 12 DWG S-1
SCALE · 1/4" = 1' - 0"

## TYPICAL WALL CORNER DETAIL

FOOTING B·12,13
FU

FOOTING · B36,37
FV

SECTION 20

PEDESTALS AT CORNER COLS.

SCALE · 1/2" = 1' - 0"

FOOTING · V12,13
AS SHOWN
FOOTING · V36,37 OPP.
FH

FOOTING · Y12,13 AS SHOWN
FOOTING · Y36,37 OPPOSITE
FK

FOOTING · C12,13
FF

FOOTING C20, D20
FEA

SCALE · 1/2" = 1' - 0"

NOTE: ALL PEDESTAL REINFORCING ⅞ϕ VERT. AS SHOWN ⅜ϕ TIES - 12" O.C. HOR.

## GROUND FLOOR PLAN BLOCK "B"
SCALE · 1/8" = 1' - 0"

## FOOTING SCHEDULE

| TYPE | SIZE | REINFORCING |
|---|---|---|
| FA | 3'-0" x 3'-0" x 16" | 7-½ϕ E.W. |
| FB | 3'-6" x 3'-6" x 16" | 10-½ϕ E.W. |
| FC | 4'-0" x 4'-0" x 16" | 11-⅝ϕ E.W. |
| FD | 4'-6" x 4'-6" x 16" | 14-⅝ϕ E.W. |
| FE | 5'-0" x 5'-0" x 16" | 18-⅝ϕ E.W. |
| FF | 5'-6" x 5'-6 x 18" | 16-¾ϕ E.W. |
| FG | 6'-0" x 6'-0" x 18" | 19-¾ϕ E.W. |
| FH | 6'-6" x 6'-6" x 21" | 19-¾ϕ E.W. |
| FJ | 7'-0" x 7'-0" x 21" | 21-¾ϕ E.W. |
| FK | 7'-6" x 7'-6" x 24" | 21-¾ϕ E.W. |
| FP | 9'-6" x 9'-6" x 30" | 26-¾ϕ E.W. |
| FT | 3'-0" x 2'-6" x 16" | 7-½ϕ E.W. |
| FU | 4'-6" x 2'-6" x 16" | 8-⅝ϕ L.W.<br>9-½ϕ S.W. |
| FV | 4'-9" x 3'-0" x 16" | 11-⅝ϕ L.W.<br>12-½ϕ S.W. |
| FW | 2'-0" x 2'-0" x 16" | NO STEEL |
| FX | 9'-0" x 5'-0" x 16" | 18-¾ϕ L.W.<br>27-¾ϕ S.W. |
| FY | 2'-6" x 2'-6" x 16" | 5-½ϕ E.W. |
| FZ | 2'-0" x 3'-0" x 16" | 5-½ϕ E.W. |
| FEA | 4'-6" x 6'-0" x 18" | 15-¾ϕ L.W.<br>19-⅝ϕ S.W. |
| FEB | 4'-6" x 5'-6" x 18" | 13-¾ϕ L.W.<br>17-¾ϕ S.W. |
| | | |
| | | |

FOR SECTION 2, 9, 15 SEE DWG S-1
FOR SECTION 128, 129, 130, 131 SEE DWG S-4

FOR PIER AND FOOTINGS UNDER MAIN ENTRANCE SEE DWG. S-4.
FOR GENERAL NOTES AND KEY PLAN SEE DWG. S-4.
FOR DETAILS OF SCREEN CHAMBERS SEE ARCH. DWG. A-3.
PROVIDE 8"x8" WELDED STEEL WIRE MESH IN ALL SLABS RESTING ON GROUND.
FOR VARIOUS LEVELS OF GROUND FLOOR SLAB SEE ARCH DETAILS.
GROUND FLOOR SLAB TO BE 4" THICK EXCEPT AS NOTED.
ELEVATION OF BOTTOM OF FOOTING AND FOOTING TYPE SHOWN THUS:
118.0
FG

APPROVED
Commonwealth of Pennsylvania
DEPARTMENT OF WELFARE
Arch. Date 4-10-50
Secretary ________ Date ________

AXEL SCHULZE
No. 5413

Axel Schulze

Eugene A. Stopper

| REVISED | THE GENERAL STATE AUTHORITY | PROJECT No. G.S.A. - 510-2 |
|---|---|---|
| ① AS BUILT 11/12/52 | APPROVED — EXECUTIVE DIRECTOR | THE PHILADELPHIA STATE HOSPITAL<br>PHILADELPHIA 14, PENNSYLVANIA |
| | APPROVED — DIRECTOR OF DESIGN | BUILDING N-8<br>GROUND FLOOR PLAN - BLOCK "B" |
| | APPROVED — ARCHITECT ENGINEER | STOPPER & LICHTY - REGISTERED ARCHITECTS<br>2112 SPRUCE ST. PHILADELPHIA 3, PENNA. — COMM. NO. 1131 |
| | APPROVED — DEPT. OF WELFARE | 1949 PROGRAM — THE GENERAL STATE AUTHORITY — SHEET NO. |
| | APPROVED — DEPT. OF PROPERTY & SUPPLIES | DATE 4-10-50 — JAMES N. BUFF PRESIDENT — S-2 |
| | APPROVED — DEPT. OF HEALTH | SCALE AS NOTED — OSCAR N. LINDSAY EXEC. DIRECTOR |
| | ACCEPTED — CONTRACTOR — BY | HARRISBURG, PENNSYLVANIA |
| | ACCEPTED — CONTRACTOR — BY | CHECKED FOR G.S.A. |
| | ACCEPTED — CONTRACTOR — BY | SUPV. ARCH. — ARCH. — STRUCT. — MECH. — ELECT. |