8960

STATE ART COMMISSION
APR 10 1950
RECEIVED

STATE ART APPROVED COMMISSION
FINAL 4-10-50

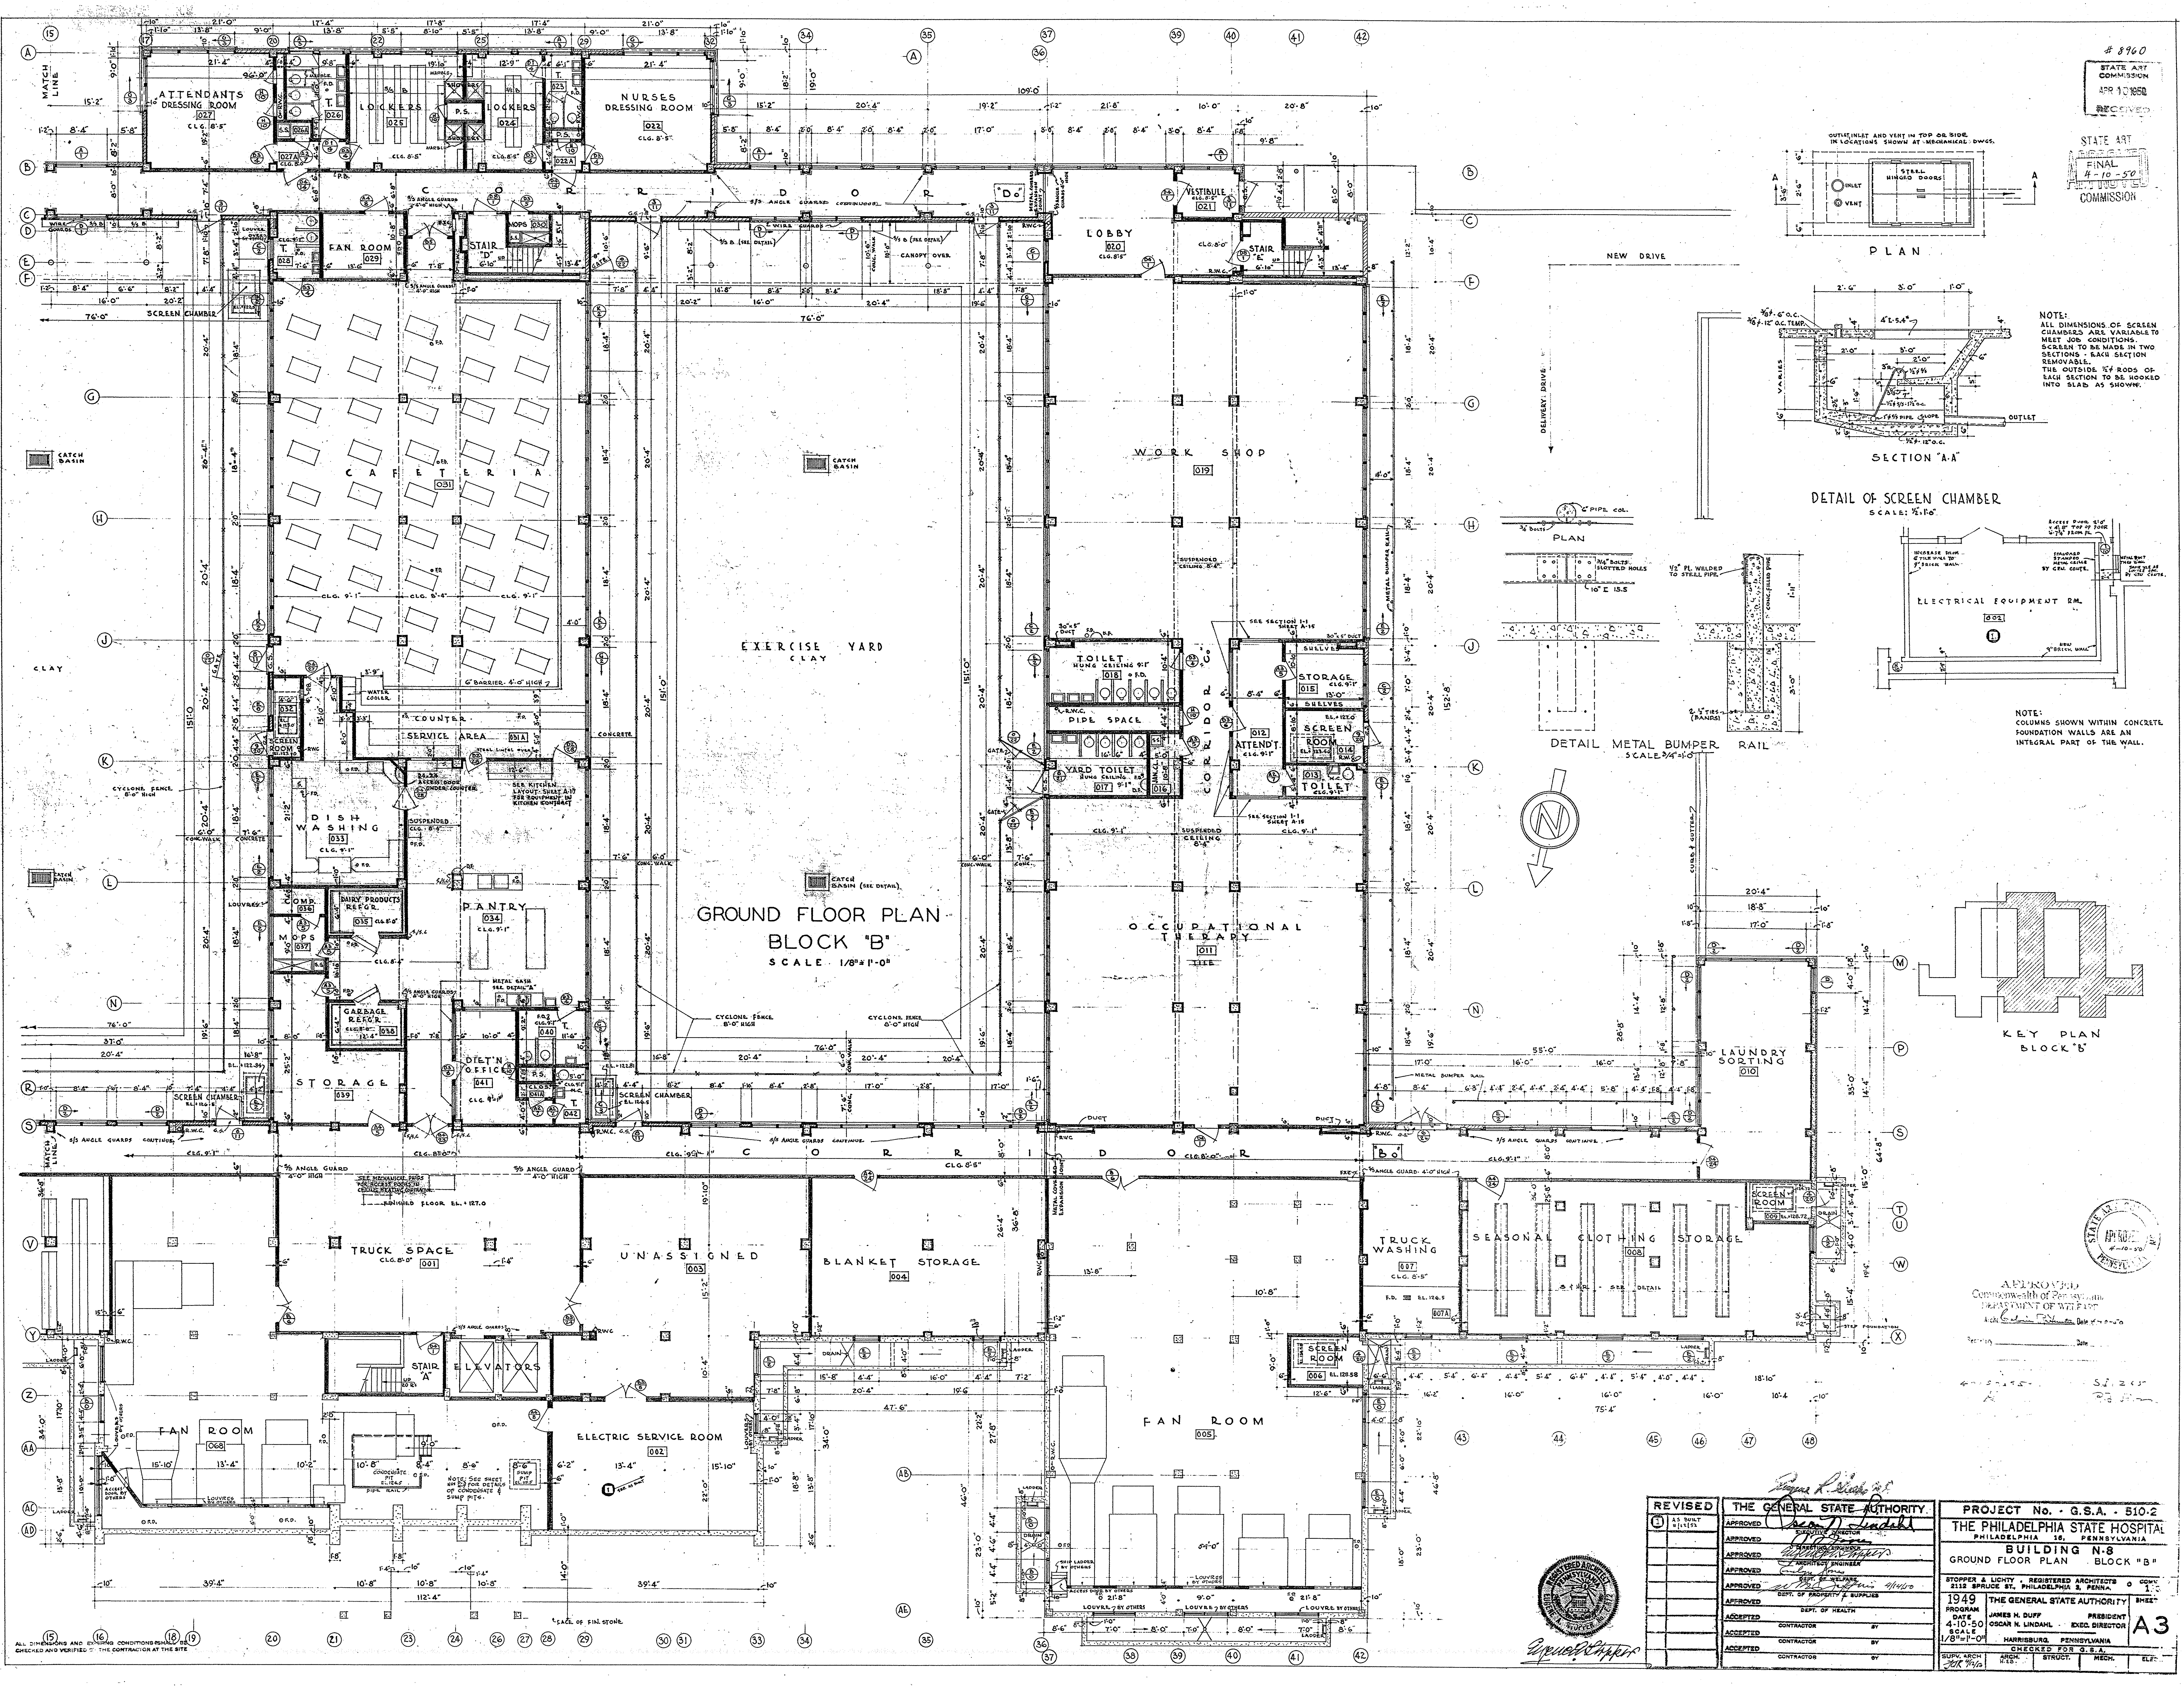
ATTENDANTS DRESSING ROOM 027 CLG. 8'-5"
LOCKERS 025
T. 026
S.S. 026A
027A CLG. 8'-0"
SHOWERS
P.S.
LOCKERS 024
T. 023
NURSES DRESSING ROOM 022 CLG. 8'-5"
022A
MATCH LINE
C O R R I D O R
"Do"
T. 028
FAN ROOM 029
STAIR "D"
MOPS 030
LOBBY 020 CLG. 8'-5"
VESTIBULE 021 CLG. 8'-5"
STAIR "E"
CANOPY OVER
SCREEN CHAMBER
CAFETERIA 031
6" BARRIER 4'-0" HIGH
WATER COOLER
COUNTER
SERVICE AREA 031A
SCREEN ROOM
032
SEE KITCHEN LAYOUT - SHEET A-17 FOR EQUIPMENT IN KITCHEN CONTRACT
24x24 ACCESS DOOR UNDER COUNTER
DISH WASHING 033 CLG. 9'-1"
COMP. 036
DAIRY PRODUCTS REFG'R. 035 CLG. 8'-0"
MOPS 037
PANTRY 034 CLG. 9'-1"
GARBAGE REFG'R. 038
METAL SASH SEE DETAIL "A"
DIET'N OFFICE 041
T. 040
P.S.
CLOS. 041A
T. 042
STORAGE 039
CATCH BASIN
CLAY
CYCLONE FENCE 8'-0" HIGH
EXERCISE YARD CLAY
CATCH BASIN (SEE DETAIL)
WORK SHOP 019
SUSPENDED CEILING 8'-4"
TOILET HUNG CEILING 9'-1" 018
PIPE SPACE
YARD TOILET HUNG CEILING 9'-1" 017
JAN. CL. 016
CORRIDOR
ATTEND'T. 012 CLG. 9'-1"
STORAGE 015 CLG. 9'-1"
SHELVES
SCREEN ROOM 014
TOILET 013 CLG. 9'-1"
SEE SECTION 1-1 SHEET A-15
METAL BUMPER RAIL
OCCUPATIONAL THERAPY 011 TILE
NEW DRIVE
DELIVERY DRIVE
CURB & GUTTER
LAUNDRY SORTING 010
S/S ANGLE GUARDS CONTINUE
"Bo"
SEE MECHANICAL DWGS FOR ACCESS DOORS IN CEILING HEATING CONTRACTOR
FINISHED FLOOR EL. +127.0
TRUCK SPACE CLG. 8'-0" 001
UNASSIGNED 003
BLANKET STORAGE 004
TRUCK WASHING 007 CLG. 8'-5"
007A
SEASONAL CLOTHING STORAGE 008
SCREEN ROOM 009
STAIR "A"
ELEVATORS
FAN ROOM 068
ELECTRIC SERVICE ROOM 002
CONDENSATE PIT
NOTE: SEE SHEET FOR DETAILS OF CONDENSATE & SUMP PITS.
SUMP PIT
FAN ROOM 005
SCREEN ROOM 006
LOUVRES BY OTHERS
SHIP LADDER BY OTHERS
FACE OF FIN. STONE
N
OUTLET, INLET AND VENT IN TOP OR SIDE IN LOCATIONS SHOWN AT MECHANICAL DWGS.
STEEL HINGED DOORS
INLET
VENT
PLAN
SECTION "A-A"
OUTLET
VARIES
6" PIPE COL.
3/4" BOLTS SLOTTED HOLES
10" [15.5
1/2" PL. WELDED TO STEEL PIPE
CONC. FILLED PIPE
2-1/2" TIES (BANDS)
INCREASE FROM 6" TILE WALL TO 9" BRICK WALL
ACCESS DOOR 2'-0" x 4'-8" TOP OF DOOR 6'-7 3/4" FROM FL.
STANDARD STAMPED METAL GRILLE BY GEN. CONTR.
ELECTRICAL EQUIPMENT RM. 002
NEW 9" BRICK WALL
KEY PLAN BLOCK "B"

GROUND FLOOR PLAN
BLOCK "B"
SCALE 1/8" = 1'-0"

ALL DIMENSIONS AND EXISTING CONDITIONS SHALL BE CHECKED AND VERIFIED BY THE CONTRACTOR AT THE SITE

DETAIL OF SCREEN CHAMBER
SCALE: 1/2"=1'-0"

NOTE:
ALL DIMENSIONS OF SCREEN CHAMBERS ARE VARIABLE TO MEET JOB CONDITIONS.
SCREEN TO BE MADE IN TWO SECTIONS - EACH SECTION REMOVABLE.
THE OUTSIDE 1/2" ϕ RODS OF EACH SECTION TO BE HOOKED INTO SLAB AS SHOWN.

DETAIL METAL BUMPER RAIL
SCALE 3/4"=1'-0"

NOTE:
COLUMNS SHOWN WITHIN CONCRETE FOUNDATION WALLS ARE AN INTEGRAL PART OF THE WALL.

STATE ART APPROVED 4-10-50 PENNSYLVANIA

APPROVED
Commonwealth of Pennsylvania
DEPARTMENT OF WELFARE
Arch. Calvin R. Hunter Date 4-10-50
Reviewed ______ Date ______

Eugene A. Stopper

Eugene L. Gleako

REVISED	
①	AS BUILT 11/12/52

THE GENERAL STATE AUTHORITY	
APPROVED	Oscar N. Lindahl EXECUTIVE DIRECTOR
APPROVED	DIRECTING ENGINEER
APPROVED	Eugene A. Stopper ARCHITECT ENGINEER
APPROVED	Evelyn Jones DEPT. OF WELFARE
APPROVED	4/14/50 DEPT. OF PROPERTY & SUPPLIES
APPROVED	DEPT. OF HEALTH
ACCEPTED	CONTRACTOR BY
ACCEPTED	CONTRACTOR BY
ACCEPTED	CONTRACTOR BY

PROJECT No. - G.S.A. - 510-2
THE PHILADELPHIA STATE HOSPITAL
PHILADELPHIA 16, PENNSYLVANIA
BUILDING N-8
GROUND FLOOR PLAN BLOCK "B"
STOPPER & LICHTY - REGISTERED ARCHITECTS
2112 SPRUCE ST., PHILADELPHIA 3, PENNA.
1949 PROGRAM
DATE 4-10-50
SCALE 1/8"=1'-0"
THE GENERAL STATE AUTHORITY
JAMES H. DUFF PRESIDENT
OSCAR N. LINDAHL EXEC. DIRECTOR
HARRISBURG, PENNSYLVANIA
SHEET A3
CHECKED FOR G.S.A.
SUPV. ARCH JAR 4/12/50 | ARCH. H.E.S. | STRUCT. | MECH. | ELEC.