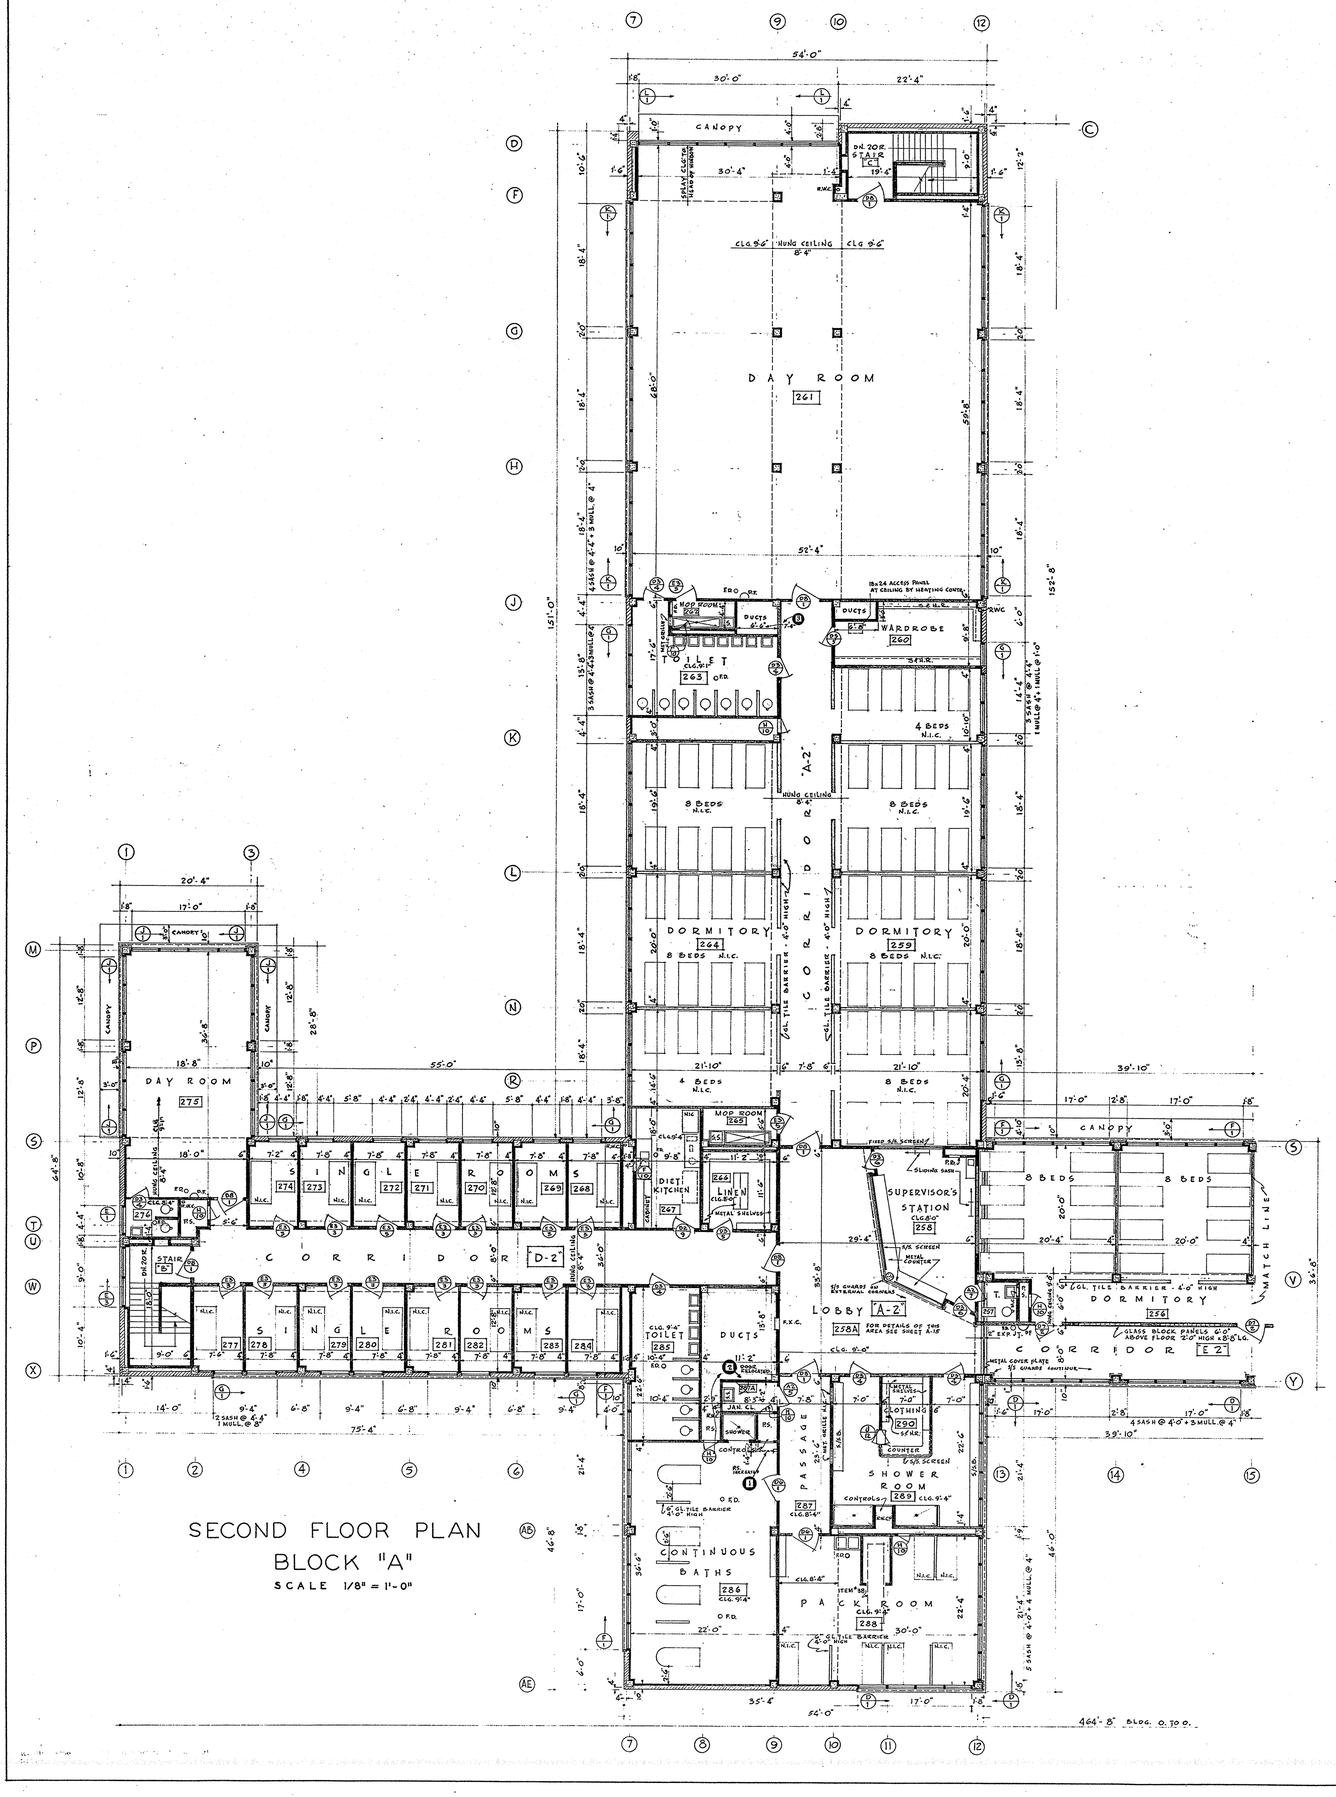

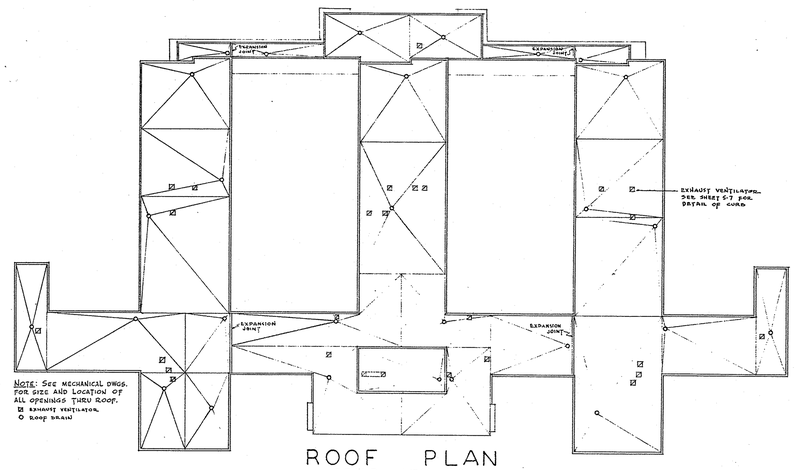

NOTE: SEE MECHANICAL DWGS. FOR SIZE AND LOCATION OF ALL OPENINGS THRU ROOF.
⊠ EXHAUST VENTILATOR.
○ ROOF DRAIN

ROOF PLAN
SCALE — 1/32" = 1'-0"

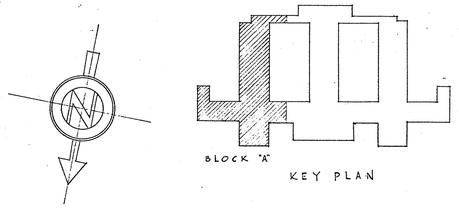

KEY PLAN

SECOND FLOOR BLOCKS · A & D

SCHEDULE OF ROOM FINISHES

SPACE NAME	SPACE NUMBER	FLOOR	BORDER	BASE MAT'L	BASE HT.	WAINSCOT MAT'L	WAINSCOT HT.	REMAINDER OF WALL MAT'L	REMAINDER OF WALL FINISH	CEILING HUNG	CEILING MAT'L	BEAMS & GIRDERS	PAINTING TYPE OF FINISH FLOOR	PAINTING TYPE OF FINISH WALLS	PAINTING TYPE OF FINISH CEILING	PAINTING TYPE OF FINISH TRIM
VISITORS LOBBY & BOOTHS	200-202	TER.	Y	TER.	4"	——	——	MAR.	POL.	Y	A.T.	——	W	W	——	PTD.
CONFERENCE ROOM	201	P.T.	Y	MARBLE	8"	——	——	WAL.	ST.	Y	A.T.	——	DO.	ST. & W.	——	DO.
TOILETS	203-204-239 243-257	CER.T.	——	C.G.T.	5"	——	——	G.T.	——	Y	GYP. P.	——	——	——	PTD.	DO.
STORAGE	205	TER.	——	C.G.T.	DO.	——	——	DO.	——	——	CON.	EX.	W	——	DO.	DO.
CLOTHING RMS.	206-262-280	CER.T.	——	DO.	DO.	——	——	DO.	——	Y	GYP. P.	——	——	——	DO.	DO.
SHOWER RMS.	207-251-269	DO.	——	DO.	DO.	CER.T. SHOWER	7'-0"	DO.	——	DO.	CEM. P.	——	——	——	DO.	DO.
PACK ROOM	208-288	DO.	——	DO.	DO.	——	——	DO.	——	DO.	GYP. P.	——	——	——	DO.	DO.
CONTINUOUS BATHS	209-286	DO.	——	DO.	DO.	CER.T. SHOWER	7'-0"	DO.	——	DO.	DO.	——	——	——	DO.	DO.
PASSAGE	210-287	DO.	——	DO.	DO.	——	——	DO.	——	DO.	DO.	——	——	——	DO.	DO.
JANITORS CLOSETS	2101-2418-287A	DO.	——	DO.	DO.	——	——	DO.	——	——	CON.	EX.	——	——	DO.	DO.
TOILETS	211-220-233 241-249-255	DO.	——	DO.	DO.	——	——	DO.	——	Y	GYP. P.	——	——	——	DO.	DO.
TOILETS	226-272-285	DO.	——	DO.	DO.	——	——	DO.	——	Y	GYP. P.	——	——	——	DO.	DO.
SINGLE RMS.	212-219 232-238	TER.	Y	DO.	DO.	——	——	DO.	——	PARTIAL	GYP. P. CON.	—— EX.	W	——	DO.	DO.
SINGLE RMS.	240-242 272-284	DO.	Y	DO.	DO.	——	——	DO.	——	DO.	GYP. P. CON.	EX.	DO.	——	DO.	DO.
DAYROOM	221-235-247 261-275	DO.	DO.	DO.	DO.	SEE NOTE BELOW		DO.	——	Y	A.T.	DO.	DO.	——	——	DO.
DIET KITCHEN	229-247	CER.T.	——	DO.	DO.	——	——	DO.	——	Y	GYP.	——	——	——	PTD.	DO.
LINEN	230-266-291	TER.	——	DO.	DO.	——	——	DO.	——	266, 250 ONLY	GYP. P. CON.	——	EX.	W	——	DO.	DO.
MOP ROOM	231-234-248 251-265	CER.T.	——	DO.	DO.	SEE DETAIL		DO.	——	——	CON.		EX.	——	——	DO.	DO.
WARDROBE	236-246-253 260	TER.	Y	DO.	DO.	——	——	DO.	——	Y	GYP. P.	——	W	——	DO.	DO.
SUPERVISOR STATION	238-258	DO.	Y	DO.	DO.	COUNTER		DO.	——	Y	A.T.	——	DO.	——	——	DO.
NURSES STATION	244	DO.	Y	DO.	DO.	COUNTER		DO.	——	DO.	DO.	——	DO.	——	——	DO.
DORMITORIES	252-259-262 256-264-270	DO.	Y	DO.	DO.	SEE NOTE BELOW		DO.	——	PARTIAL	GYP. P. CON.	—— EX.	DO.	——	PTD.	DO.
UTILITY ROOM	242-243A	CER.T.	——	DO.	DO.	——	——	DO.	——	Y	GYP.	——	——	——	DO.	DO.
EMER. TREATMENT ROOM	254	TER.	Y	DO.	DO.	——	——	DO.	——	Y	DO.	——	W	——	DO.	DO.
LOBBIES A_2 B_2 C_2	238A/244A-258A	DO.	DO.	DO.	DO.	SEE NOTE BELOW		DO.	——	Y	A.T.	——	DO.	——	——	DO.
CORRIDORS	As B_2 C_2 D_2 & E_2	DO.	DO.	DO.	DO.	——	——	DO.	——	Y	DO.	——	DO.	——	——	DO.
STAIRS	SEE NOTE BELOW A-C-D-E	DO.	PRECAST NONSLIP-SEE SPECS					DO.	——	——	CON.	EX.	——	——	PTD.	DO.
STAIRS	B-F	CON.	NONSLIP TREADS					DO.	——	——	DO.	DO.	H	——	DO.	DO.
PENTHOUSE																
STAIRS	A	CON.	NON-SLIP TREADS					G.T.	——	——	CON.	EX.	H	——	PTD.	PTD.
BLOWER RM.	301	DO.	——	——	——	——	——	EX.	——	——	DO.	DO.	H	——	——	DO.
MACHINE RM.	302	DO.	——	——	——	——	——	EX.	——	——	DO.	DO.	H	——	——	DO.

1 DAY ROOMS 221 · 235 · 247 · 261 · 275 SHALL HAVE COLOR G.T. BASE AND COLOR G.T. NORTH WALL.

2 ALL DORMITORIES - LOW PARTITIONS AND FREE STANDING COLUMNS TO HAVE COLOR G. T. BASE AND WALLS

3 LOBBIES 238A · 244A · 258A EXTERIOR WALLS OF NURSES STATIONS AND SUPERVISORS STATIONS SHALL HAVE COLOR G.T. BASE AND WALLS

4 STAIRS A·C·D·E 6' DIVIDING PARTITION SHALL BE COLOR G.T.

#8960

STATE ART COMMISSION
APR 10 1950
RECEIVED

STATE ART COMMISSION
APPROVED
FINAL
4-10-50

APPROVED
Commonwealth of Pennsylvania
DEPARTMENT OF LABOR
& INDUSTRY
By [illegible] Date 4-10-50

	AS BUILT 8/15/52	
	"	
	"	

THE GENERAL STATE AUTHORITY

APPROVED Oscar N. Lindahl
APPROVED J. F. Evans
APPROVED Eugene R. Stoppers
APPROVED [illegible] Dept. of Welfare
APPROVED Dept. of Property & Supplies
APPROVED Dept. of Health
ACCEPTED Contractor By
ACCEPTED Contractor By
ACCEPTED Contract'r By

PROJECT No. - G.S.A. [illegible]
THE PHILADELPHIA STATE HOSPITAL
PHILADELPHIA 16, PENNSYLVANIA

BUILDING N-8
SECOND FLOOR PLAN BLOCK "A" & ROOF PLAN

STOPPER & LICHTY · REGISTERED ARCHITECTS
2112 SPRUCE ST., PHILADELPHIA 3, PENNA.

JOB NO. 1121

1949 PROGRAM
DATE 4-10-50
SCALE AS NOTED

THE GENERAL STATE AUTHORITY
JAMES H. DUFF PRESIDENT
OSCAR N. LINDAHL EXEC. DIRECTOR
HARRISBURG, PENNSYLVANIA

SHEET NO. A6

CHECKED FOR G.S.A.
SUPV. ARCH. [illegible] ARCH. N.P.S. STRUCT. MECH. ELECT.