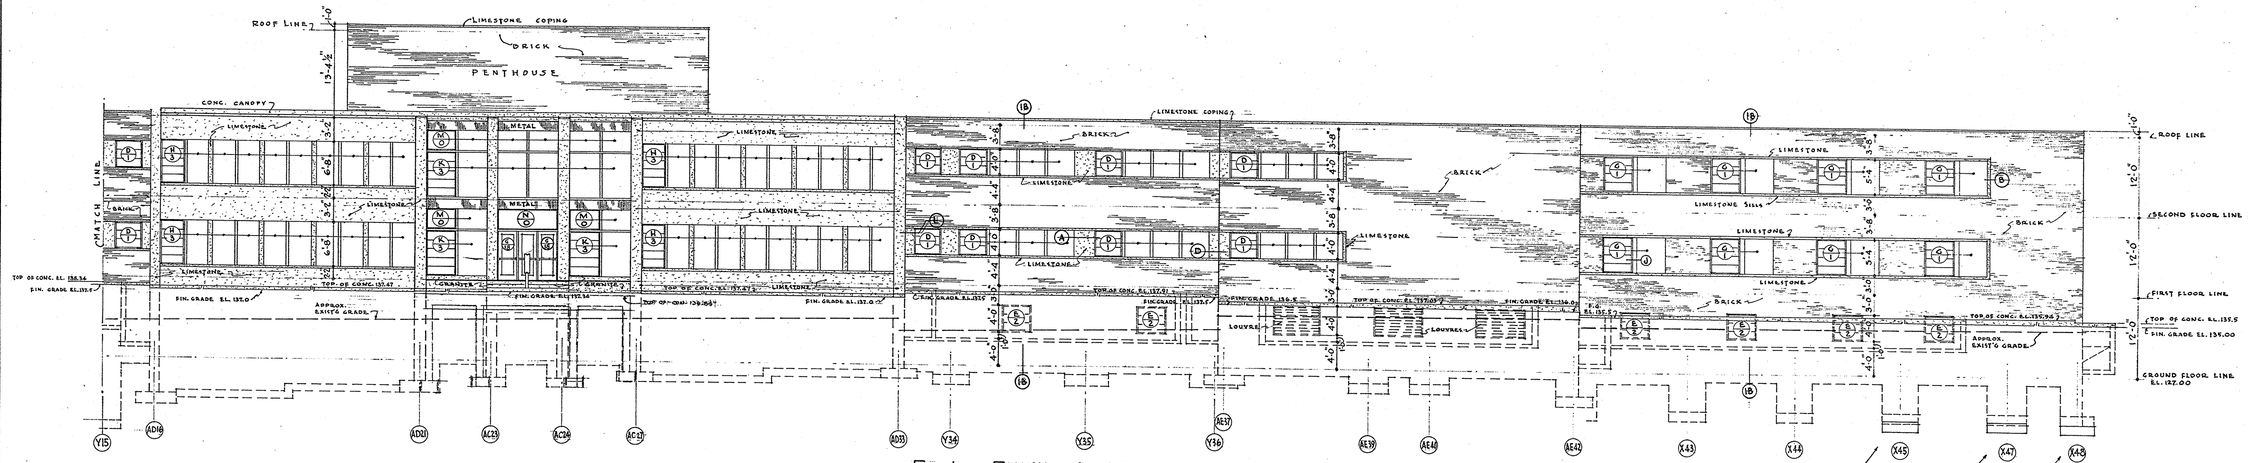

ELEVATION 1

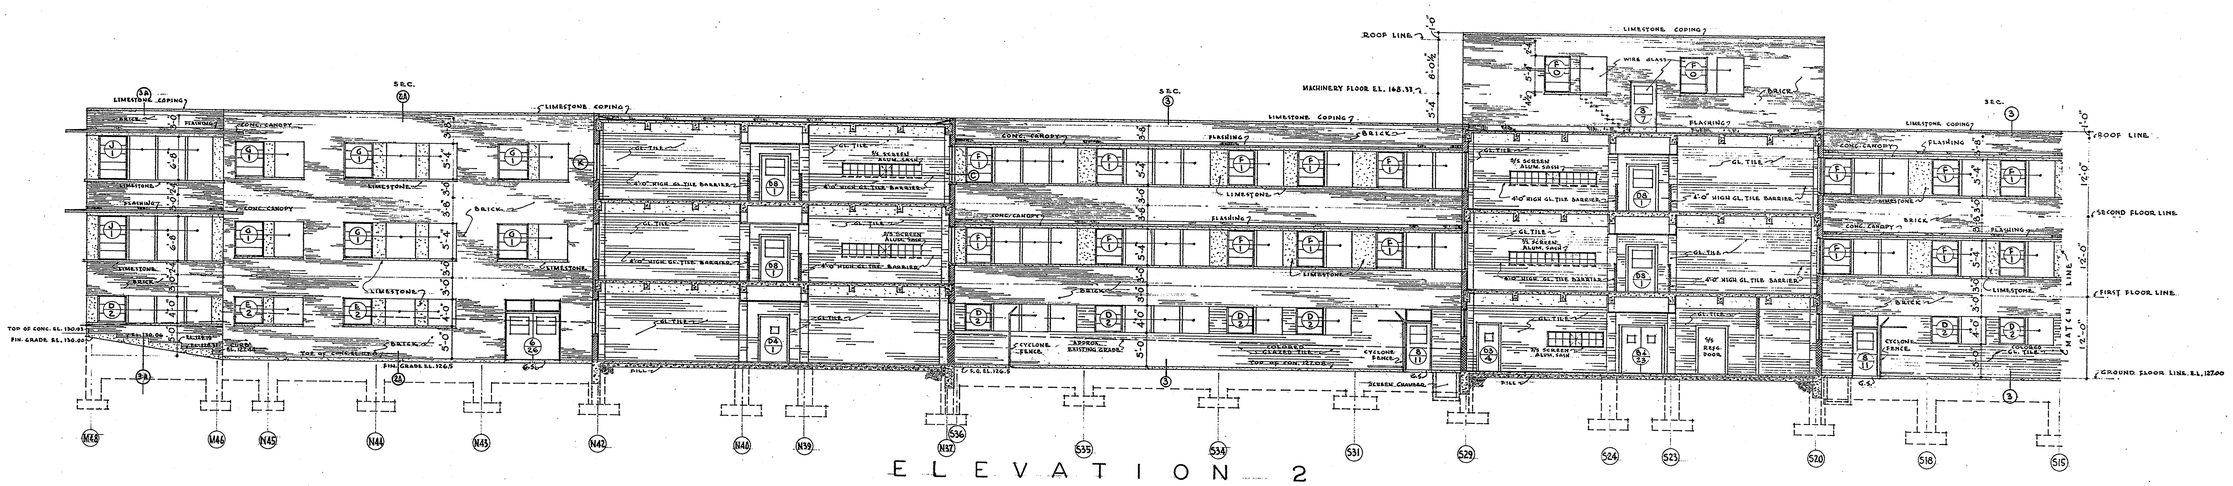

ELEVATION 2

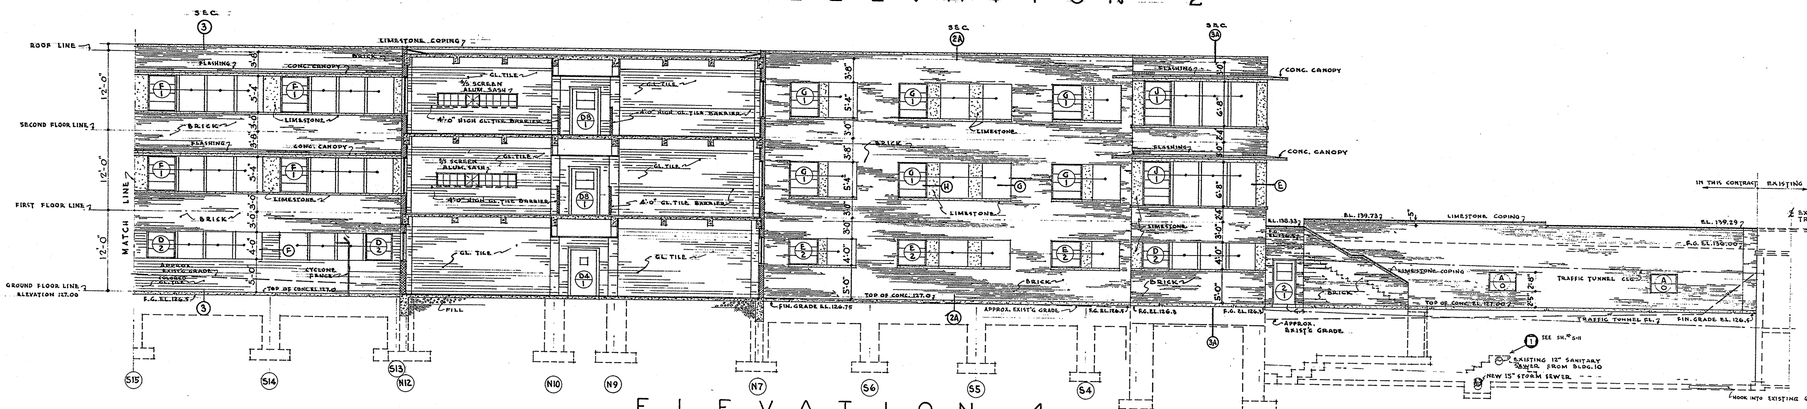

ELEVATION 4

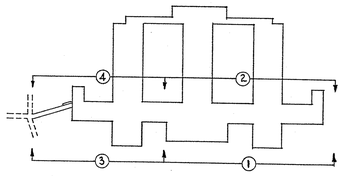

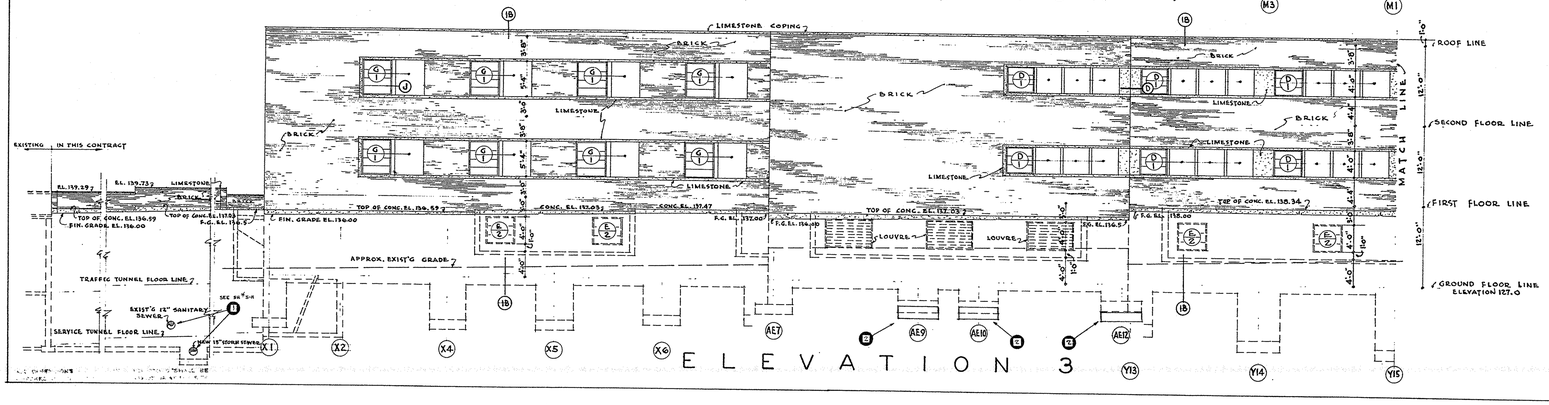

ELEVATION 3

#5960
STATE ART COMMISSION
APR 10 1950
RECEIVED

STATE ART COMMISSION
APPROVED
FINAL
4-10-50

APPROVED
Commonwealth of Pennsylvania
DEPARTMENT OF WELFARE
Engr. Date
Engineer K. Stoffer
Expires Stoffer

REVISED	
1	As built 8/14/52
2	"

THE GENERAL STATE AUTHORITY	
APPROVED	Oscar M. Lindahl — Exec. Director
APPROVED	James H. Duff — President
APPROVED	Edward Stifter — Architect Engineer
APPROVED	Dept. of Welfare — 4-14-50
APPROVED	Dept. of Property & Supplies
ACCEPTED	Dept. of Health
ACCEPTED	Contractor — By
ACCEPTED	Contractor — By
ACCEPTED	Contractor — By

PROJECT No. - G.S.A. - 510.2

THE PHILADELPHIA STATE HOSPITAL
PHILADELPHIA 18, PENNSYLVANIA

BUILDING N-8
ELEVATIONS 1-2-3-4

STOFFER & LICHTY - REGISTERED ARCHITECTS
2118 SPRUCE ST., PHILADELPHIA 3, PENNA.

1949	THE GENERAL STATE AUTHORITY	
PROGRAM DATE 4-10-50	JAMES H. DUFF, PRESIDENT; OSCAR M. LINDAHL, EXEC. DIRECTOR	SHEET A8
SCALE 1/8"=1'-0"	HARRISBURG, PENNSYLVANIA	

CHECKED FOR G.S.A.
EL/PV. ARCH. ECO 7/1/50 | ARCH. M-E-B | STRUCT. | MECH. | ELEC.