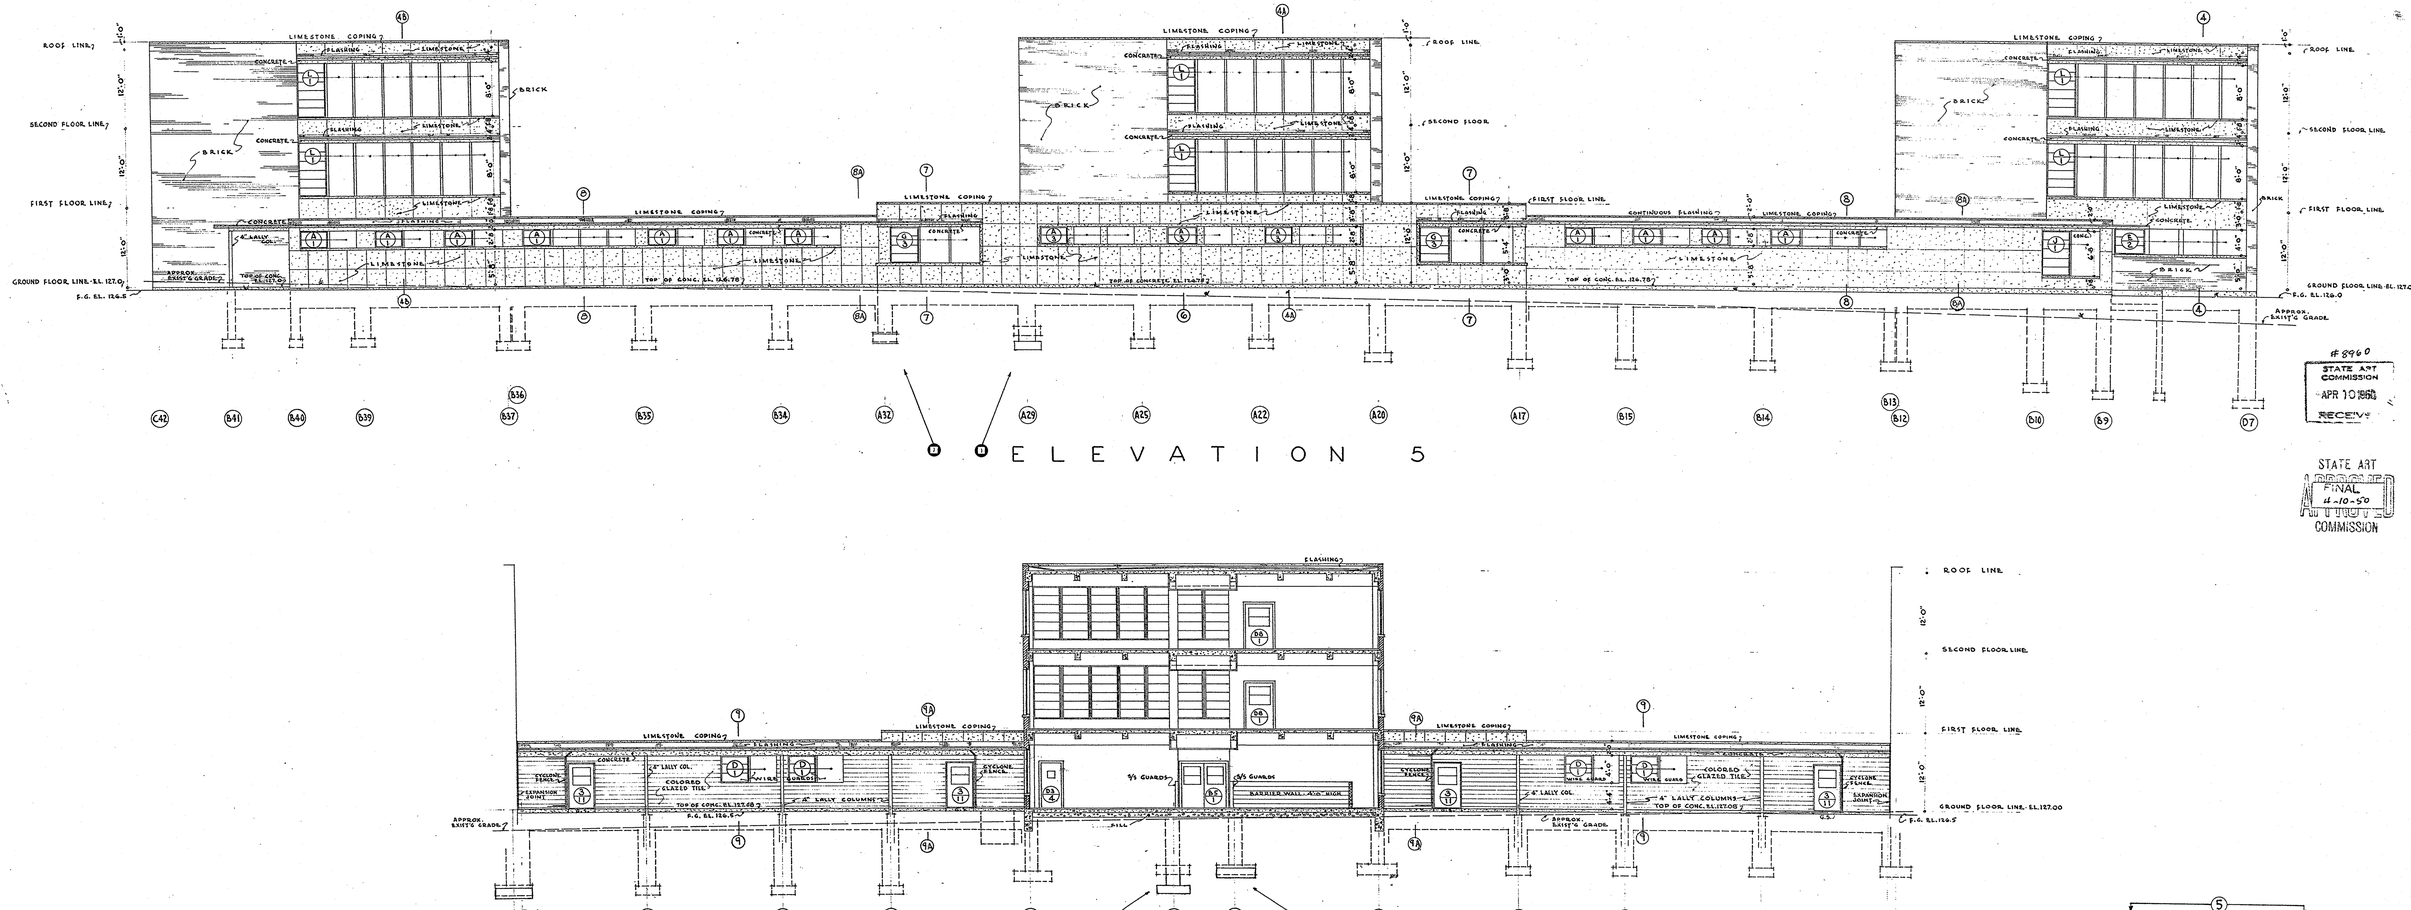

ELEVATION 5

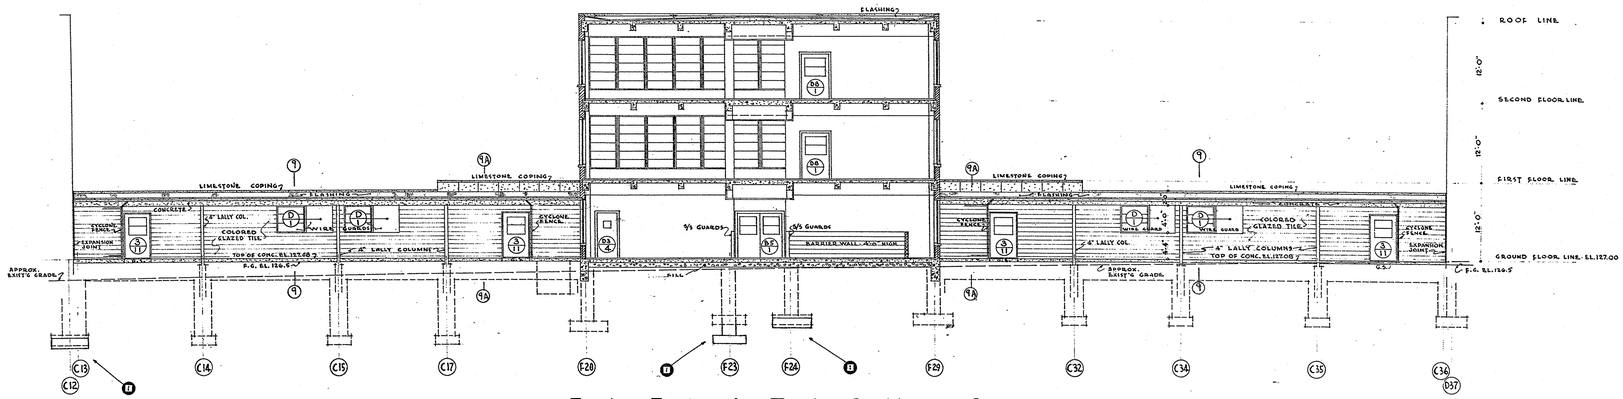

ELEVATION 6

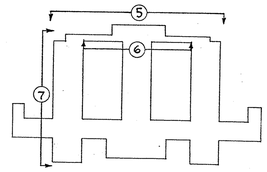

KEY PLAN

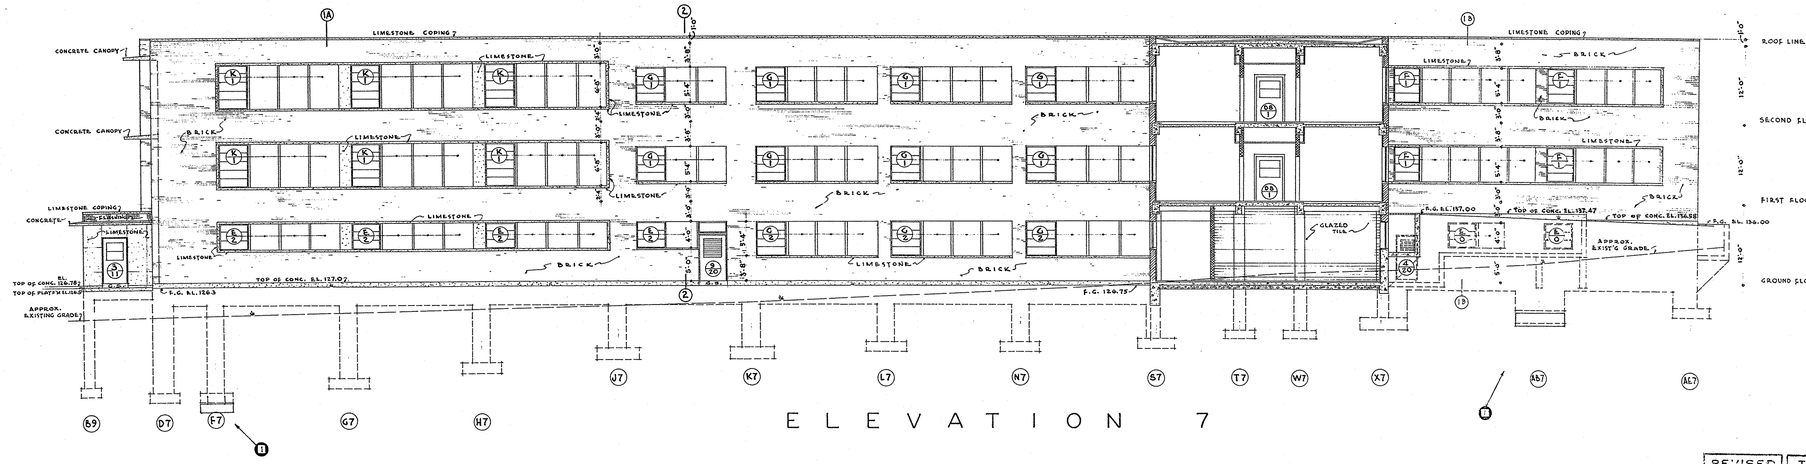

ELEVATION 7

#8960
STATE ART COMMISSION
APR 10 1950
RECEIVED

STATE ART COMMISSION
APPROVED
FINAL
4-10-50

APPROVED
Commonwealth of Pennsylvania
DEPARTMENT OF WELFARE
Arch. [signature] Date 4/5/50

STATE ART COMMISSION
APPROVED
4-10-50
PENNSYLVANIA

REVISED	THE GENERAL STATE AUTHORITY	PROJECT No. · G.S.A. - 510-2
0 AS BUILT 11/15/52	APPROVED [signature] DIRECTOR	THE PHILADELPHIA STATE HOSPITAL
	APPROVED [signature]	PHILADELPHIA 31, PENNSYLVANIA
	APPROVED [signature] CHIEF ENGINEER	BUILDING N-8
	APPROVED [signature] TRUST OF WELFARE	ELEVATIONS 5 - 6 - 7
	APPROVED DEPT. OF PROPERTY & SUPPLIES	STOPPER & LICHTY REGISTERED ARCHITECTS 2112 SPRUCE ST., PHILADELPHIA 3, PENNA. COMM. NO. 1131
	APPROVED DEPT. OF HEALTH	1949 PROGRAM DATE 4-10-50 SCALE 1/8" = 1'-0"
	ACCEPTED CONTRACTOR BY	THE GENERAL STATE AUTHORITY SHEET NO. A9
	ACCEPTED CONTRACTOR BY	JAMES N. DUFF PRESIDENT
	ACCEPTED CONTRACTOR BY	OSCAR N. LINDAHL EXEC. DIRECTOR
		HARRISBURG, PENNSYLVANIA
		CHECKED FOR G.S.A. SUPV. ARCH. [signature] ARCH. H.B.S. STRUCT. MECH. ELECT.